
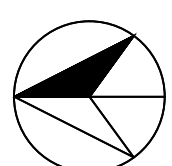


SUITE #5D

TOTAL - 1,778 SQ. FT.
 OFFICE - 639 SQ. FT.
 WAREHOUSE - 1,139 SQ.FT.

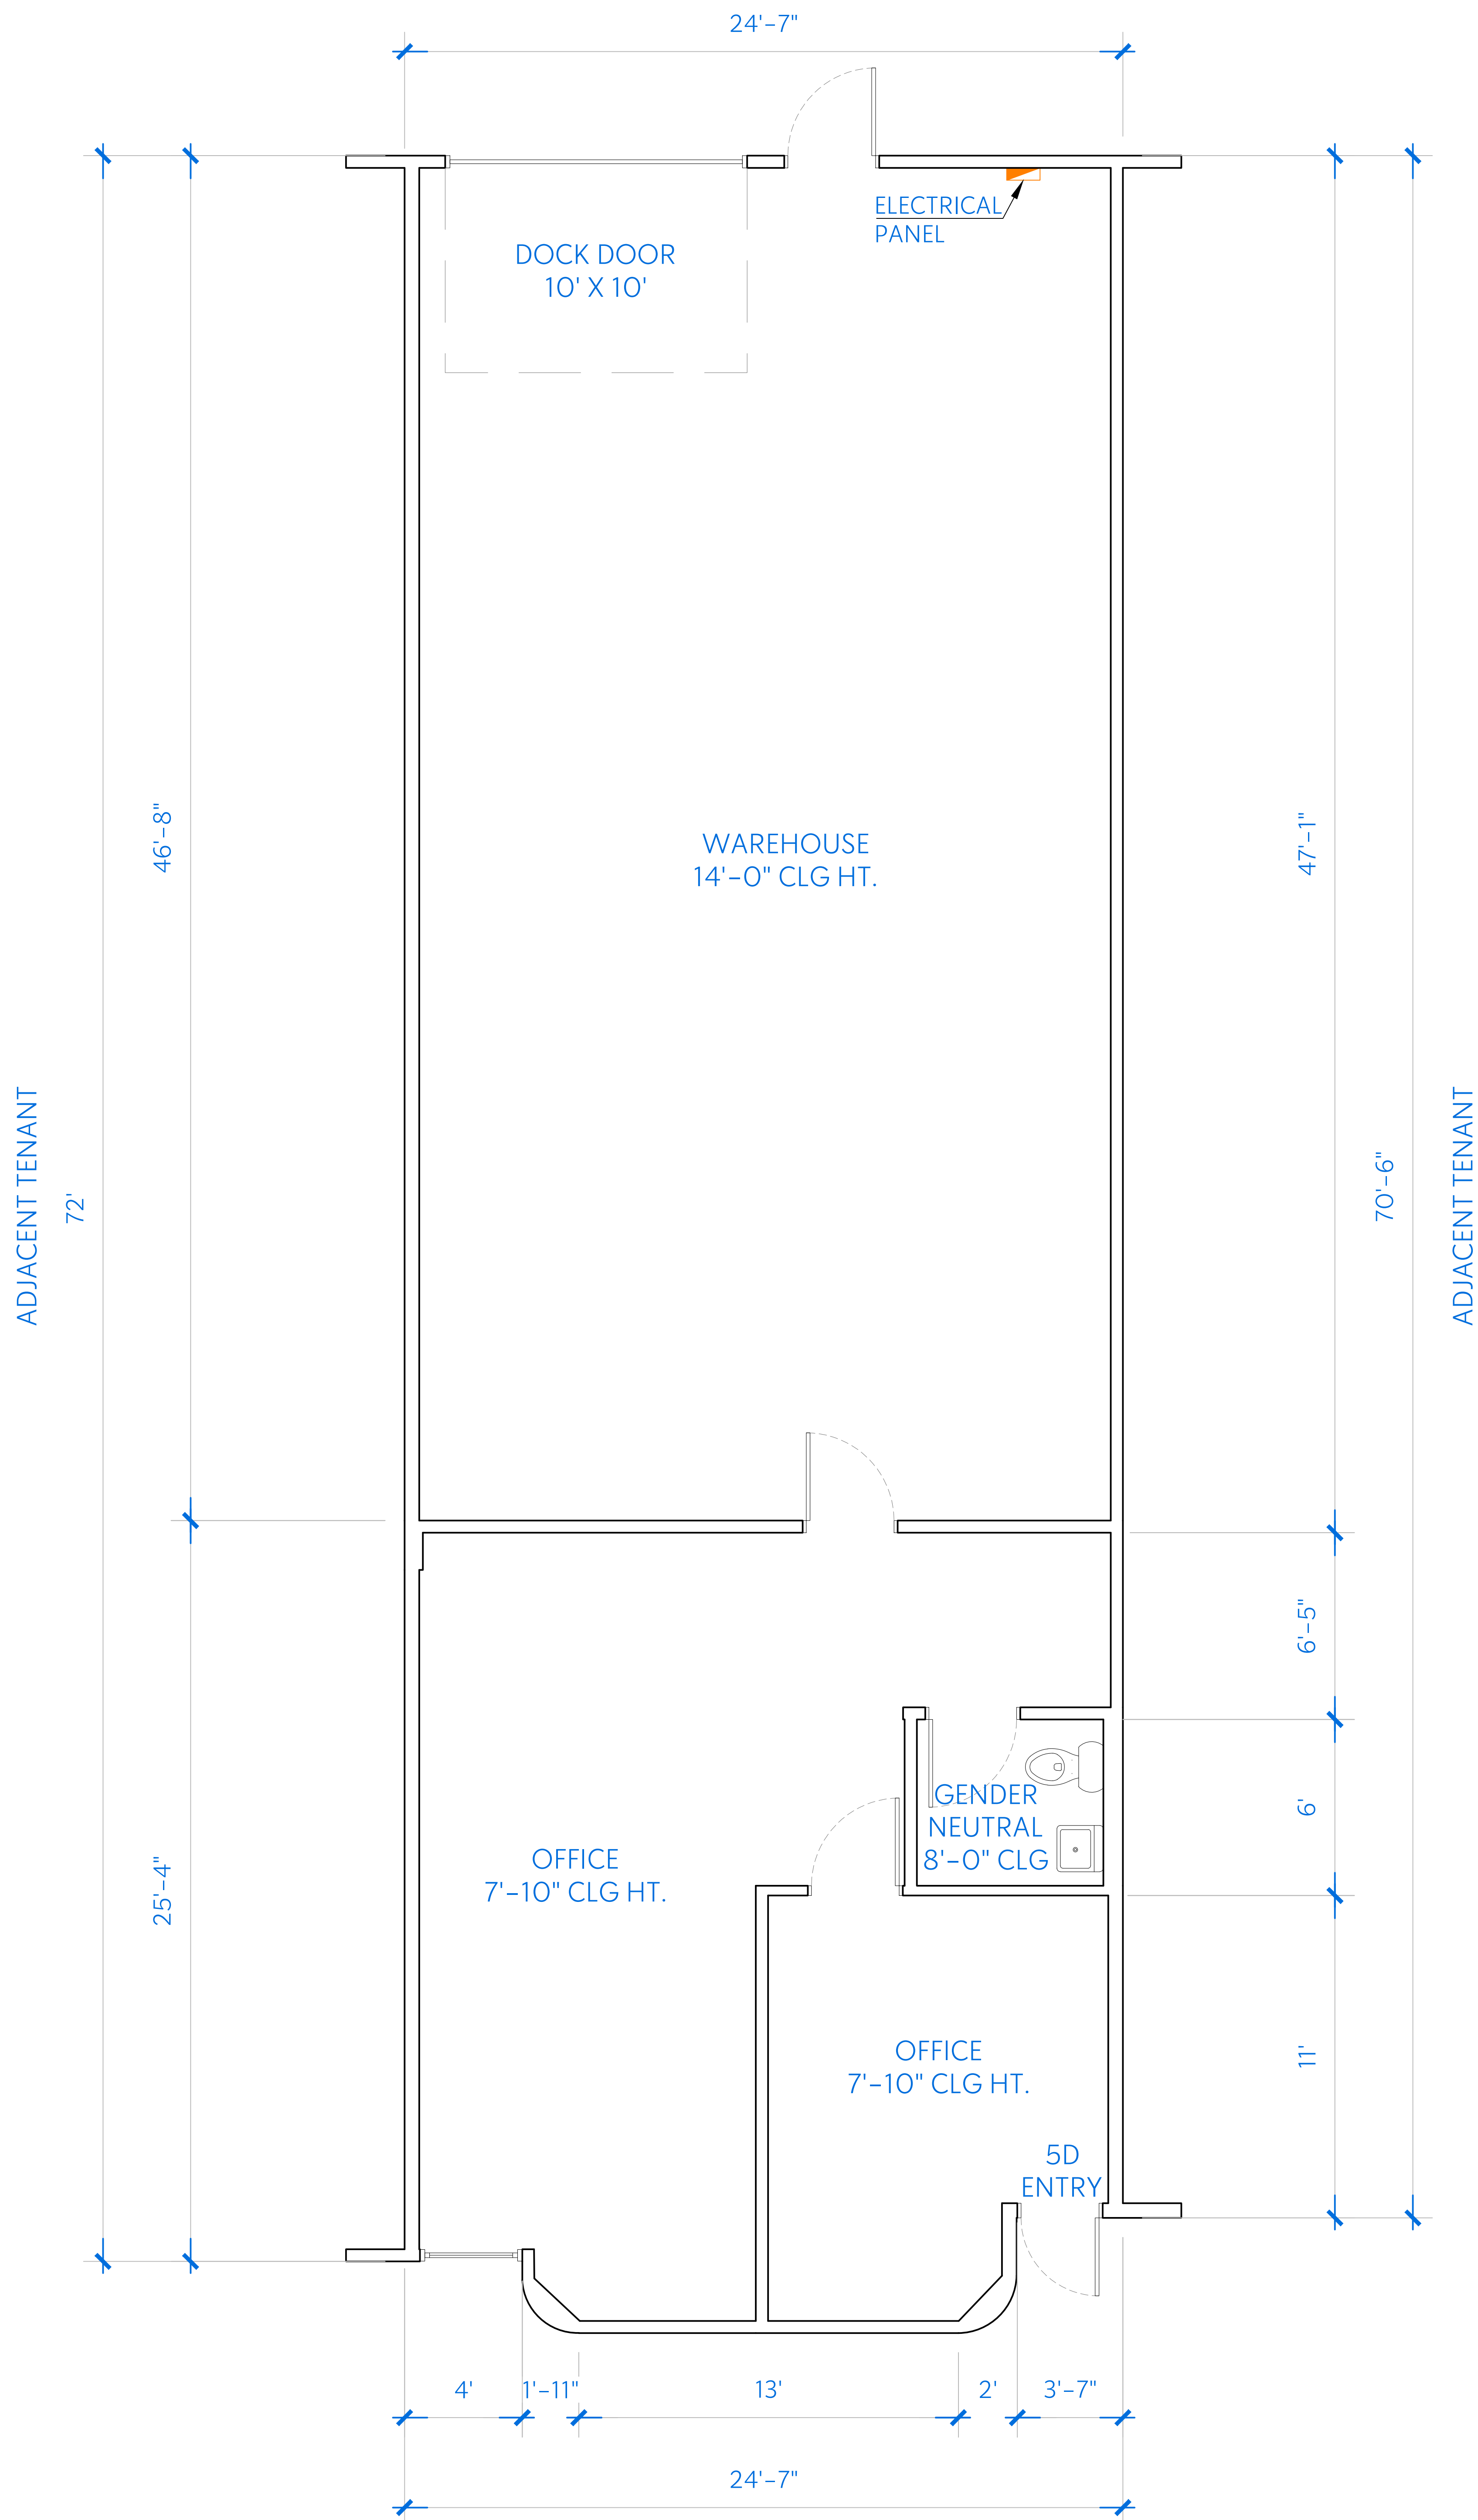

**GEORGE
URBAN
ADVISORS**

14747 ARTESIA BLVD,
LA MIRADA, CA 90638

AS-BUILT
COMPANY

DRAWN BY: J.C.
DATE: 4/21/25
APN: ...
SCALE: CUSTOM
PAGE SIZE: ARCH D (36.00 X 24.00 INCHES)