

FOR REVIEW ONLY
NOT FOR REGULATORY
APPROVAL, PERMIT OR
CONSTRUCTION

NEI DEVELOPMENT
202 W. CENTER ST.
DUNCANVILLE, TX 75116

PROJECT NO. 2024.311

REV	DESCRIPTION	DATE

ISSUE

AS-BUILT SURVEY

ISSUE DATE

OCTOBER 21, 2024

FLOOR PLAN - EXISTING


A111

PLAN NOTES:

1. AS-BUILT SURVEY PERFORMED BY NSBRANCH ARCHITECTS ON FRIDAY OCTOBER 18, 2024
2. ALL DIMENSIONS ARE SHOWN FROM FACE OF FINISH TO FACE OF FINISH
3. CONTRACTOR TO FIELD VERIFY EXISTING DIMENSIONS AND CONDITIONS PRIOR TO CONSTRUCTION

KEYED NOTES:

- 1 EXISTING DOOR WITH PANIC HARDWARE
- 2 CONCRETE STEPS WITH METAL GUARDRAIL
- 3 EXISTING MAIN DISTRIBUTION PANEL WITH 2 ELECTRICAL PANEL BOXES

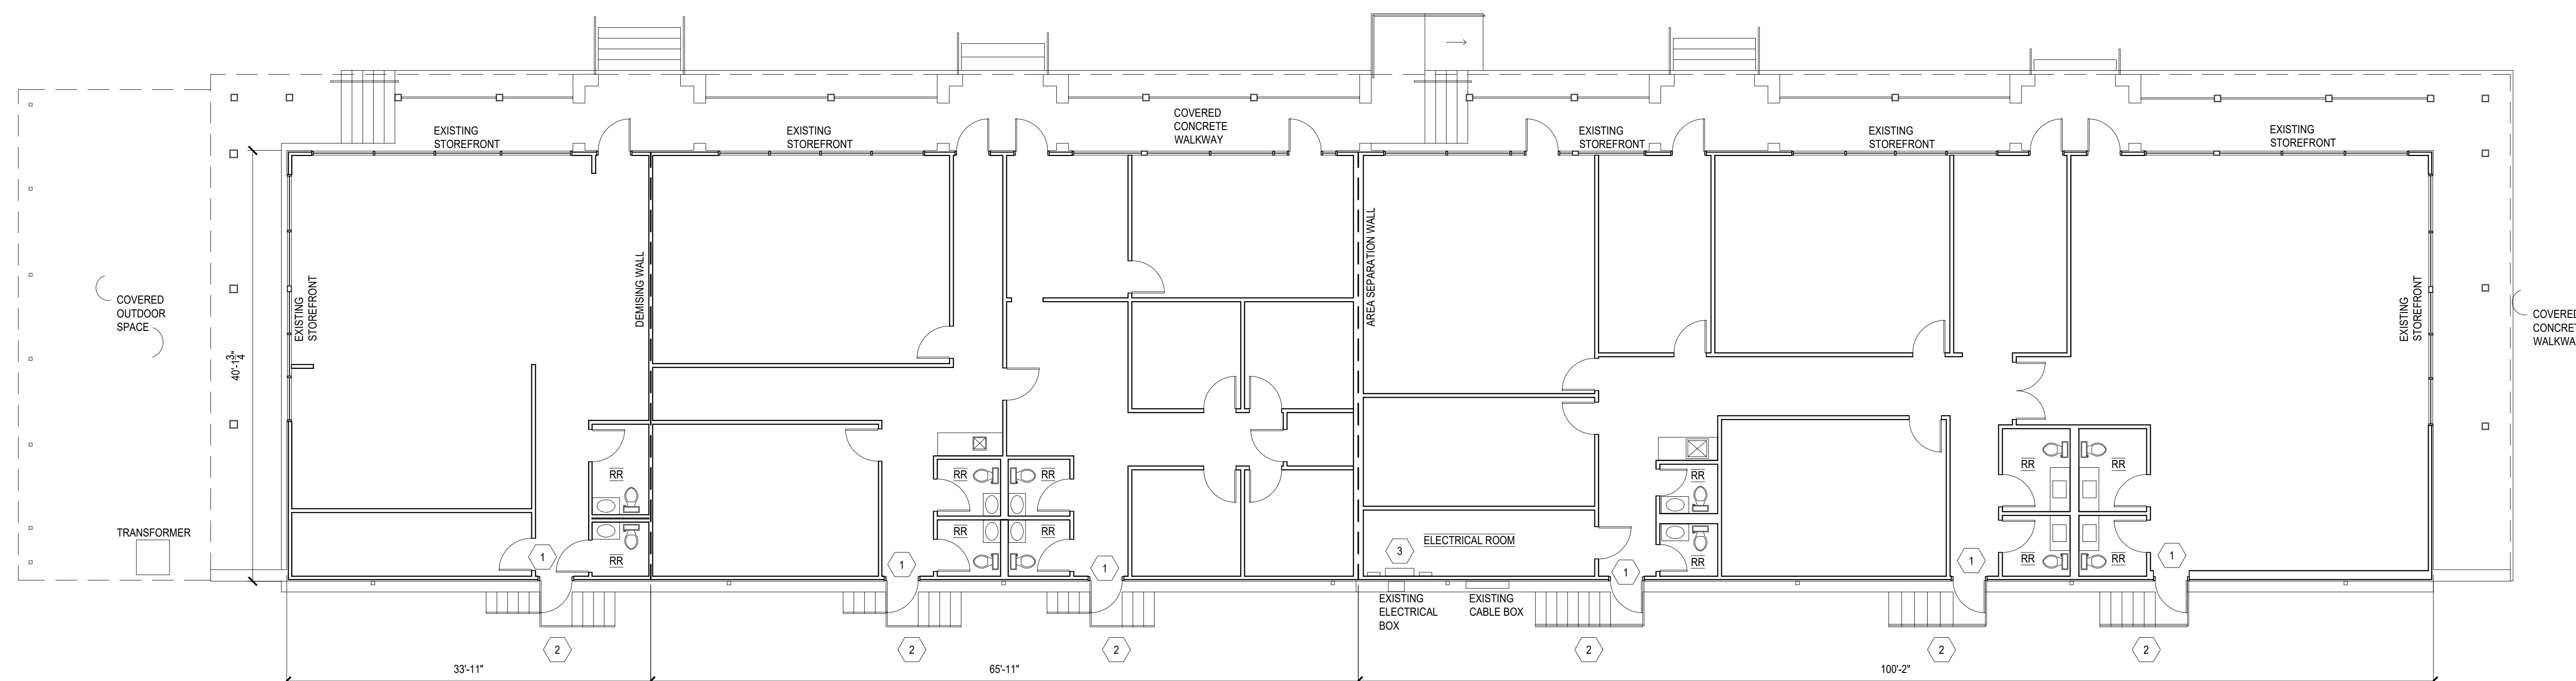

1 FLOOR PLAN - EXISTING

SCALE: 1/8" = 1'-0"

