



SUBLEASE AVAILABLE



**CUSHMAN &
WAKEFIELD**

PREMIER BORO TOWER SUBLEASE

8350 Broad Street Tysons, VA

**Suite 350
5,890 SF**

HIGHLIGHTS

This high-end, fully furnished, open-plan corner office space offers an unparalleled work environment designed to inspire productivity and innovation.

Located in the heart of Tysons, Boro Tower provides breathtaking panoramic views, state-of-the-art amenities, and seamless access to premier dining, shopping, and entertainment options.

LAURIE MCMAHON
Executive Vice Chairman
+1 202 266 1185
laurie.mcmahon@cushwake.com


2101 L Street, NW
Suite 500
Washington DC 20037
Main +1 202 463 2100
cushmanwakefield.com

BORO TOWER SUBLEASE

8350 Broad Street Tysons, VA

Suite 350 - 5,890SF

AS-BUILT PLAN

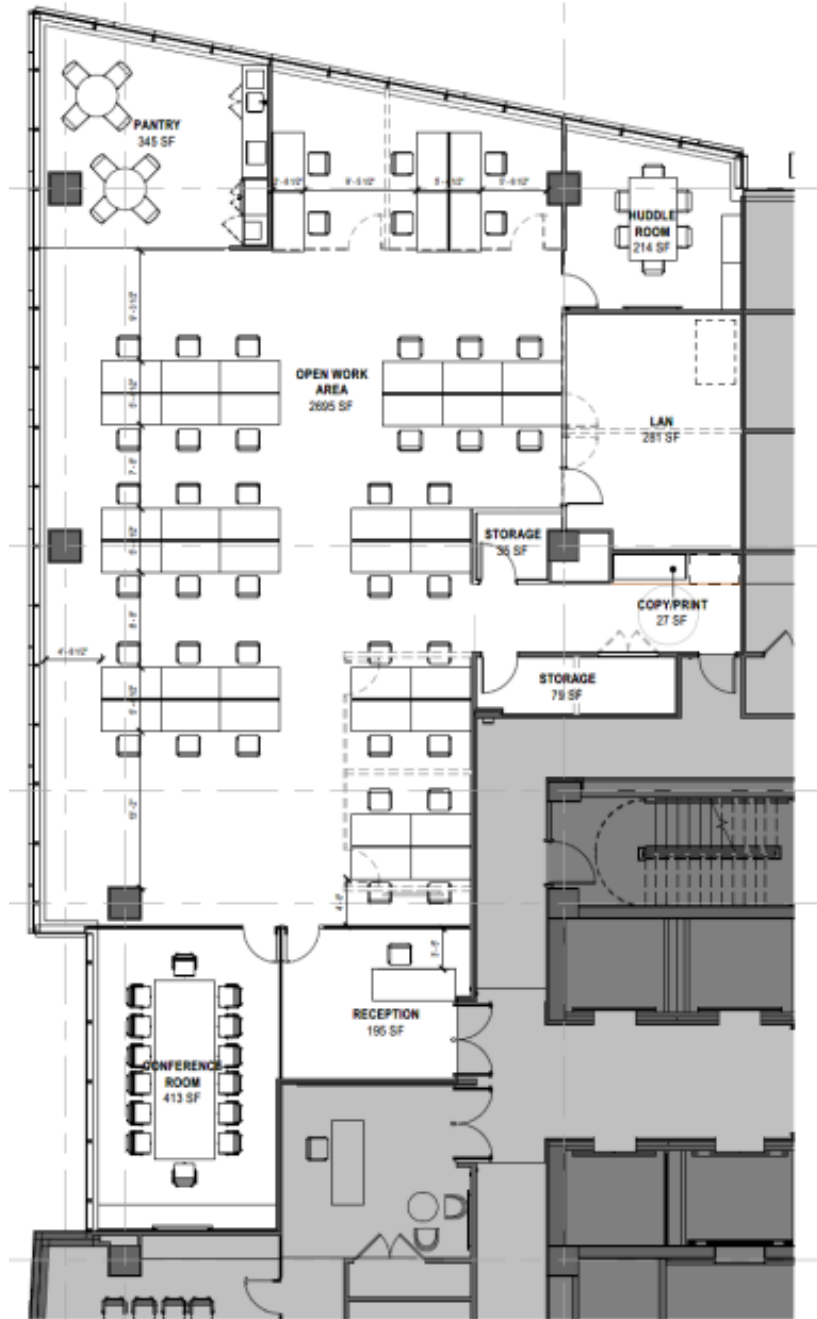

LAURIE MCMAHON

Executive Vice Chair

+1 202 266 1185

laurie.mcmahon@cushwake.com