



Property Key

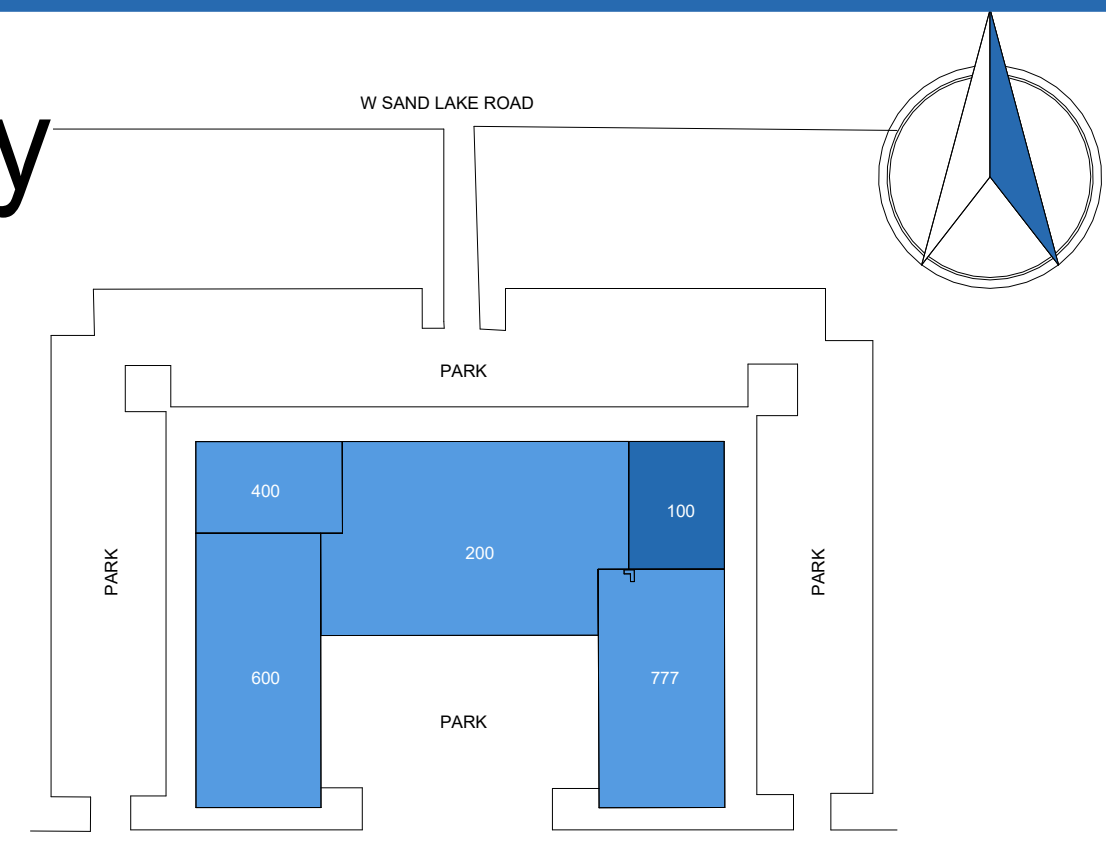

Sand Lake As Built Marketing Package

2400 Sand Lake Rd, Orlando, FL 32809, US

Building: 2400
Suite: 100
Sheet **E1**

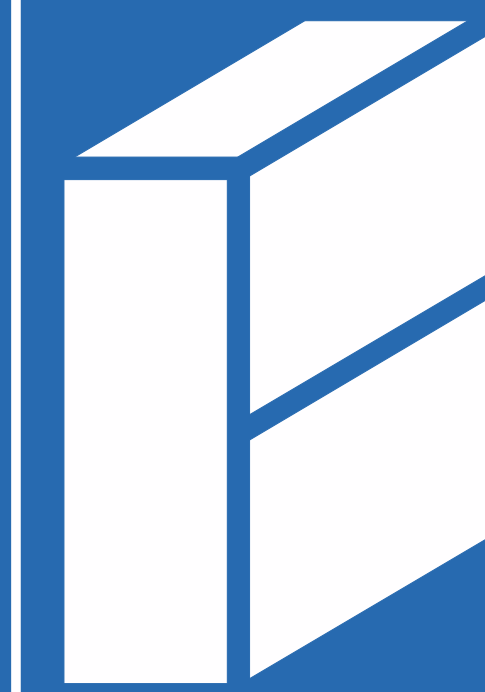

BAY SPACE


Scale: Not to Scale
Sheet Size: 42" x 30"
Not For Construction

Usable Square Foot Analysis

Office Area	3,787	100 %
Warehouse Area	0	0%
Total Area	3,787	

Building Information

Deck Height:	17' - 3 1/2"
Clear Height:	8' - 11"
Ceiling Height:	8' - 11"
Sprinklered:	<input checked="" type="checkbox"/> Yes <input type="checkbox"/> No
Mechanical Area:	37 SQFT

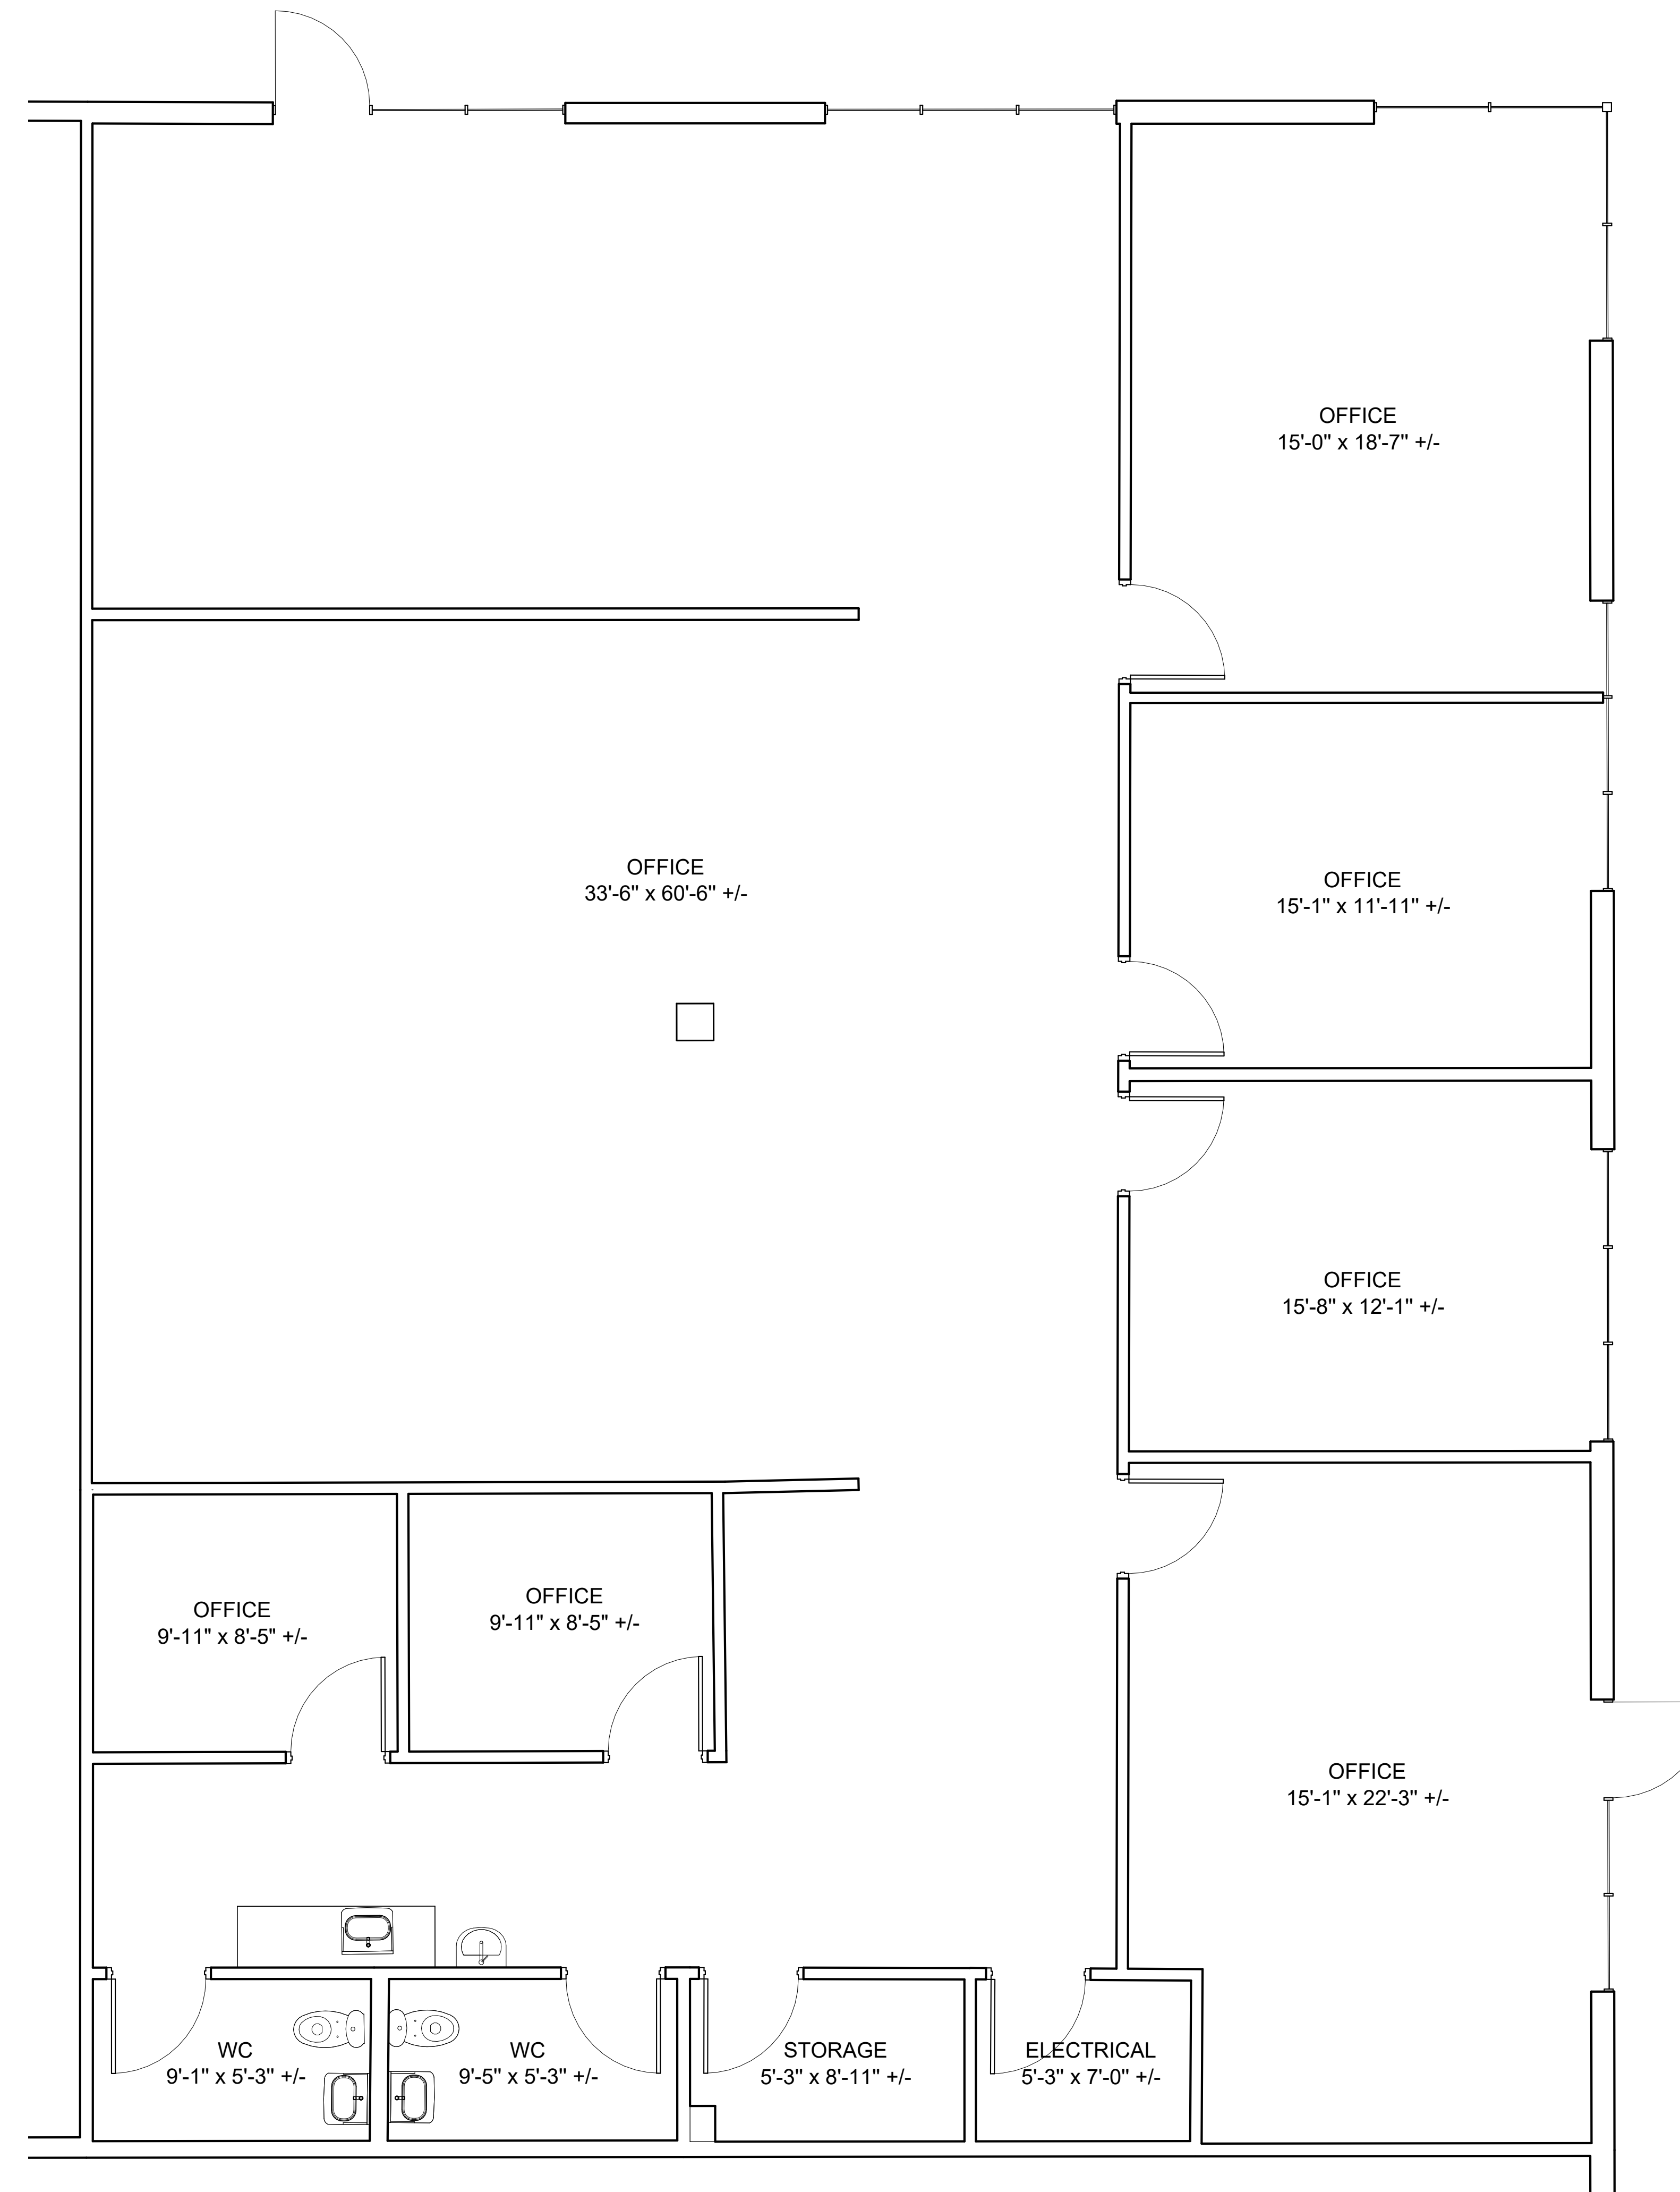

100
1:40

As Built Floor Plan for Marketing

