


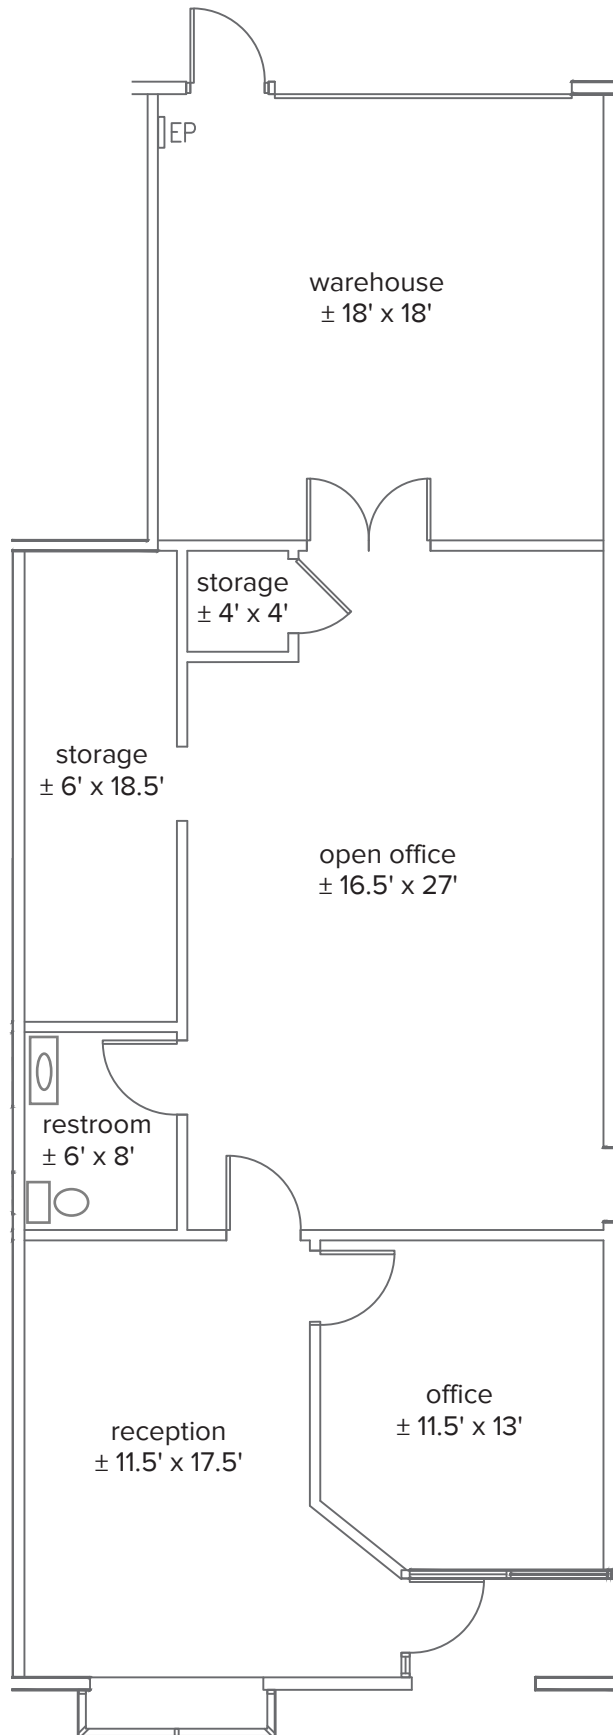

Suite T

Sorrento Mesa Business Center
9823 Pacific Heights Boulevard
San Diego, CA 92121

AS-BUILT PLAN

November 25, 2025
Scaled to Fit
1,484 RSF