



S. M. H. Citations Street, South Side
Baltimore, Maryland 21205
P 410.758.2700
F 410.752.2752
e-mail: smith@citigroup.com

PROJECT
TITLE:

VICKERS EXCHANGE

**231 E. REDWOOD STREET
BALTIMORE, MD 21201**

AS-BUILT - 1ST FLOOR


DATE: _____


4/7/2021 SCALE:

$1/8'' = 1'-0''$ PROJ. #:

20036

AB-1

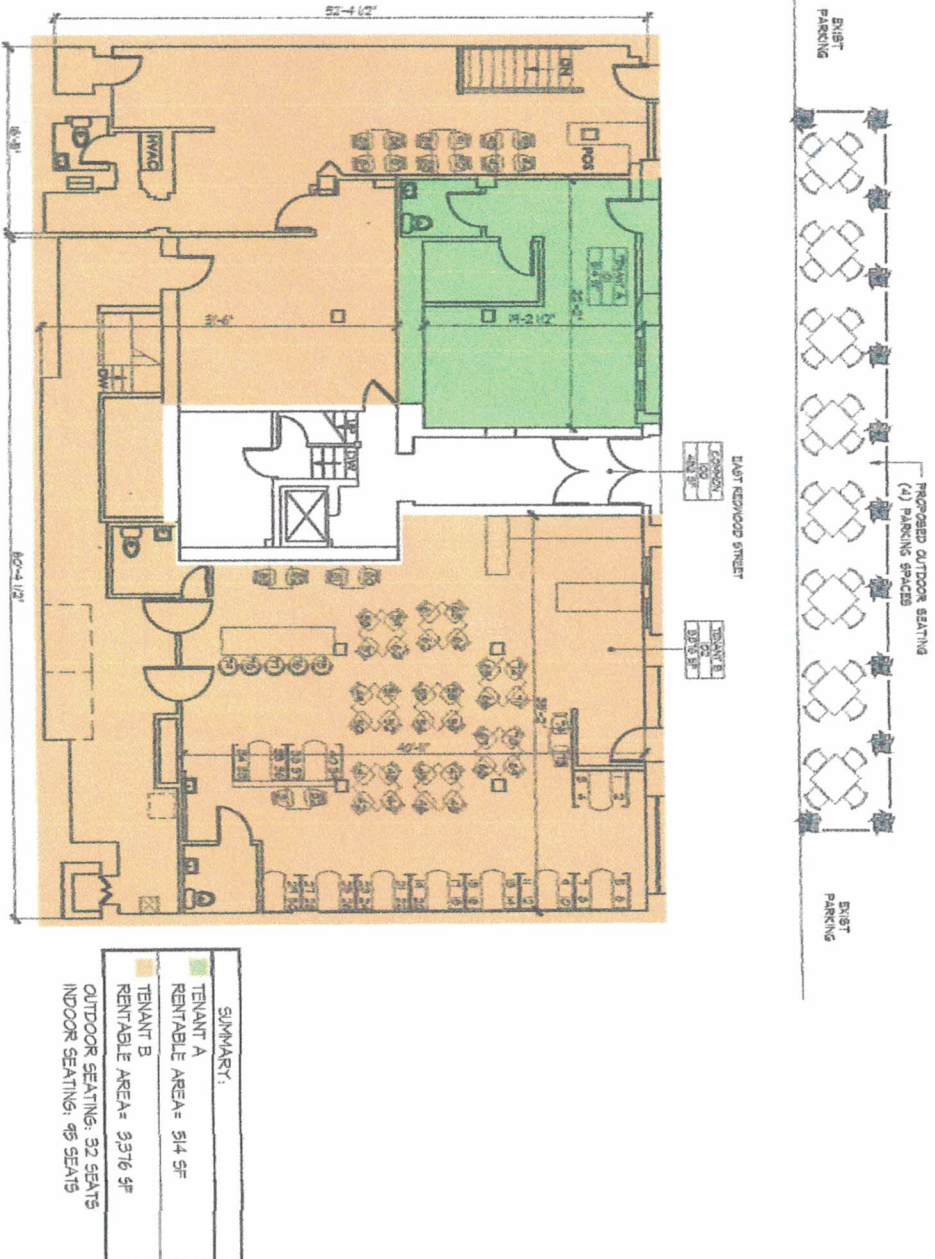

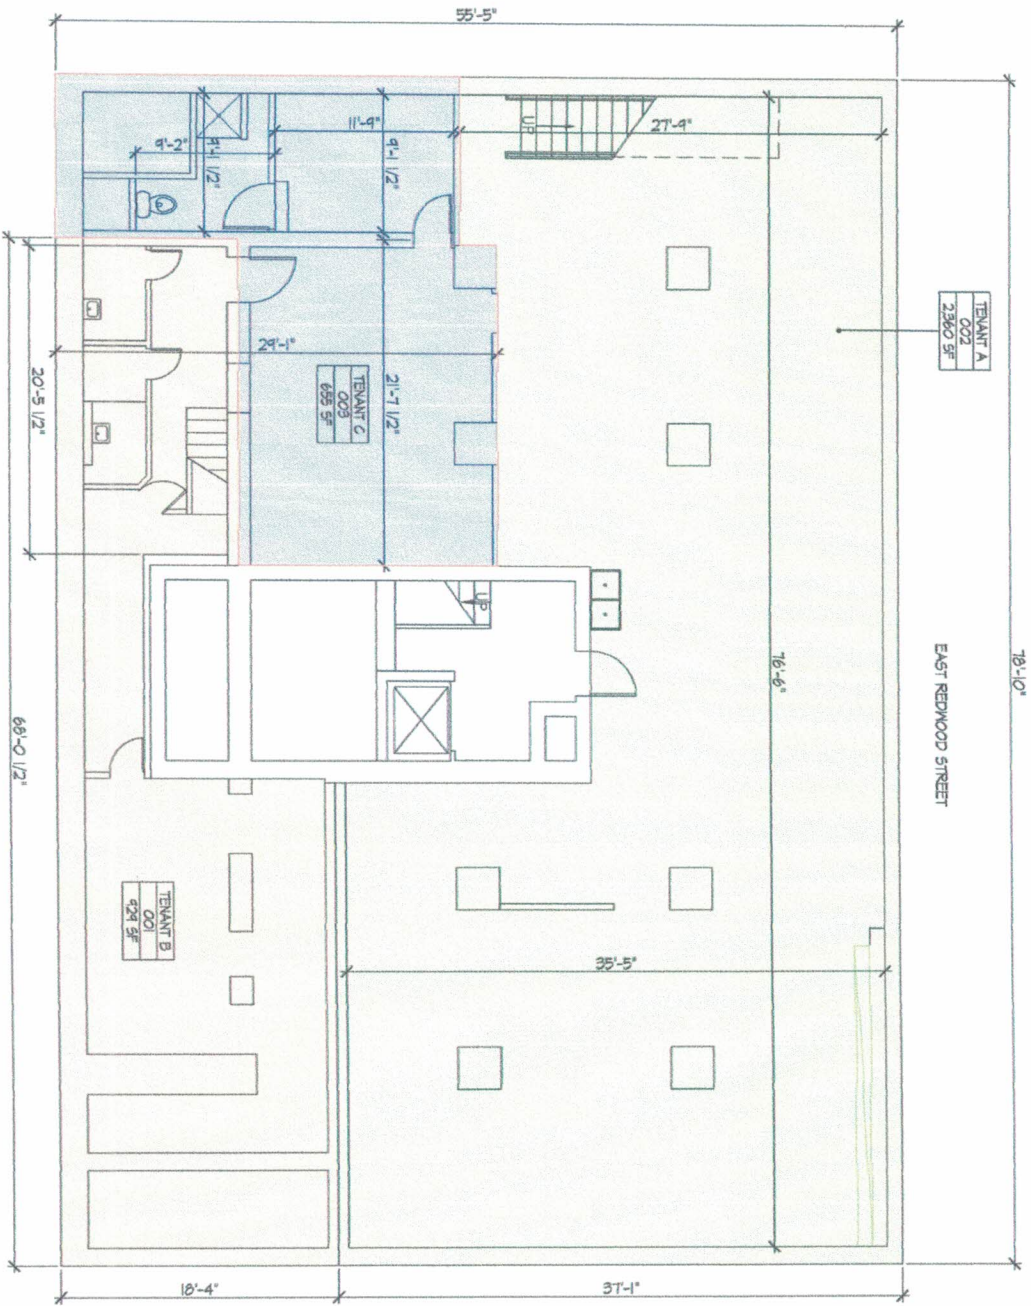

SUMMARY:	
☐	TENANT A
☐	RENTABLE AREA= 2360 SF
☐	TENANT B
☐	RENTABLE AREA= 424 SF
☐	TENANT C
☐	RENTABLE AREA= 655 SF