


Property Key

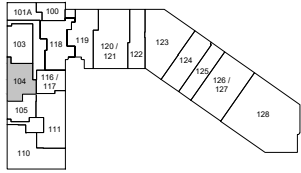

Cross Bayou As Built Marketing Package

11701 Belcher Road, Largo, FL 33773

Building: 11701

Suite: 104

Sheet: A-4




BAY SPACE

Scale: Not to Scale
Sheet Size: 8.5" x 11"
Not For Construction

Total Area - 2,498 SF

Building Information

DECK HEIGHT:	N/A
CEILING HEIGHT:	8'-11"
CLEAR HEIGHT:	8'-11"
SPRINKLERED:	Yes

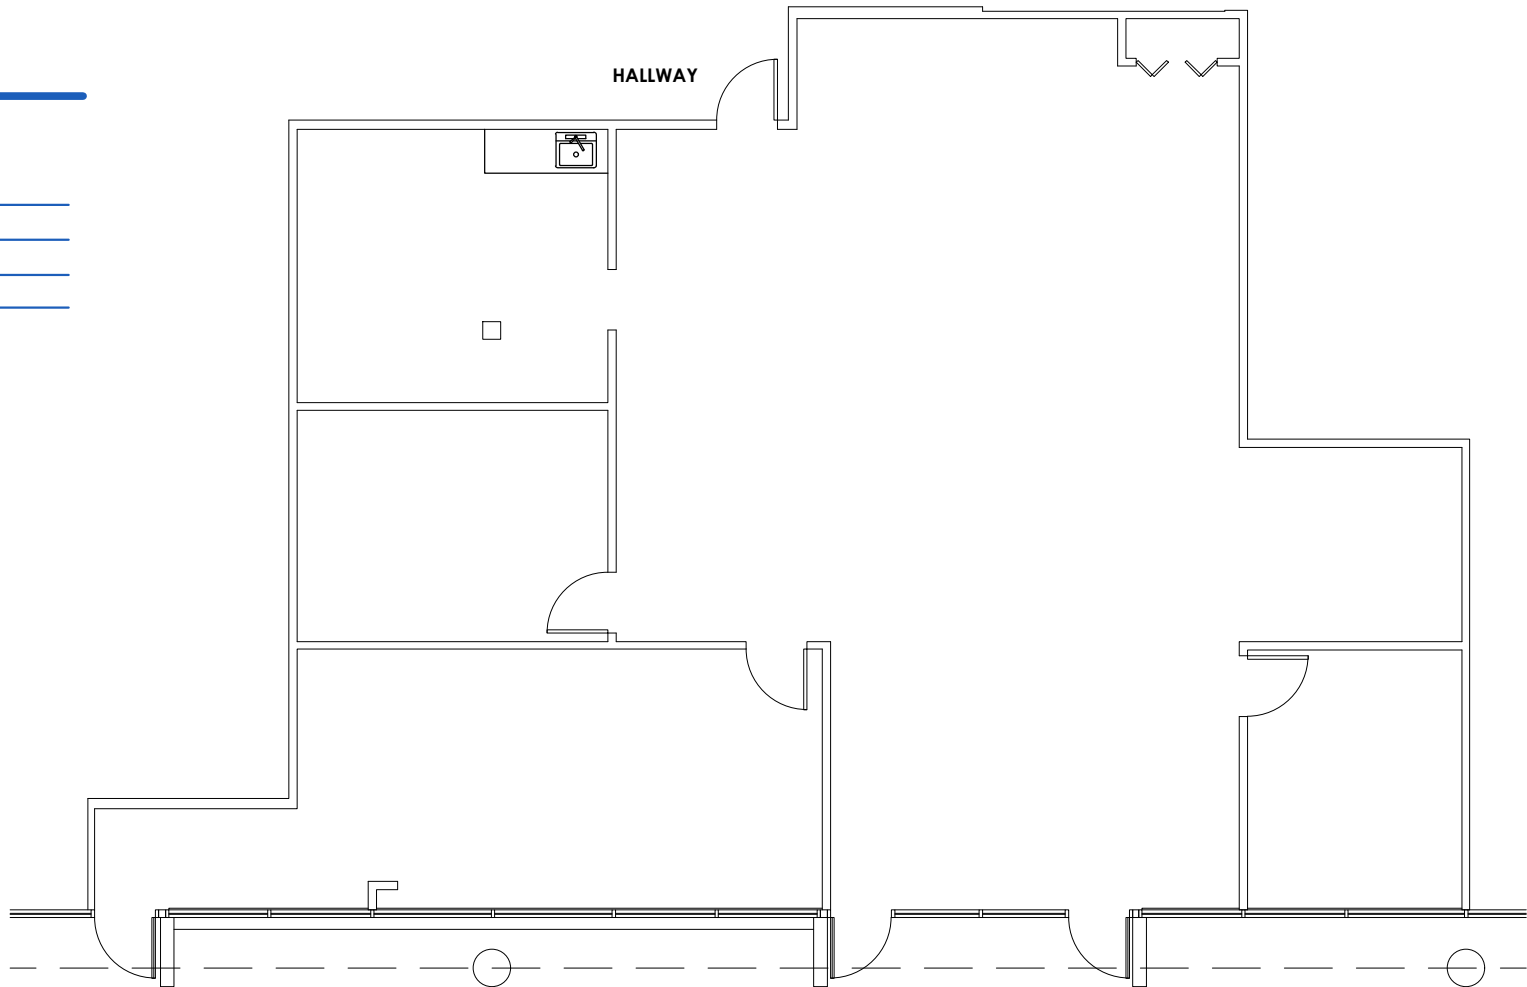

As Built Floor Plan for Marketing