

Property Key



Bryan Dairy As Built Marketing Package

7201 - 7281 Bryan Dairy Road, Largo, FL 33777




BAY SPACE

Building: East Building

Suite: 7243

Sheet: A-13


Scale: Not to Scale
Sheet Size: 8.5" x 11"
Not For Construction

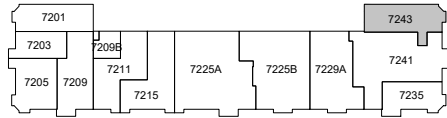

Total Area - 2,663 SF

Building Information

DECK HEIGHT:	12'-9"
CEILING HEIGHT:	8'-10"
CLEAR HEIGHT:	12'-0"
SPRINKLERED:	Yes

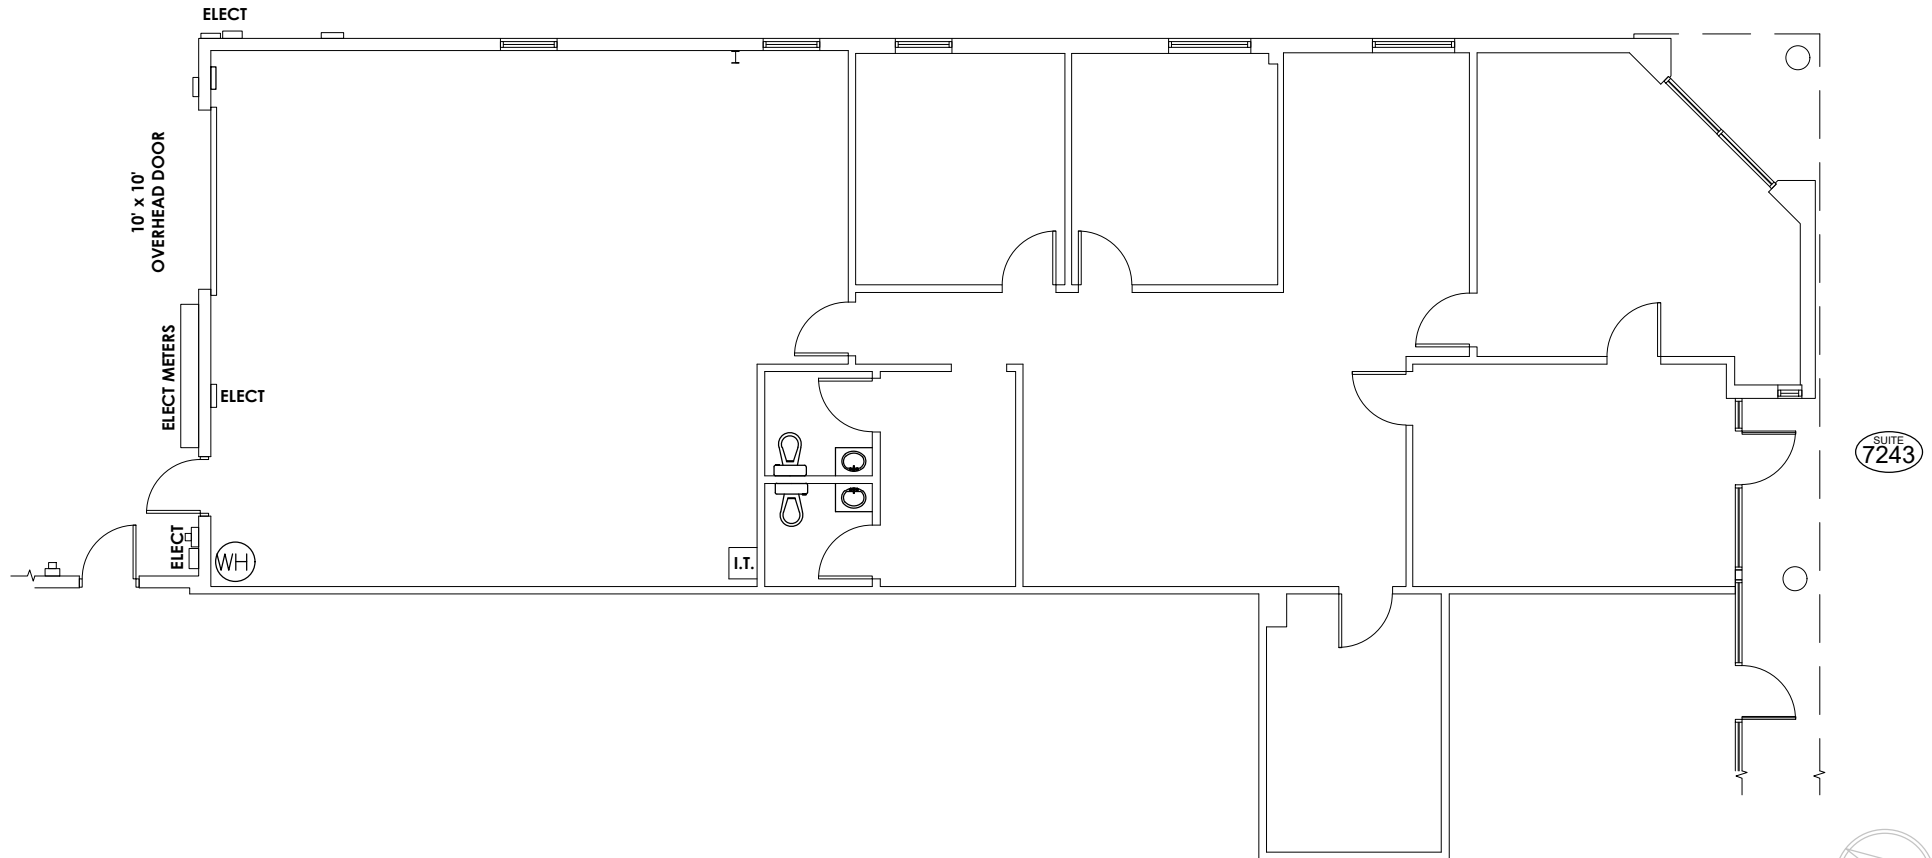

As Built Floor Plan for Marketing

