


Property Key

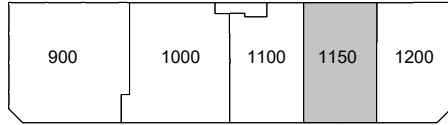

WMGSA Roosevelt As Built Marketing Package

10901-11001 Roosevelt Boulevard and 1000 112th Circle, St. Petersburg, FL 33716

Building: 10901

Suite: 2C-1150

Sheet: A-4

Scale: Not to Scale
Sheet Size: 8.5" x 11"
Not For Construction




BAY SPACE

Total Area - 4,093 SF

Building Information

DECK HEIGHT:	N/A
CEILING HEIGHT:	8'-7"
CLEAR HEIGHT:	8'-7"
SPRINKLERED:	No

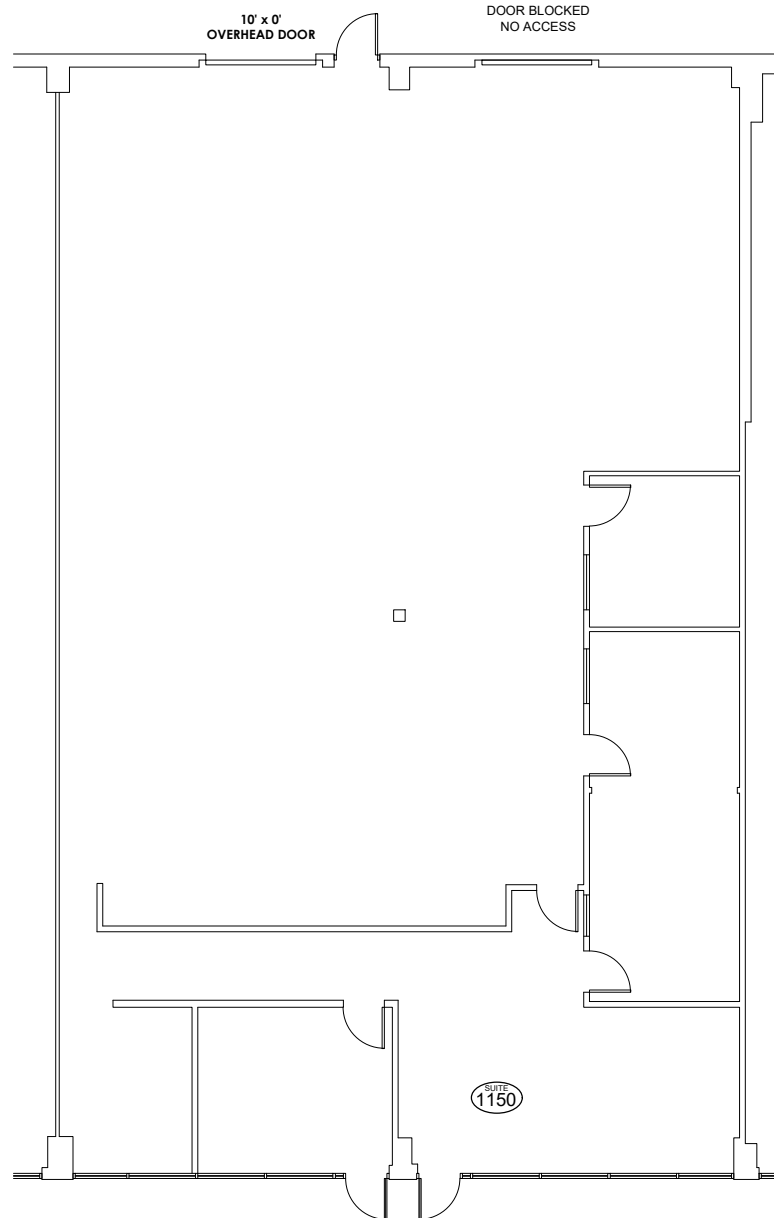

As Built Floor Plan for Marketing

