


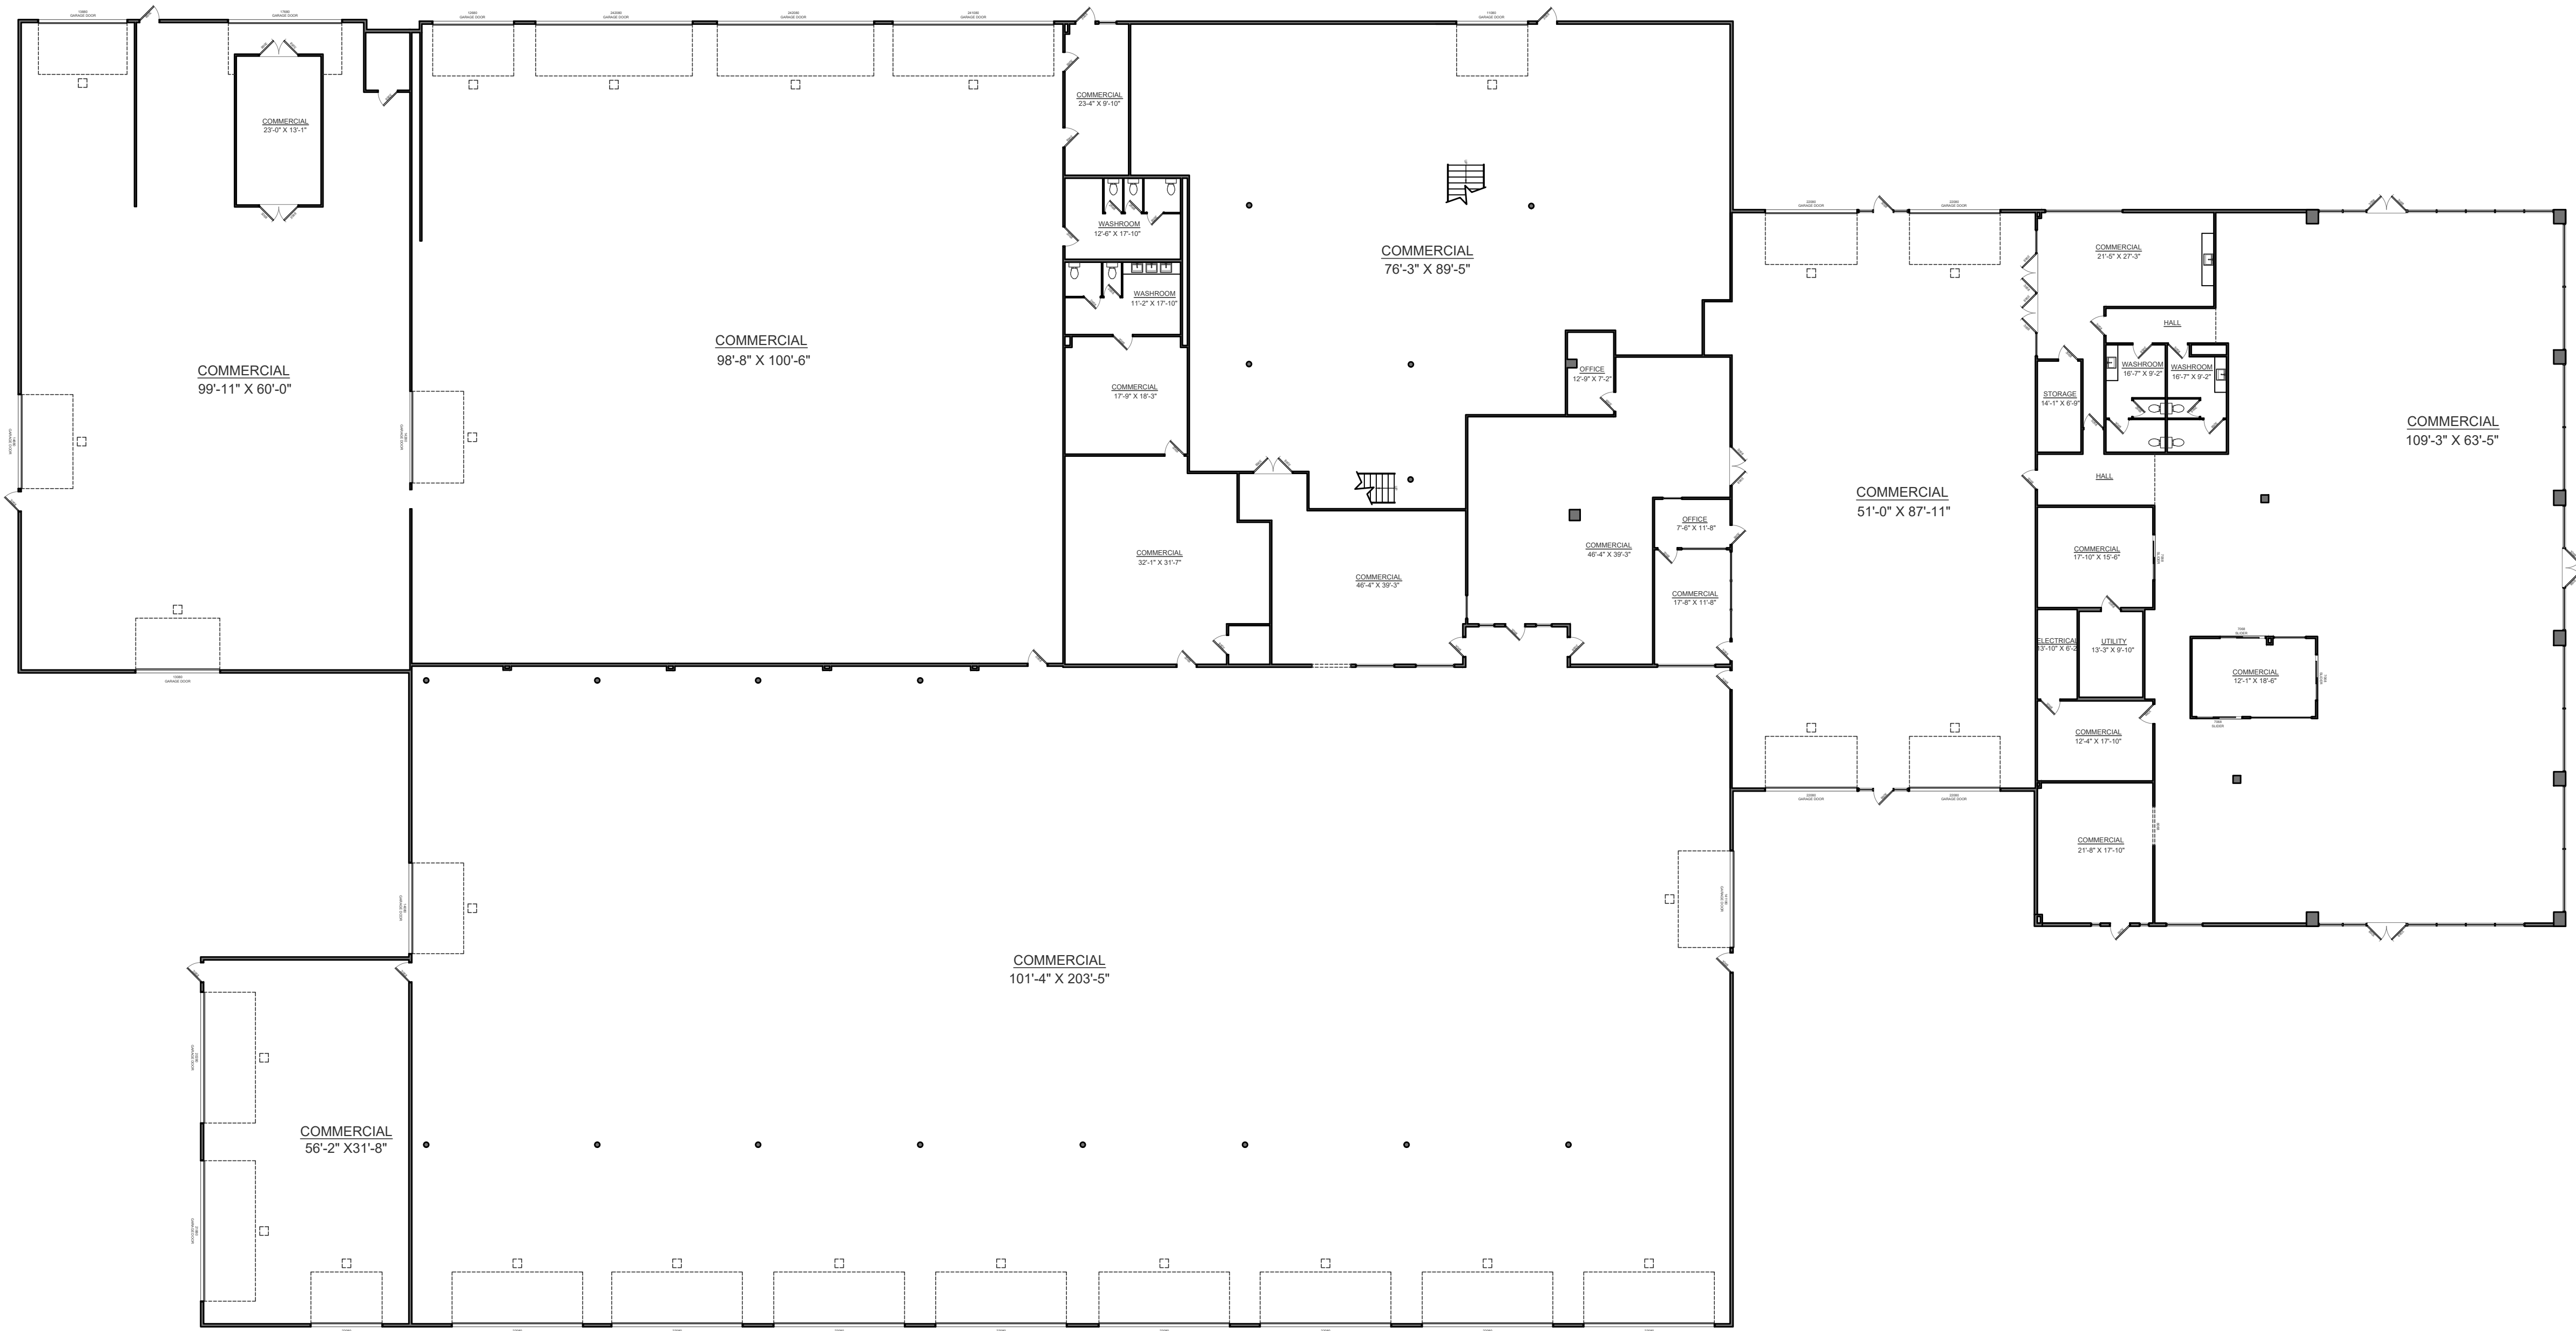

MAIN FLOOR LAYOUT PLAN

SCALE: 1/16" = 1'-0"

GENERAL NOTES

- 2X6 EXTERIOR FRAMING.
2X4 INTERIOR FRAMING UNLESS NOTED OTHERWISE ON PLAN.
- 9'-1" WALL HEIGHT THROUGHOUT UNLESS NOTED OTHERWISE ON PLAN.
- 8'-0" WINDOW HEADER HEIGHT,
& 8'-0" TALL INTERIOR & EXTERIOR DOORS UNLESS NOTED OTHERWISE ON PLAN.
- ENSURE THAT ALL OPENINGS PASSING THROUGH FIREWALLS AND ROOF SURFACES ARE PROPERLY SEALED WITH FLASHING AND CAULKING.
- REFER TO THE STRUCTURAL DRAWINGS TO DETERMINE THE SIZE AND PLACEMENT OF ALL STRUCTURAL COMPONENTS



EVOLUTION DRAFTING LLC

65 W WARREN AVE
COLORADO CITY, AZ 86021
PHONE: (435) 216-1353
OFFICE@EVOLUTIONDRAFTING.COM

ALL RIGHTS RESERVED

PROPOSED AS-BUILT PLAN
FOR
GRANT WOODRUFF

LOT #6645 (.00 ACRE)
NORTH FREEWAY
HOUSTON, TX 77057, USA

ISSUE DATES:

12/19/2025

DRAWN BY:

L.H.


BUILDING AREAS

MAIN FLOOR AREA:	62,323 S.F.
2ND FLOOR AREA:	9,498 S.F.
ACCESSORY BUILDING AREA:	1,090 S.F.
TOTAL USE AREA:	72,911 S.F.

PAGE #

1

MAIN
FLOOR LAYOUT PLAN

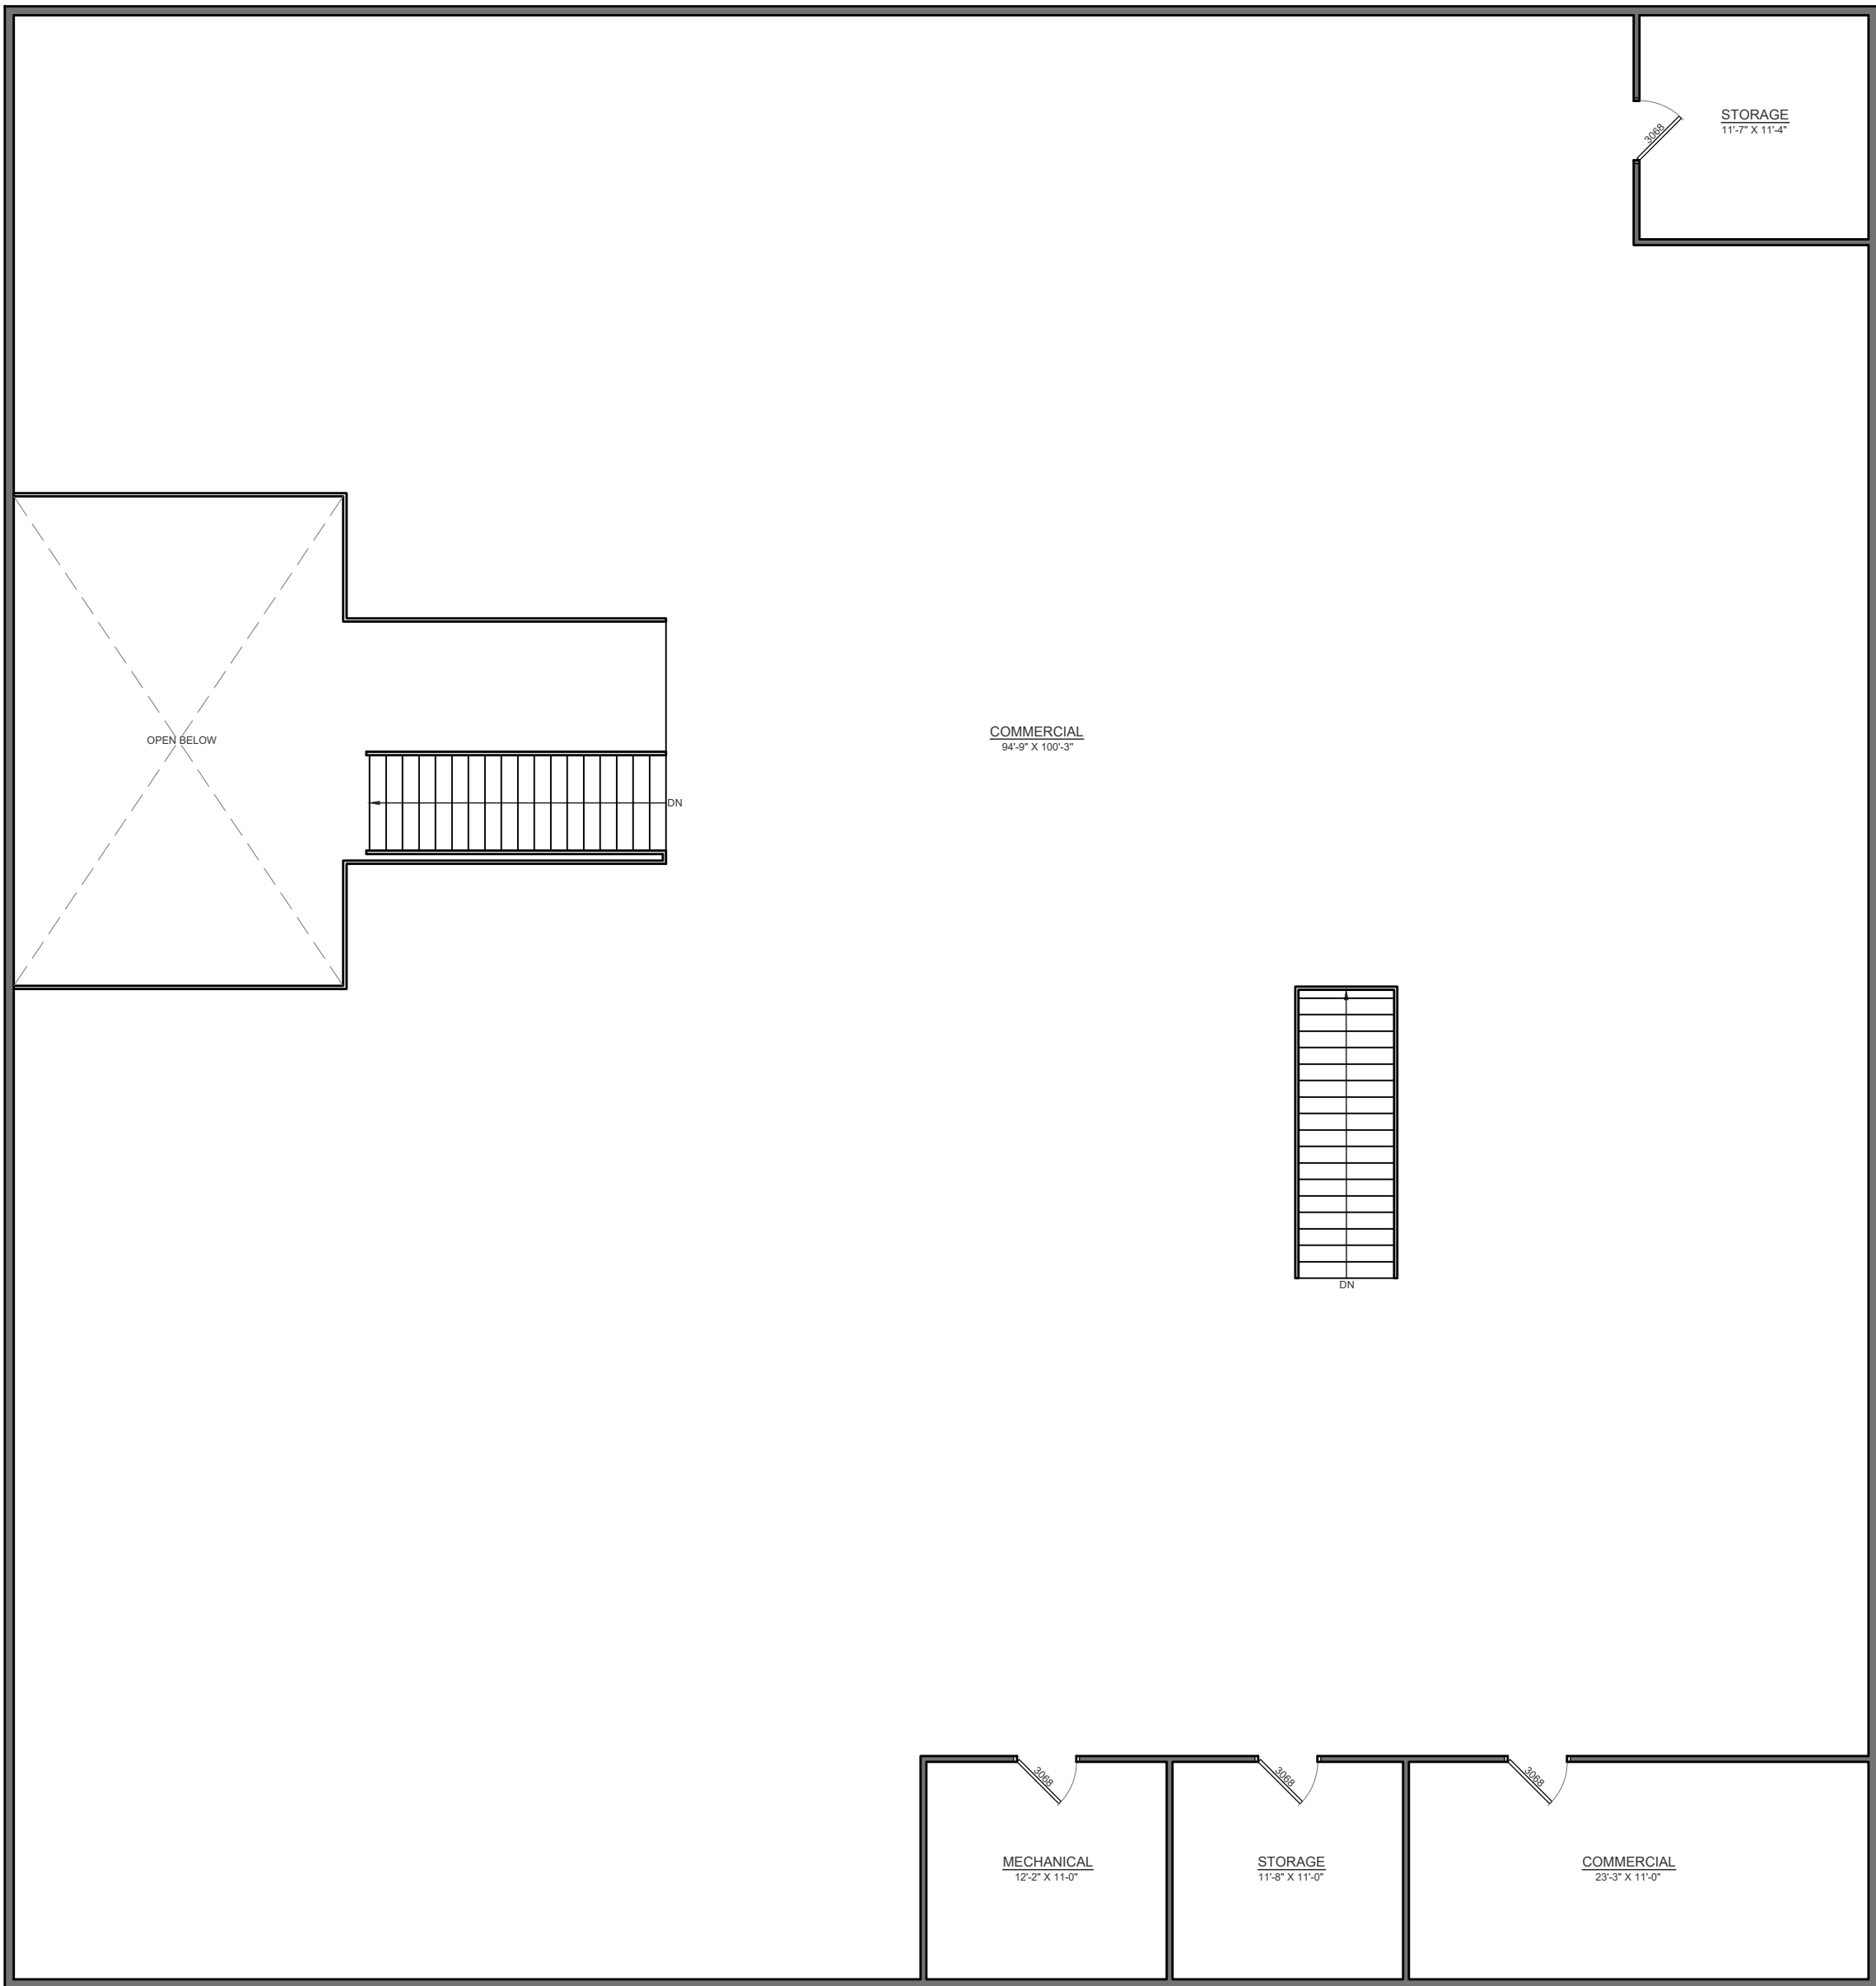

2ND FLOOR LAYOUT PLAN
SCALE: 1/8" = 1'-0"

GENERAL NOTES

- 2X6 EXTERIOR FRAMING.
2X4 INTERIOR FRAMING UNLESS NOTED OTHERWISE ON PLAN.
- 9'-1" WALL HEIGHT THROUGHOUT UNLESS NOTED OTHERWISE ON PLAN.
- 8'-0" WINDOW HEADER HEIGHT,
& 8'-0" TALL INTERIOR & EXTERIOR DOORS
UNLESS NOTED OTHERWISE ON PLAN.
- ENSURE THAT ALL OPENINGS PASSING THROUGH
FIREWALLS AND ROOF SURFACES ARE PROPERLY
SEALED WITH FLASHING AND CAULKING.
- REFER TO THE STRUCTURAL DRAWINGS TO
DETERMINE THE SIZE AND PLACEMENT OF ALL
STRUCTURAL COMPONENTS



EVOLUTION DRAFTING LLC

65 W WARREN AVE
COLORADO CITY, AZ 86021
PHONE: (435) 216-1353
OFFICE@EVOLUTIONDRAFTING.COM
ALL RIGHTS RESERVED

PROPOSED AS-BUILT PLAN
FOR
GRANT WOODRUFF

LOT #6645 (00 ACRE)
NORTH FREEWAY
HOUSTON, TX 77057, USA

ISSUE DATES:
12/19/2025

DRAWN BY:
L.H.


BUILDING AREAS

MAIN FLOOR AREA:	62,323 S.F.
2ND FLOOR AREA:	9,498 S.F.
ACCESSORY BUILDING AREA:	1,090 S.F.
TOTAL USE AREA:	72,911 S.F.

PAGE #

2

2ND FLOOR LAYOUT PLAN

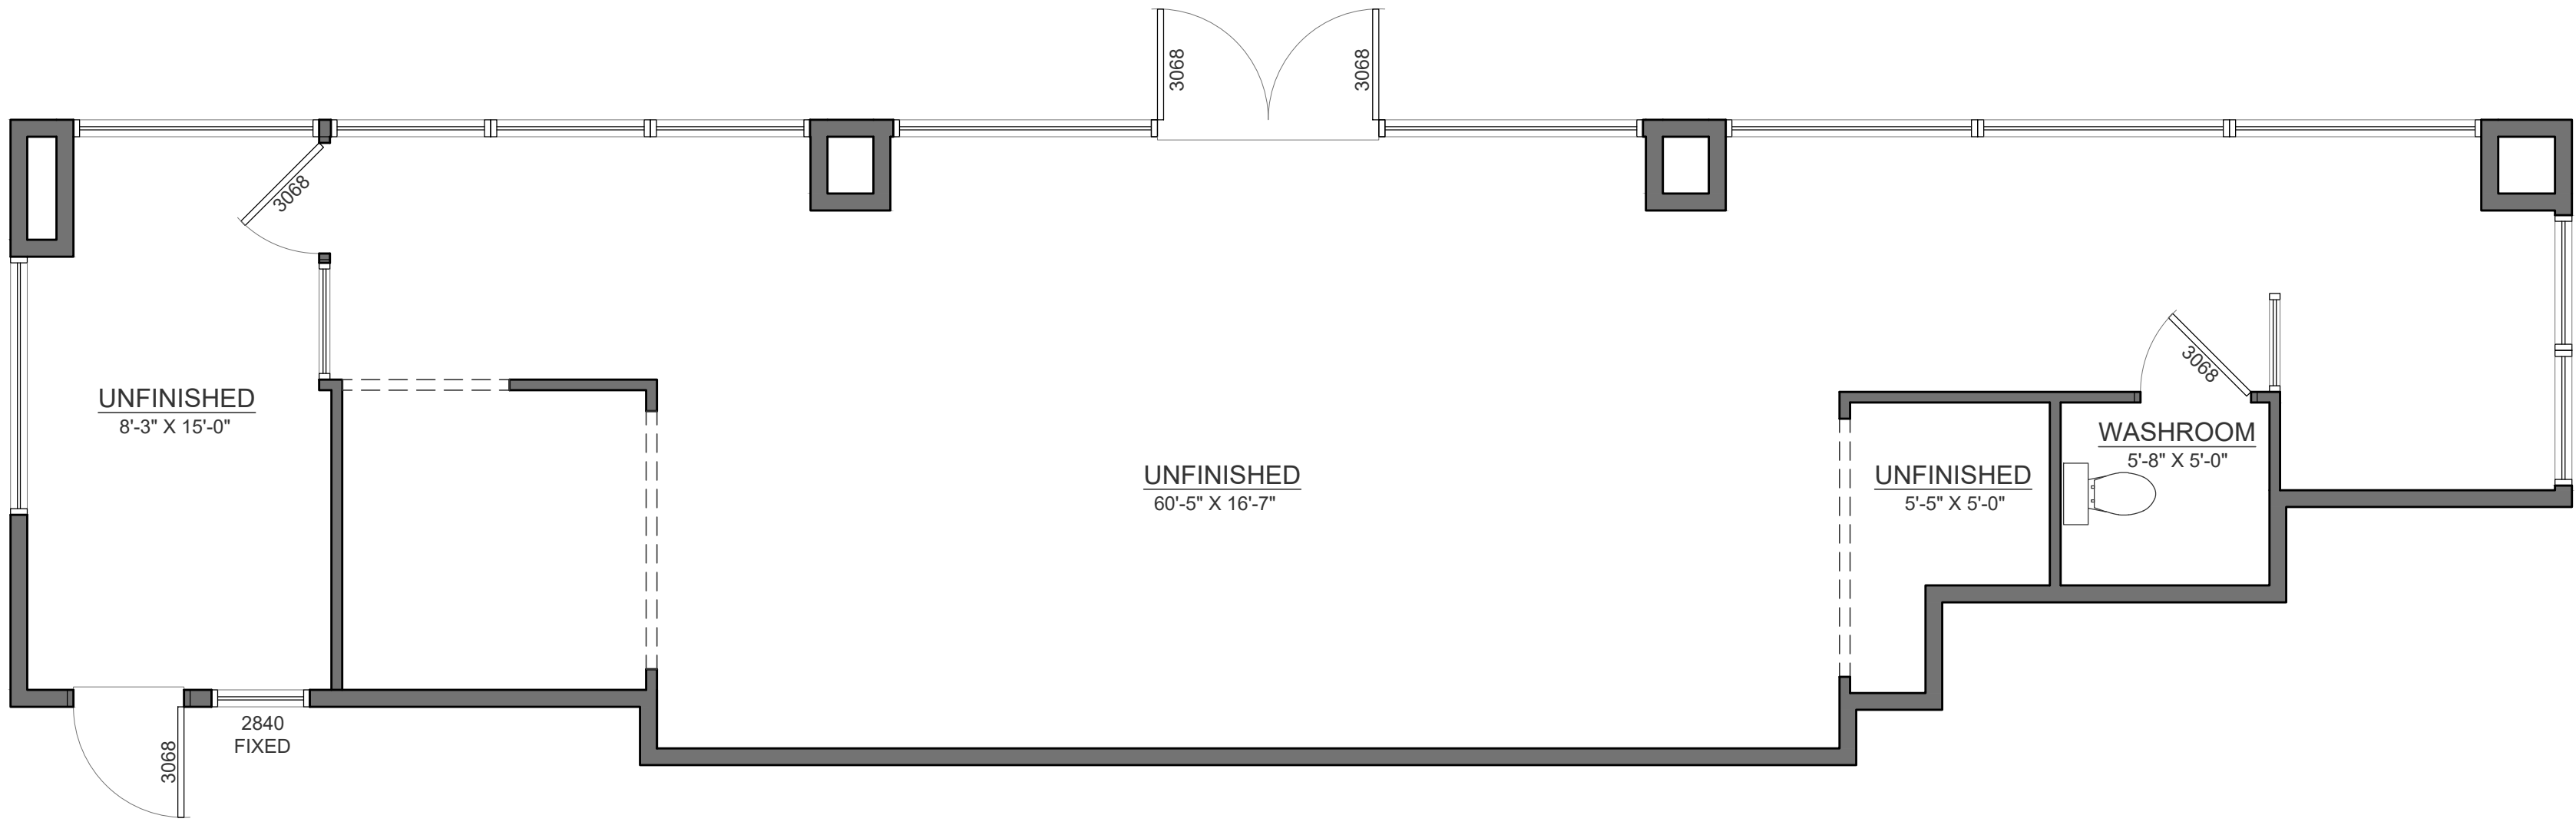

ACCESSORY BUILDING LAYOUT PLAN

SCALE: 1/4" = 1'-0"

GENERAL NOTES

- 1. 2X6 EXTERIOR FRAMING.
2X4 INTERIOR FRAMING UNLESS NOTED OTHERWISE ON PLAN.
- 2. 9'-1" WALL HEIGHT THROUGHOUT UNLESS NOTED OTHERWISE ON PLAN.
- 3. 8'-0" WINDOW HEADER HEIGHT, & 8'-0" TALL INTERIOR & EXTERIOR DOORS UNLESS NOTED OTHERWISE ON PLAN.
- 4. ENSURE THAT ALL OPENINGS PASSING THROUGH FIREWALLS AND ROOF SURFACES ARE PROPERLY SEALED WITH FLASHING AND CAULKING.
- 5. REFER TO THE STRUCTURAL DRAWINGS TO DETERMINE THE SIZE AND PLACEMENT OF ALL STRUCTURAL COMPONENTS



EVOLUTION DRAFTING LLC

65 W WARREN AVE
COLORADO CITY, AZ 86021
PHONE: (435) 216-1353
OFFICE@EVOLUTIONDRAFTING.COM
ALL RIGHTS RESERVED

PROPOSED AS-BUILT PLAN
FOR
GRANT WOODRUFF

LOT #6645 (00 ACRE)
NORTH FREEWAY
HOUSTON, TX 77057, USA

ISSUE DATES:
12/19/2025

DRAWN BY:
L.H.


BUILDING AREAS

MAIN FLOOR AREA:	62,323 S.F.
2ND FLOOR AREA:	9,498 S.F.
ACCESSORY BUILDING AREA:	1,090 S.F.
TOTAL USE AREA:	72,911 S.F.

PAGE #

3

1ST FLOOR LITTLE BUILDING
LAYOUT PLAN

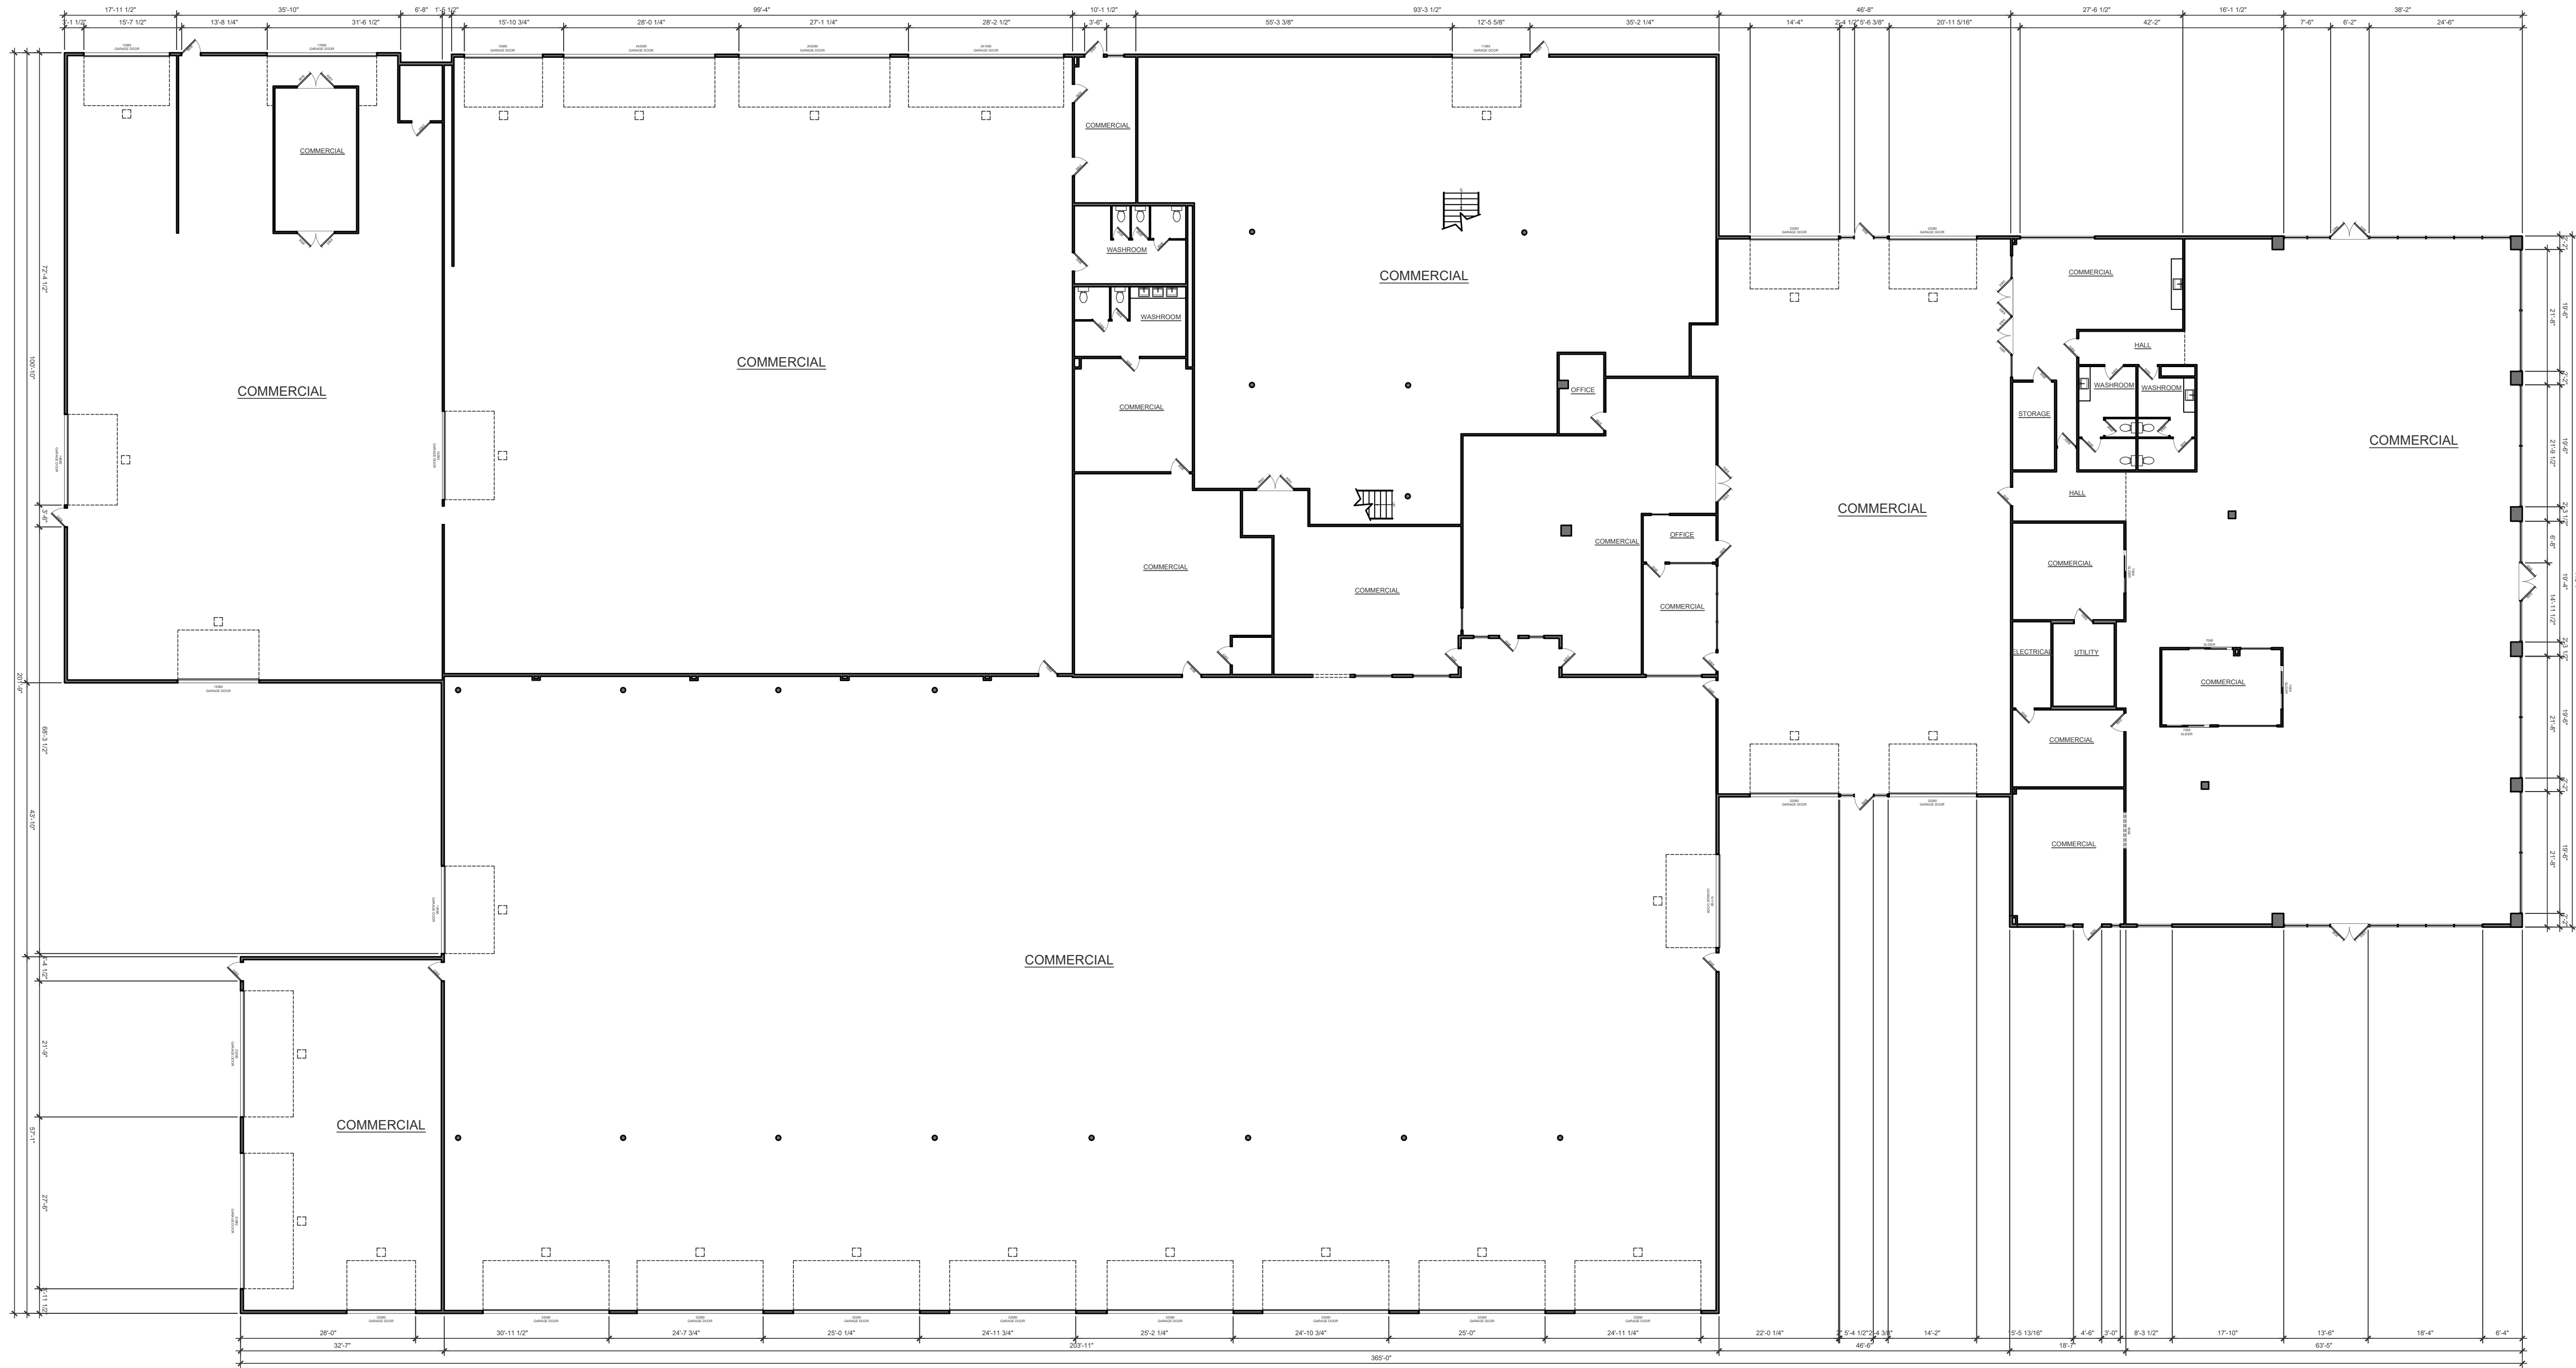

MAIN FLOOR DIMENSION PLAN
SCALE: 1/16" = 1'-0"

GENERAL NOTES

- 2X6 EXTERIOR FRAMING.
2X4 INTERIOR FRAMING UNLESS NOTED OTHERWISE ON PLAN.
- 9'-1" WALL HEIGHT THROUGHOUT UNLESS NOTED OTHERWISE ON PLAN.
- 8'-0" WINDOW HEADER HEIGHT,
& 8'-0" TALL INTERIOR & EXTERIOR DOORS
UNLESS NOTED OTHERWISE ON PLAN.
- ENSURE THAT ALL OPENINGS PASSING THROUGH
FIREWALLS AND ROOF SURFACES ARE PROPERLY
SEALED WITH FLASHING AND CAULKING.
- REFER TO THE STRUCTURAL DRAWINGS TO
DETERMINE THE SIZE AND PLACEMENT OF ALL
STRUCTURAL COMPONENTS



EVOLUTION DRAFTING LLC

65 W WARREN AVE
COLORADO CITY, AZ 86021
PHONE: (435) 216-1353
OFFICE@EVOLUTIONDRAFTING.COM
ALL RIGHTS RESERVED

PROPOSED AS-BUILT PLAN
FOR
GRANT WOODRUFF

LOT #6645 (00 ACRE)
NORTH FREWAY
HOUSTON, TX 77057, USA

ISSUE DATES:
12/19/2025

DRAWN BY:
L.H.


BUILDING AREAS

MAIN FLOOR AREA:	62,323 S.F.
2ND FLOOR AREA:	9,498 S.F.
ACCESSORY BUILDING AREA:	1,090 S.F.
TOTAL USE AREA:	72,911 S.F.

PAGE #

4

MAIN
FLOOR DIMENSION PLAN

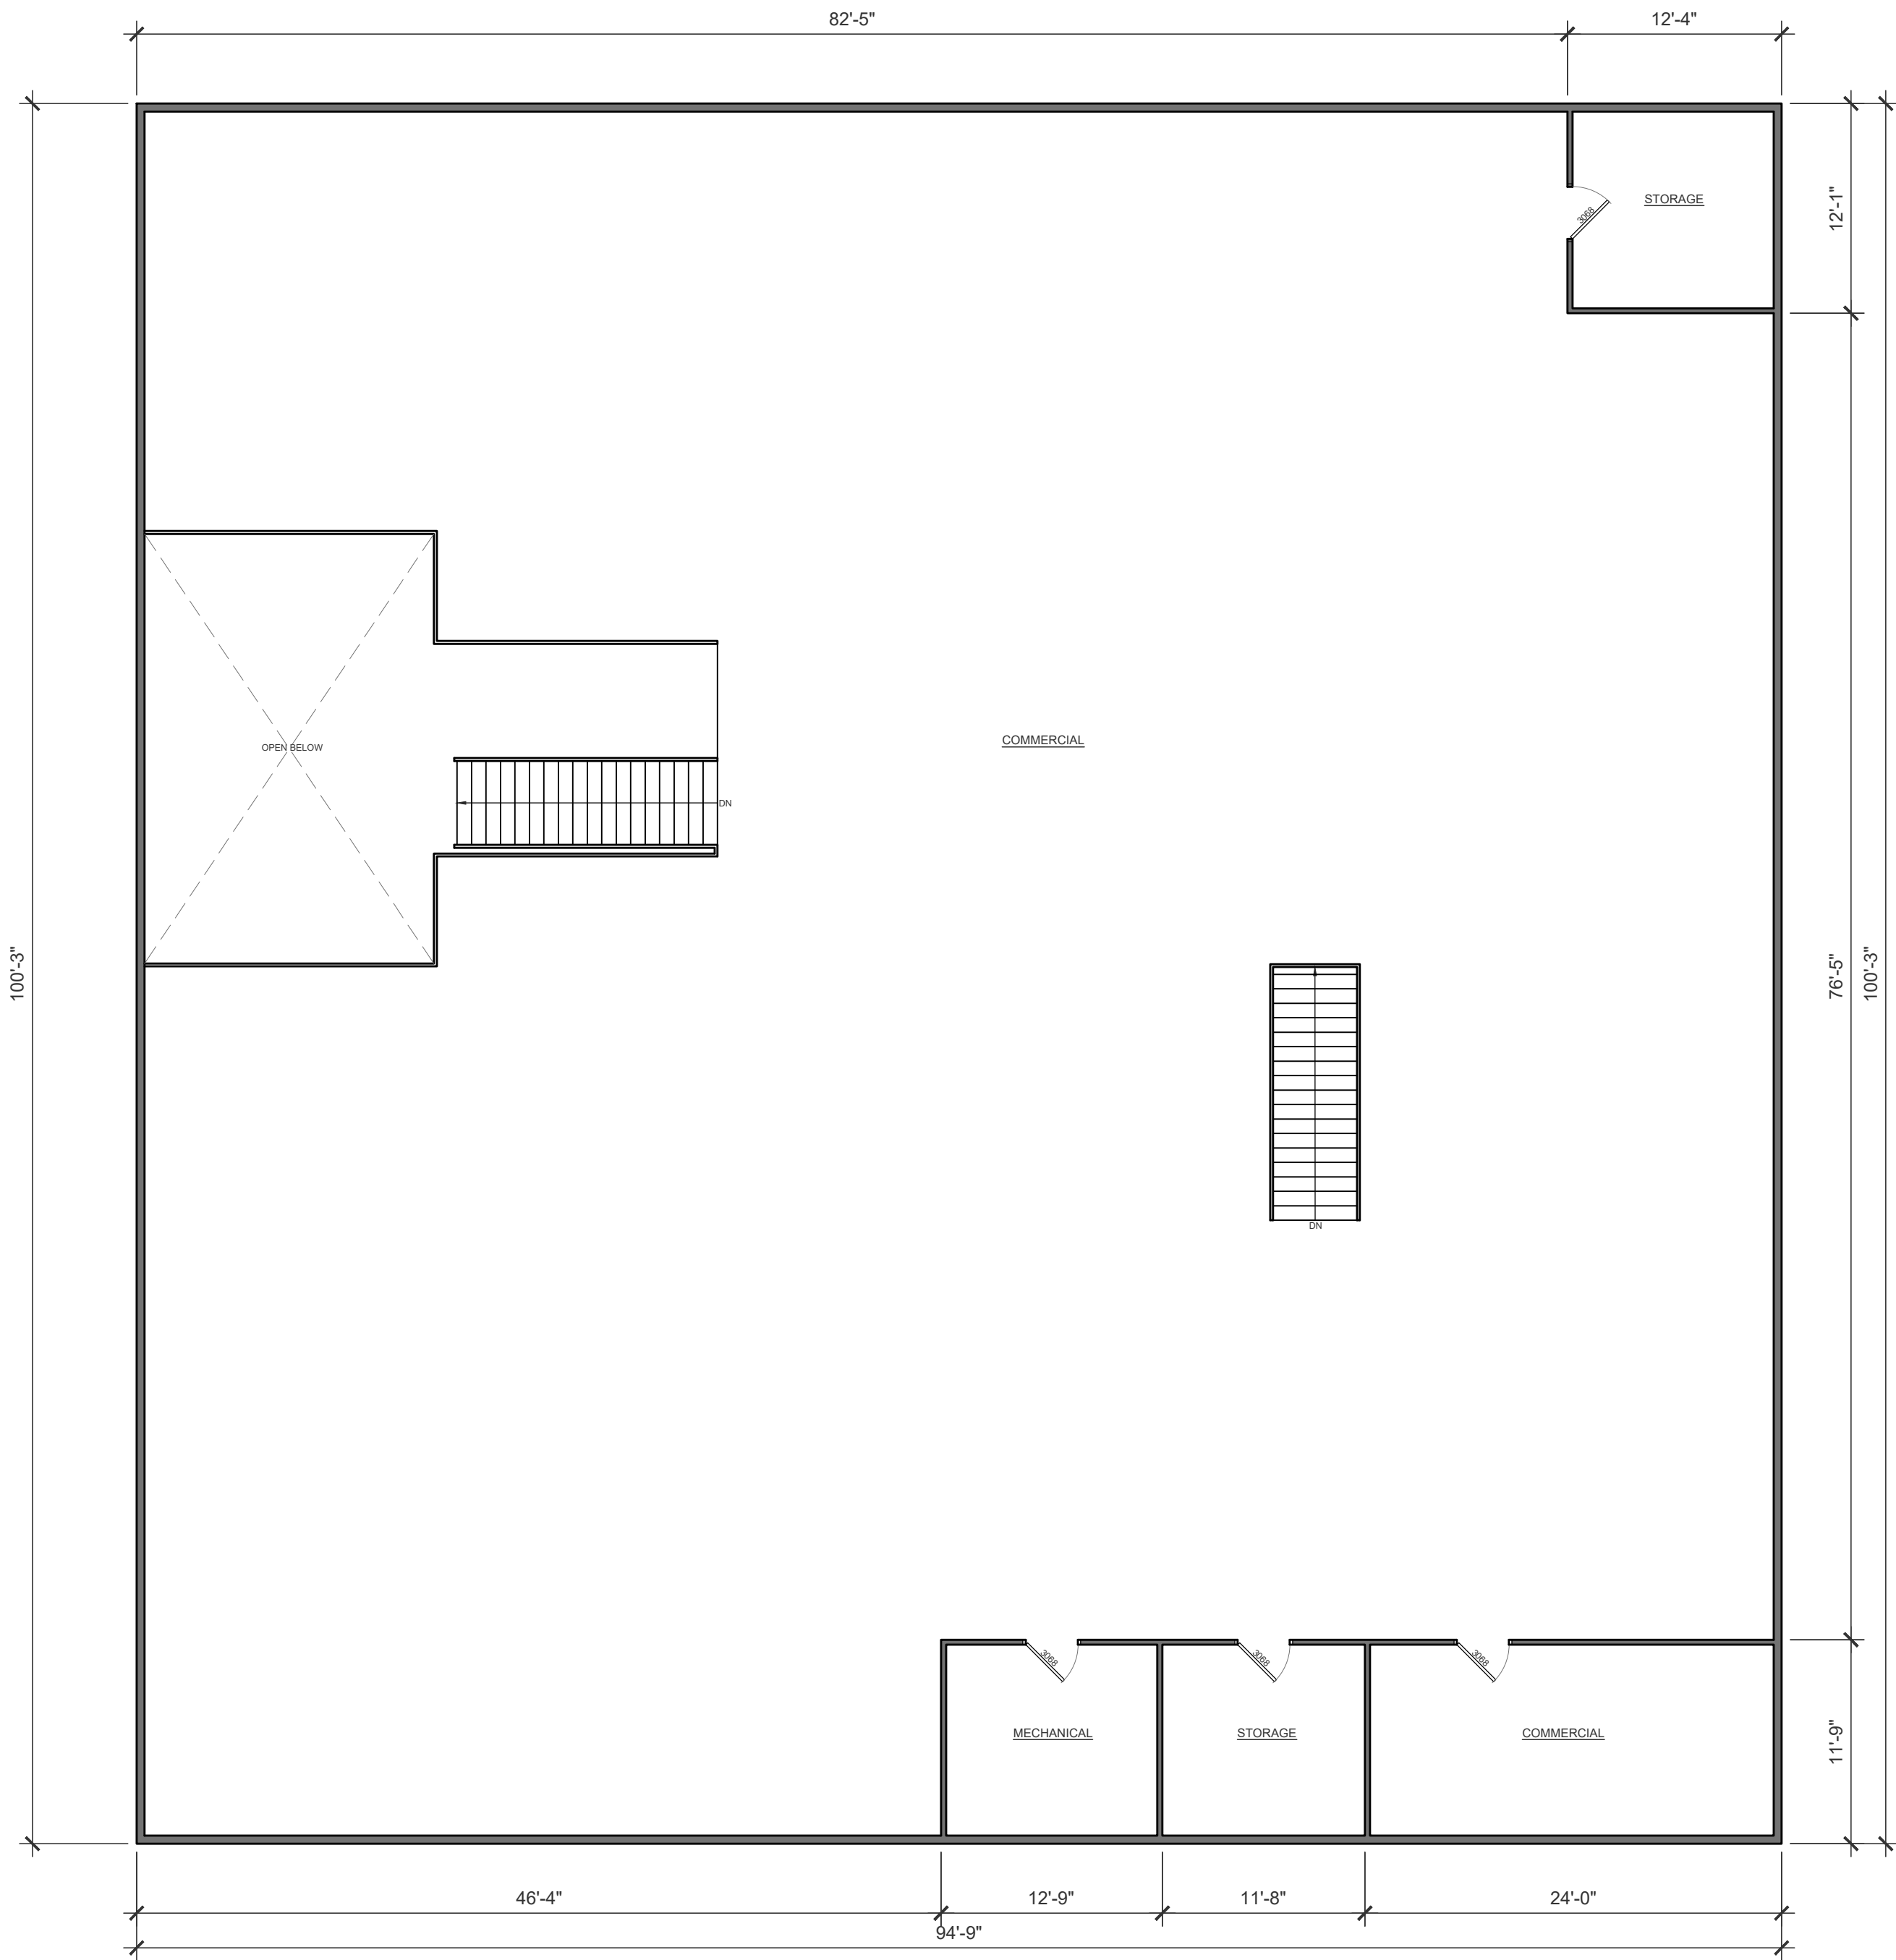

2ND FLOOR DIMENSION PLAN
SCALE: 1/8" = 1'-0"

GENERAL NOTES

- 2X6 EXTERIOR FRAMING.
2X4 INTERIOR FRAMING UNLESS NOTED OTHERWISE ON PLAN.
- 9'-1" WALL HEIGHT THROUGHOUT UNLESS NOTED OTHERWISE ON PLAN.
- 8'-0" WINDOW HEADER HEIGHT, & 8'-0" TALL INTERIOR & EXTERIOR DOORS UNLESS NOTED OTHERWISE ON PLAN.
- ENSURE THAT ALL OPENINGS PASSING THROUGH FIREWALLS AND ROOF SURFACES ARE PROPERLY SEALED WITH FLASHING AND CAULKING.
- REFER TO THE STRUCTURAL DRAWINGS TO DETERMINE THE SIZE AND PLACEMENT OF ALL STRUCTURAL COMPONENTS



EVOLUTION DRAFTING LLC

65 W WARREN AVE
COLORADO CITY, AZ 86021
PHONE: (435) 216-1353
OFFICE@EVOLUTIONDRAFTING.COM
ALL RIGHTS RESERVED

PROPOSED AS-BUILT PLAN
FOR
GRANT WOODRUFF

LOT #6645 (.00 ACRE)
NORTH FREEWAY
HOUSTON, TX 77037, USA

ISSUE DATES:

12/19/2025

DRAWN BY:

L.H.


BUILDING AREAS

MAIN FLOOR AREA:	62,323 S.F.
2ND FLOOR AREA:	9,498 S.F.
ACCESSORY BUILDING AREA:	1,090 S.F.
TOTAL USE AREA:	72,911 S.F.

PAGE #

5

2ND FLOOR DIMENSION PLAN

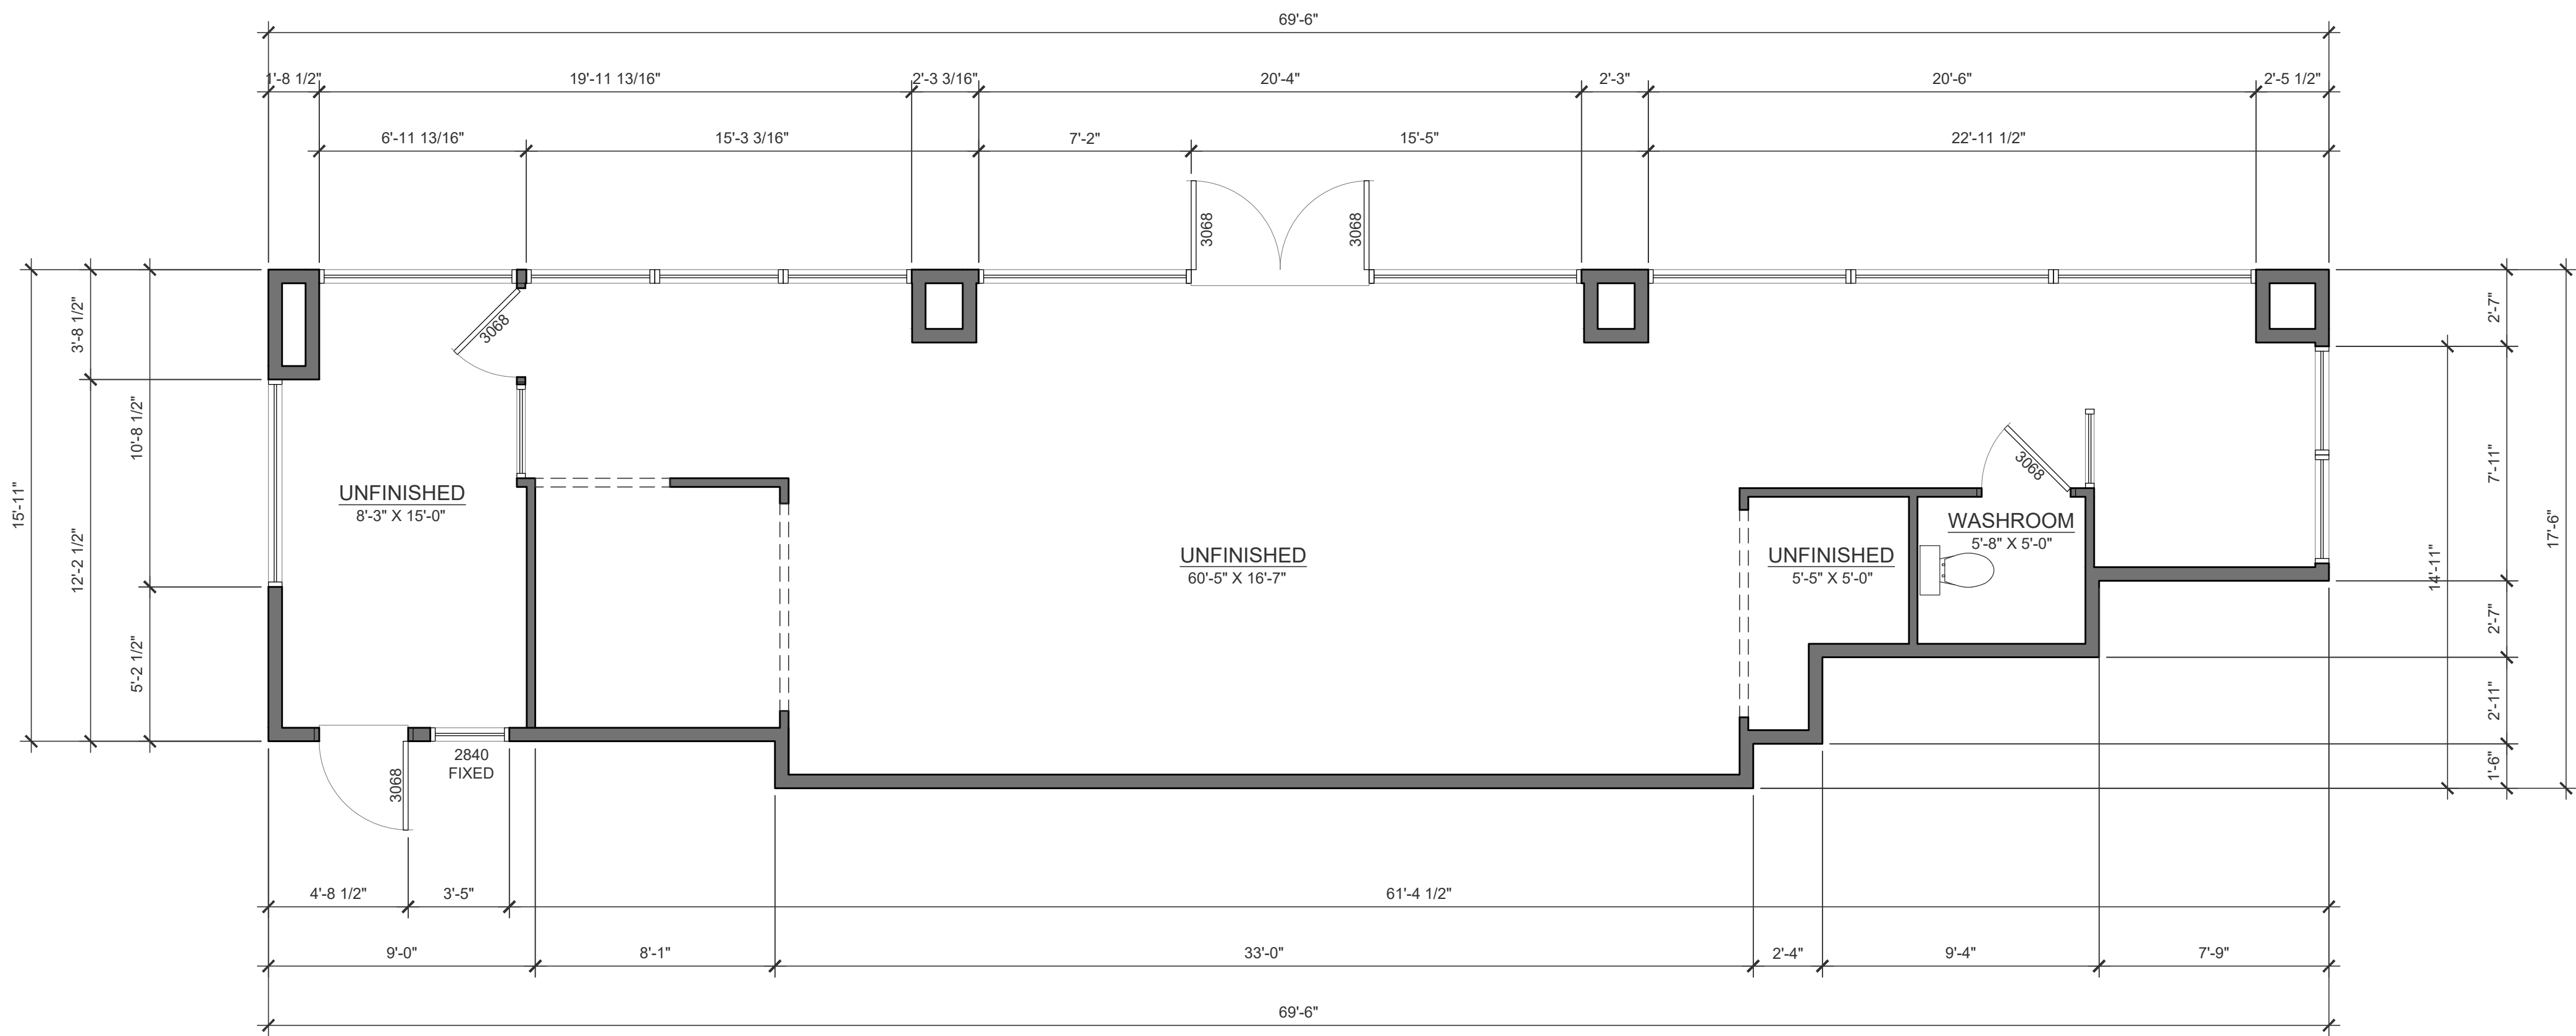

ACCESSORY BUILDING DIMENSION PLAN

SCALE: 1/4" = 1'-0"

GENERAL NOTES

- 2X6 EXTERIOR FRAMING.
2X4 INTERIOR FRAMING UNLESS NOTED OTHERWISE ON PLAN.
- 9'-1" WALL HEIGHT THROUGHOUT UNLESS NOTED OTHERWISE ON PLAN.
- 8'-0" WINDOW HEADER HEIGHT, & 8'-0" TALL INTERIOR & EXTERIOR DOORS UNLESS NOTED OTHERWISE ON PLAN.
- ENSURE THAT ALL OPENINGS PASSING THROUGH FIREWALLS AND ROOF SURFACES ARE PROPERLY SEALED WITH FLASHING AND CAULKING.
- REFER TO THE STRUCTURAL DRAWINGS TO DETERMINE THE SIZE AND PLACEMENT OF ALL STRUCTURAL COMPONENTS



EVOLUTION DRAFTING LLC

65 W WARREN AVE
COLORADO CITY, AZ 86021

PHONE: (435) 216-1353

OFFICE@EVOLUTIONDRAFTING.COM

ALL RIGHTS RESERVED

PROPOSED AS-BUILT PLAN
FOR
GRANT WOODRUFF

LOT #6645 (00 ACRE)
NORTH FREEWAY
HOUSTON, TX 77057, USA

ISSUE DATES:

12/19/2025

DRAWN BY:

L.H.

BUILDING AREAS

MAIN FLOOR AREA:	62,323 S.F.
2ND FLOOR AREA:	9,498 S.F.
ACCESSORY BUILDING AREA:	1,090 S.F.
TOTAL USE AREA:	72,911 S.F.

PAGE #

6

1ST FLOOR LITTLE BUILDING
DIMENSION PLAN