


# Property Key

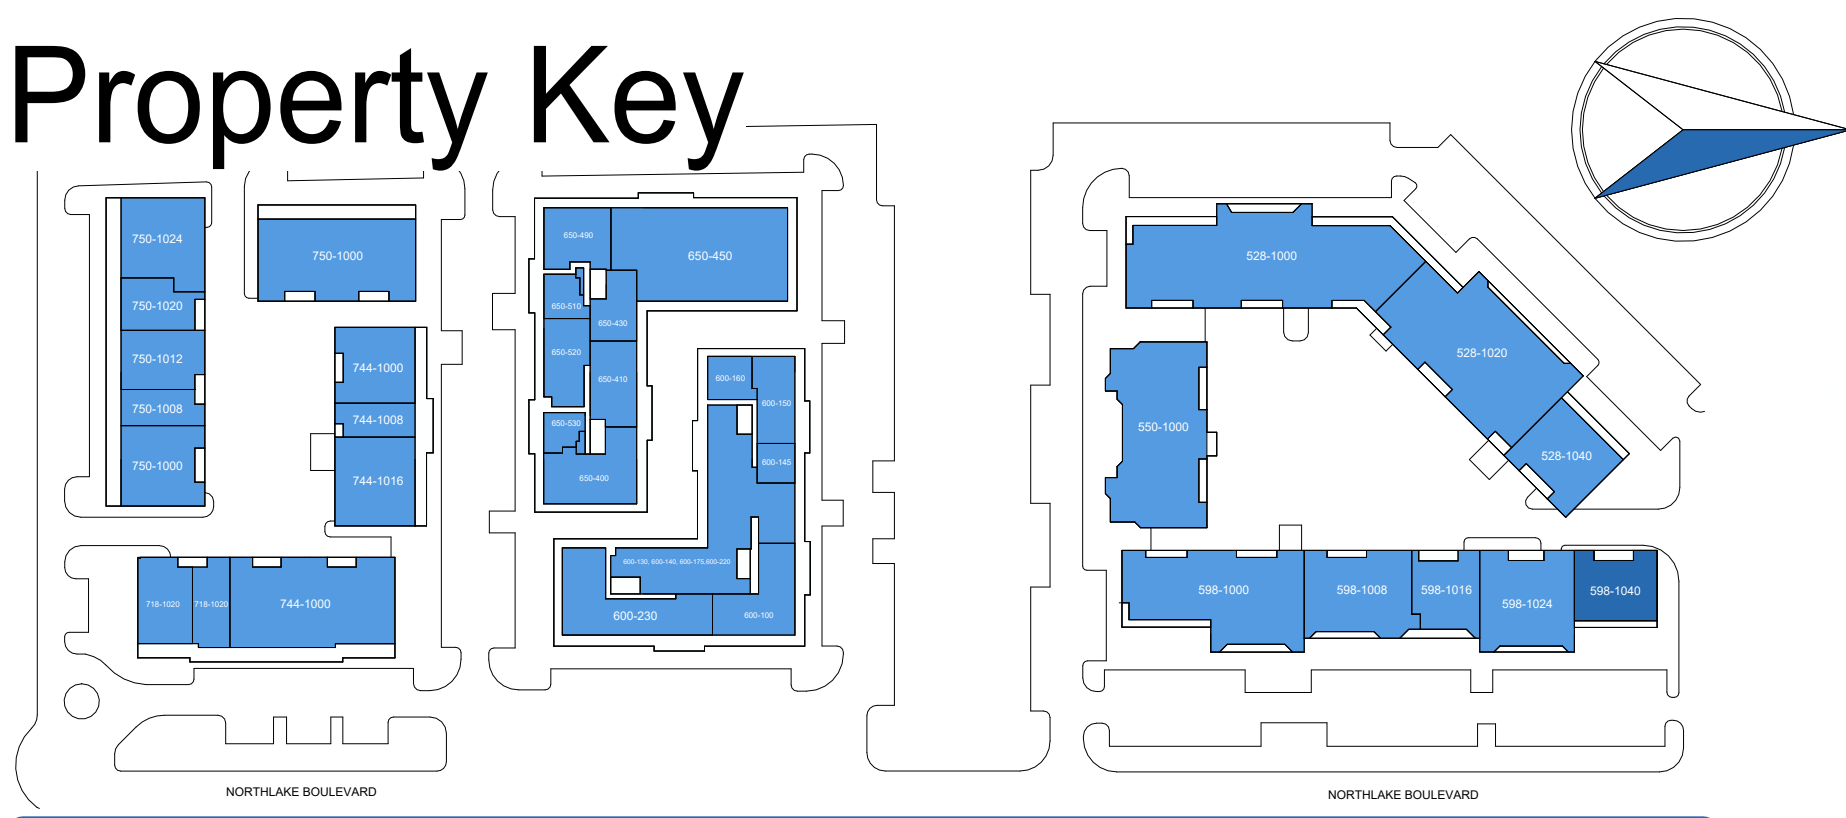

# Alt Springs As Built Marketing Package

598 Northlake Blvd, Alt Springs, FL 32701, US

Building: 598

Suite: 1040

Sheet **E1**

Scale: Not to Scale  
Sheet Size: 42" x 30"  
Not For Construction



# BAY SPACE

## Usable Square Foot Analysis

|                |       |      |
|----------------|-------|------|
| Office Area    | 3,292 | 100% |
| Warehouse Area | 5     | 0%   |
| Total Area     | 3,297 |      |

## Building Information

|                  |   |
|------------------|---|
| Deck Height:     | 13' - 3"  |
| Clear Height:    | 8' - 9 1/2"   |
| Ceiling Height:  | 7' - 5 1/2"   |
| Sprinklered:     | <input checked="" type="checkbox"/> Yes <input type="checkbox"/> No |
| Mechanical Area: | 0 SQFT  |

