
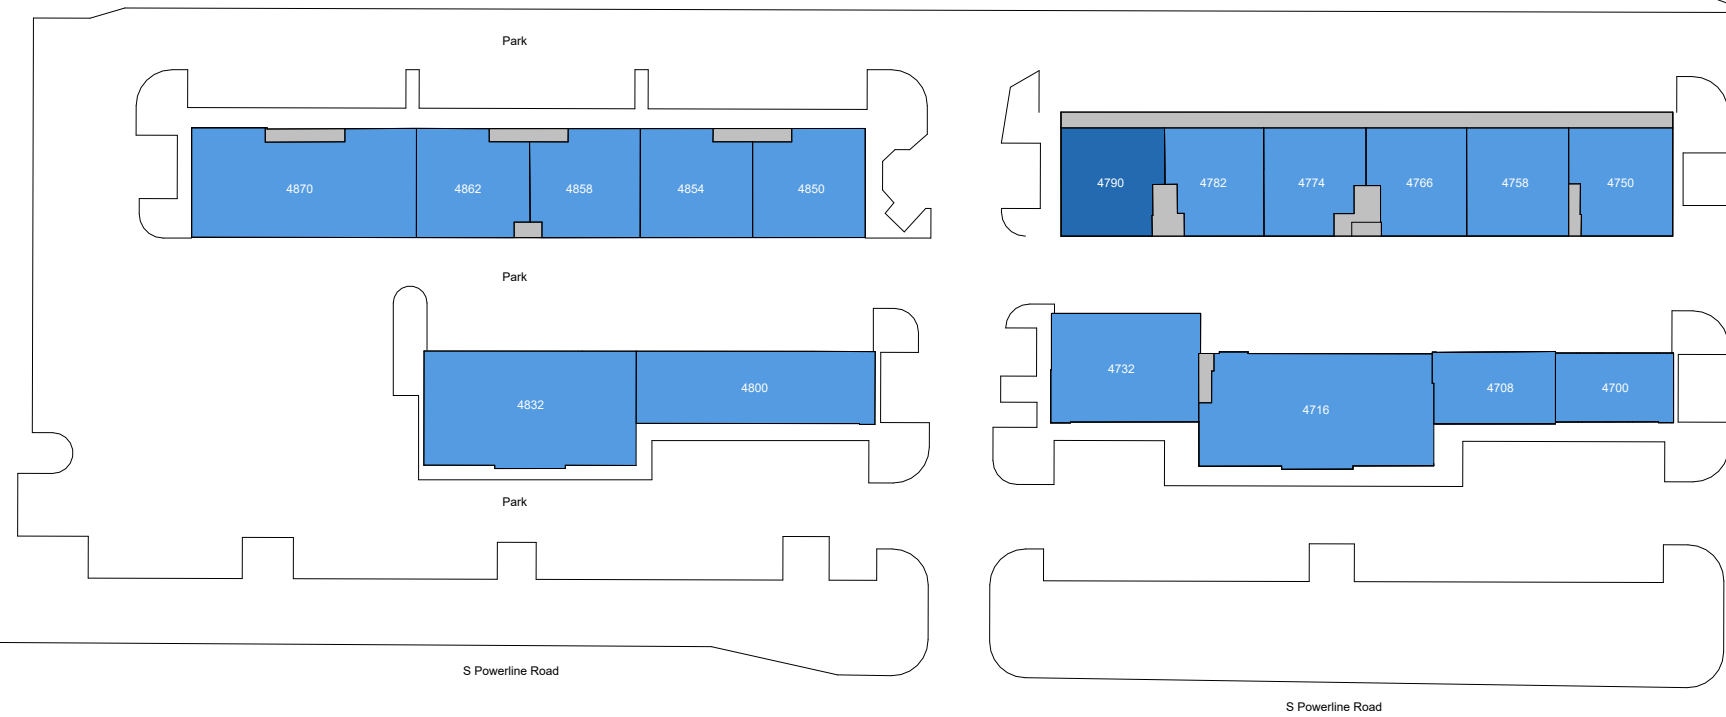


Property Key

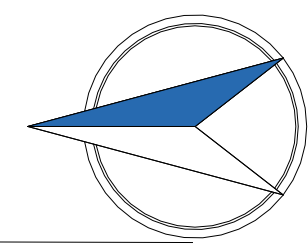


Deerfield

4750 N Powerline Rd, Pompano Beach, 33073 FL

Building: 4750

Suite: 4790

Sheet **E1**

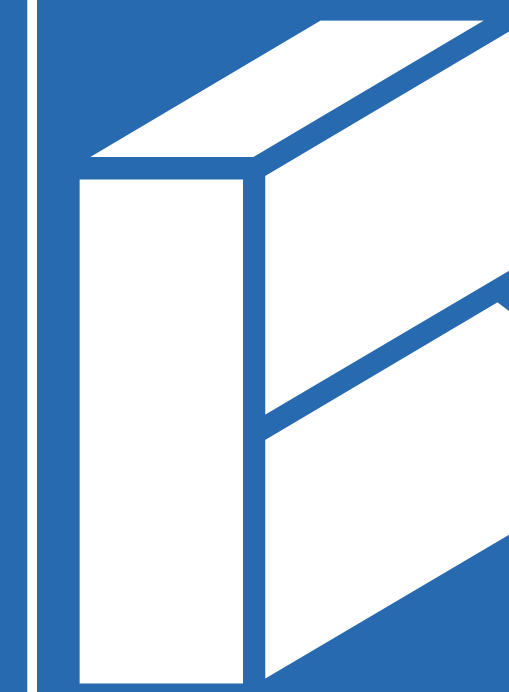

BAY SPACE


Scale: Not to Scale
Sheet Size: 42" x 30"
Not For Construction

Usable Square Foot Analysis

	SQFT	BUILDING PERCENTAGE
Office Area	2,000	100 %
Warehouse Area	0	0 %
Total Area	2,000	

Building Information

Deck Height:	22' - 7 3/4"	
Clear Height:	13' - 7 1/2"	
Ceiling Height:	8' - 3 3/4"	
Sprinklered:	<input type="checkbox"/> Yes	<input checked="" type="checkbox"/> No
Mechanical Area:	10 SQFT	

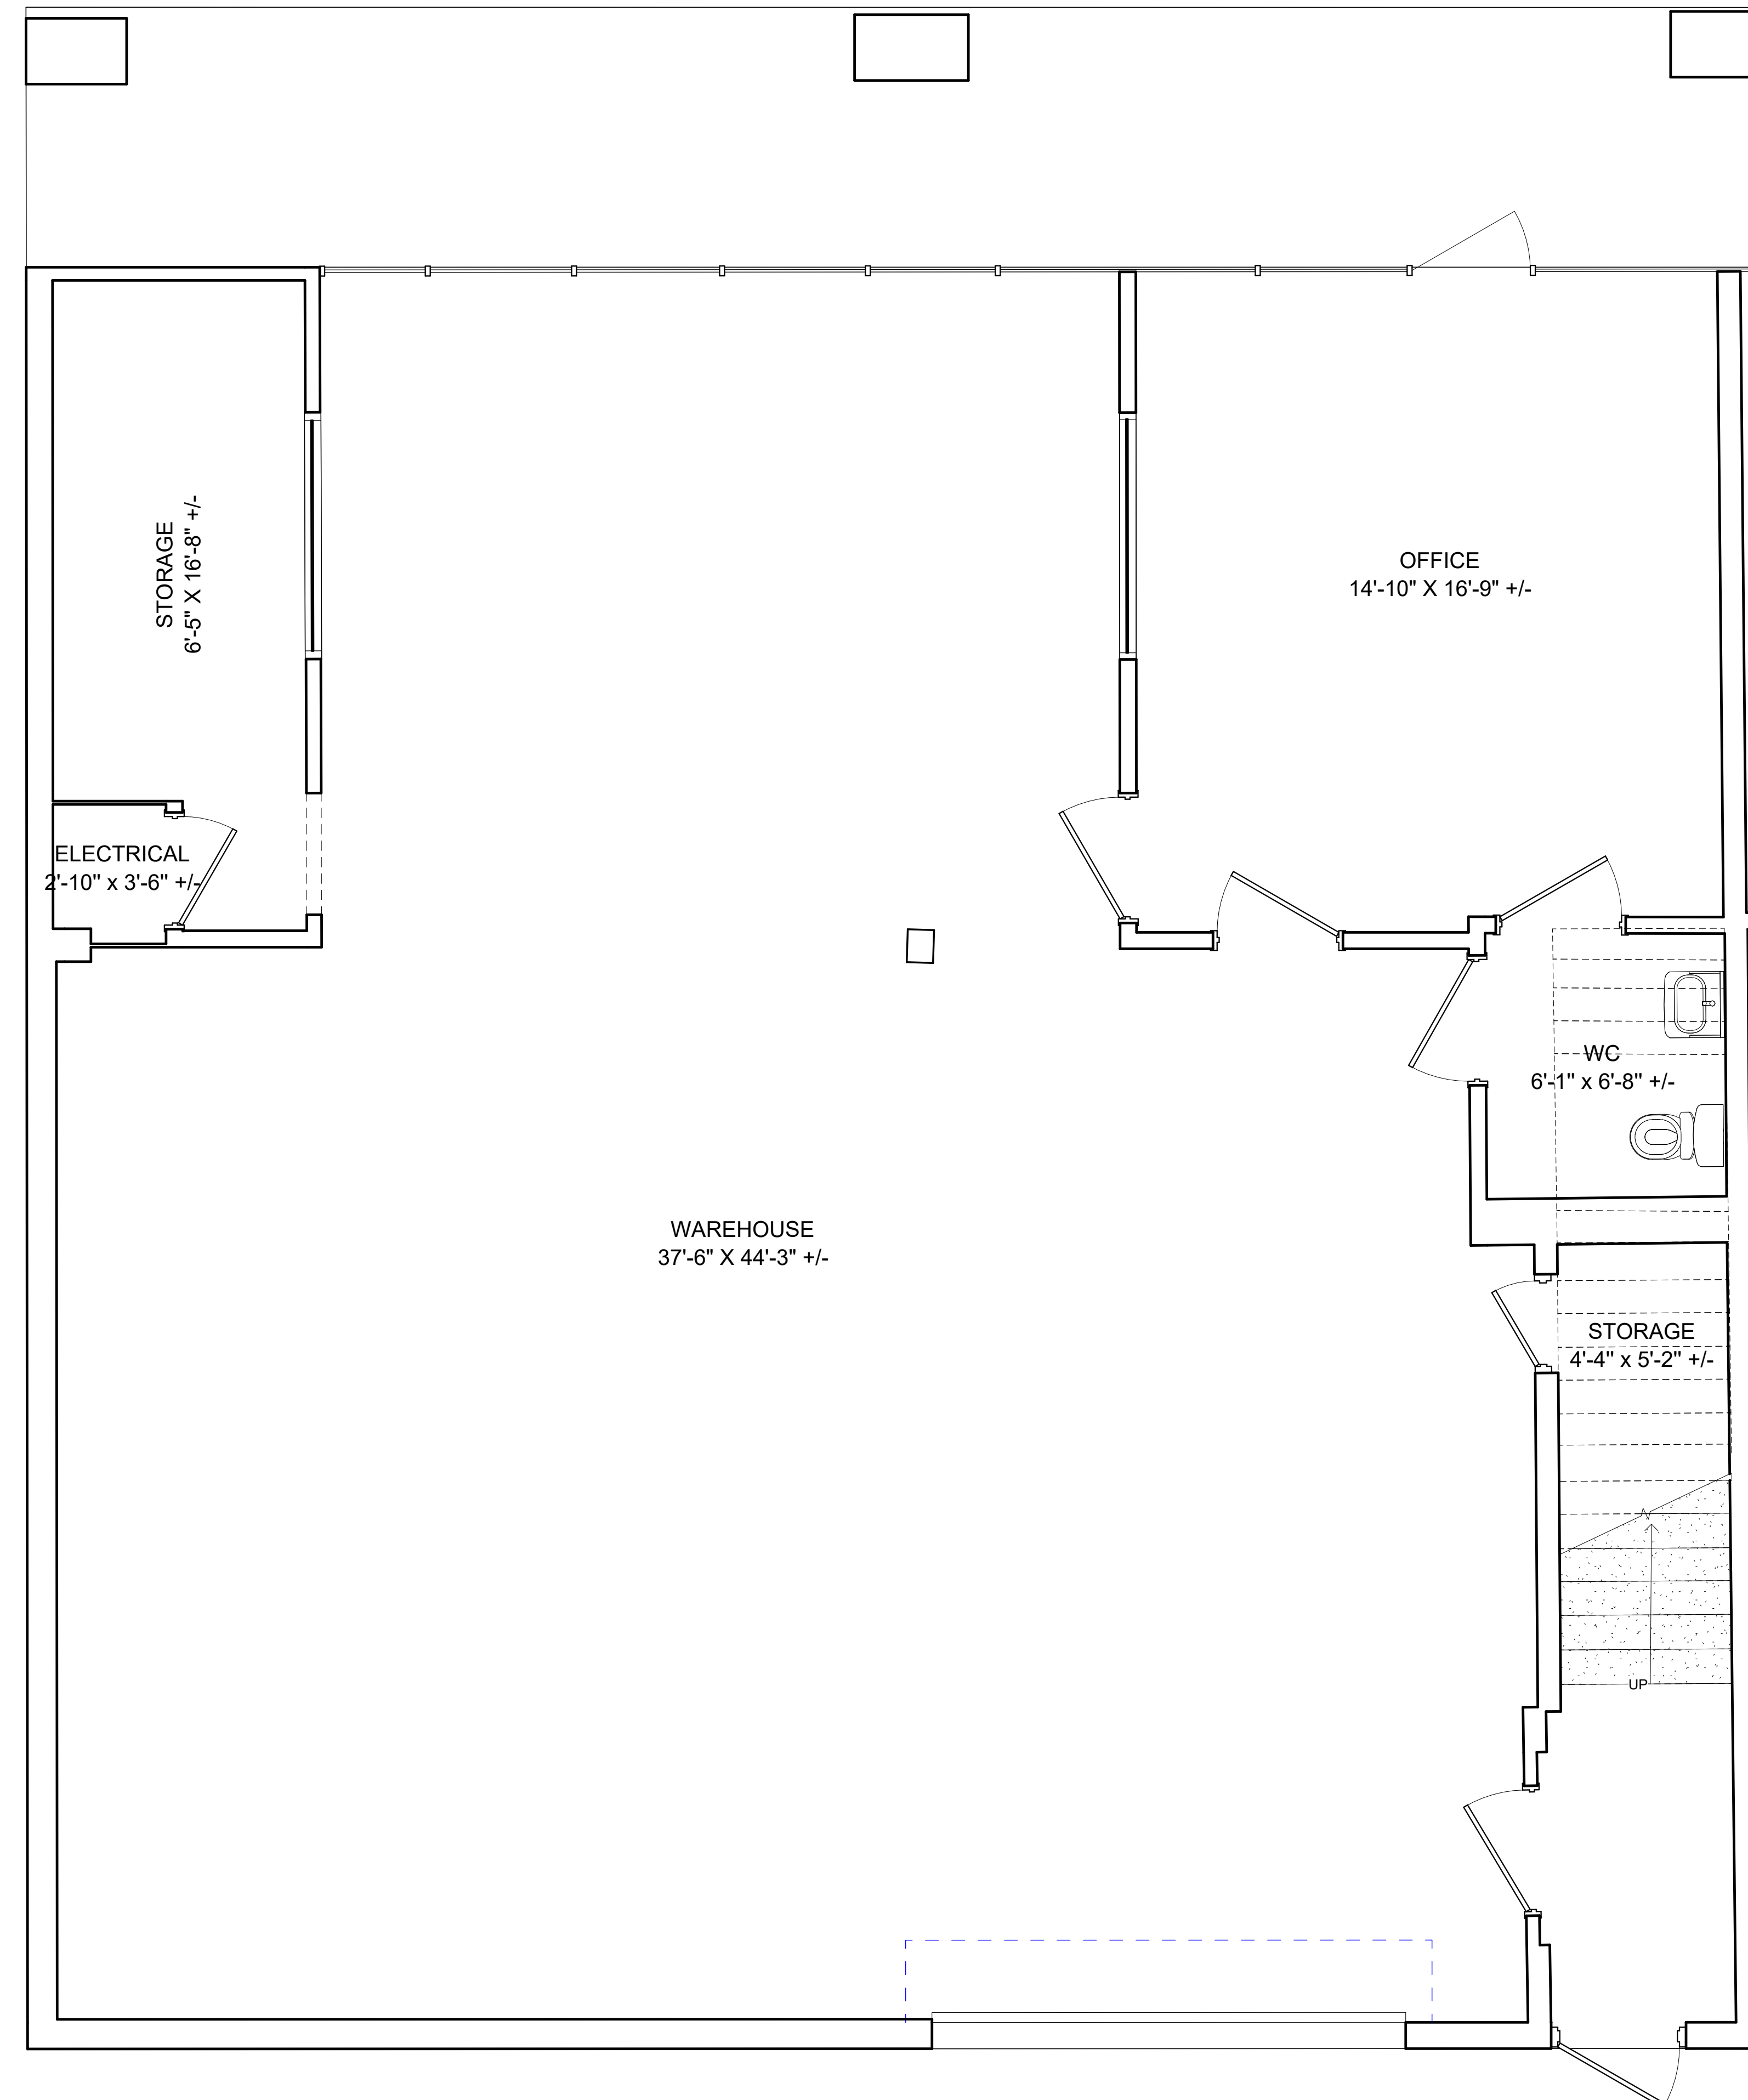

⑥ 4790
3/8" = 1'-0"

As Built Floor Plan for Marketing

