


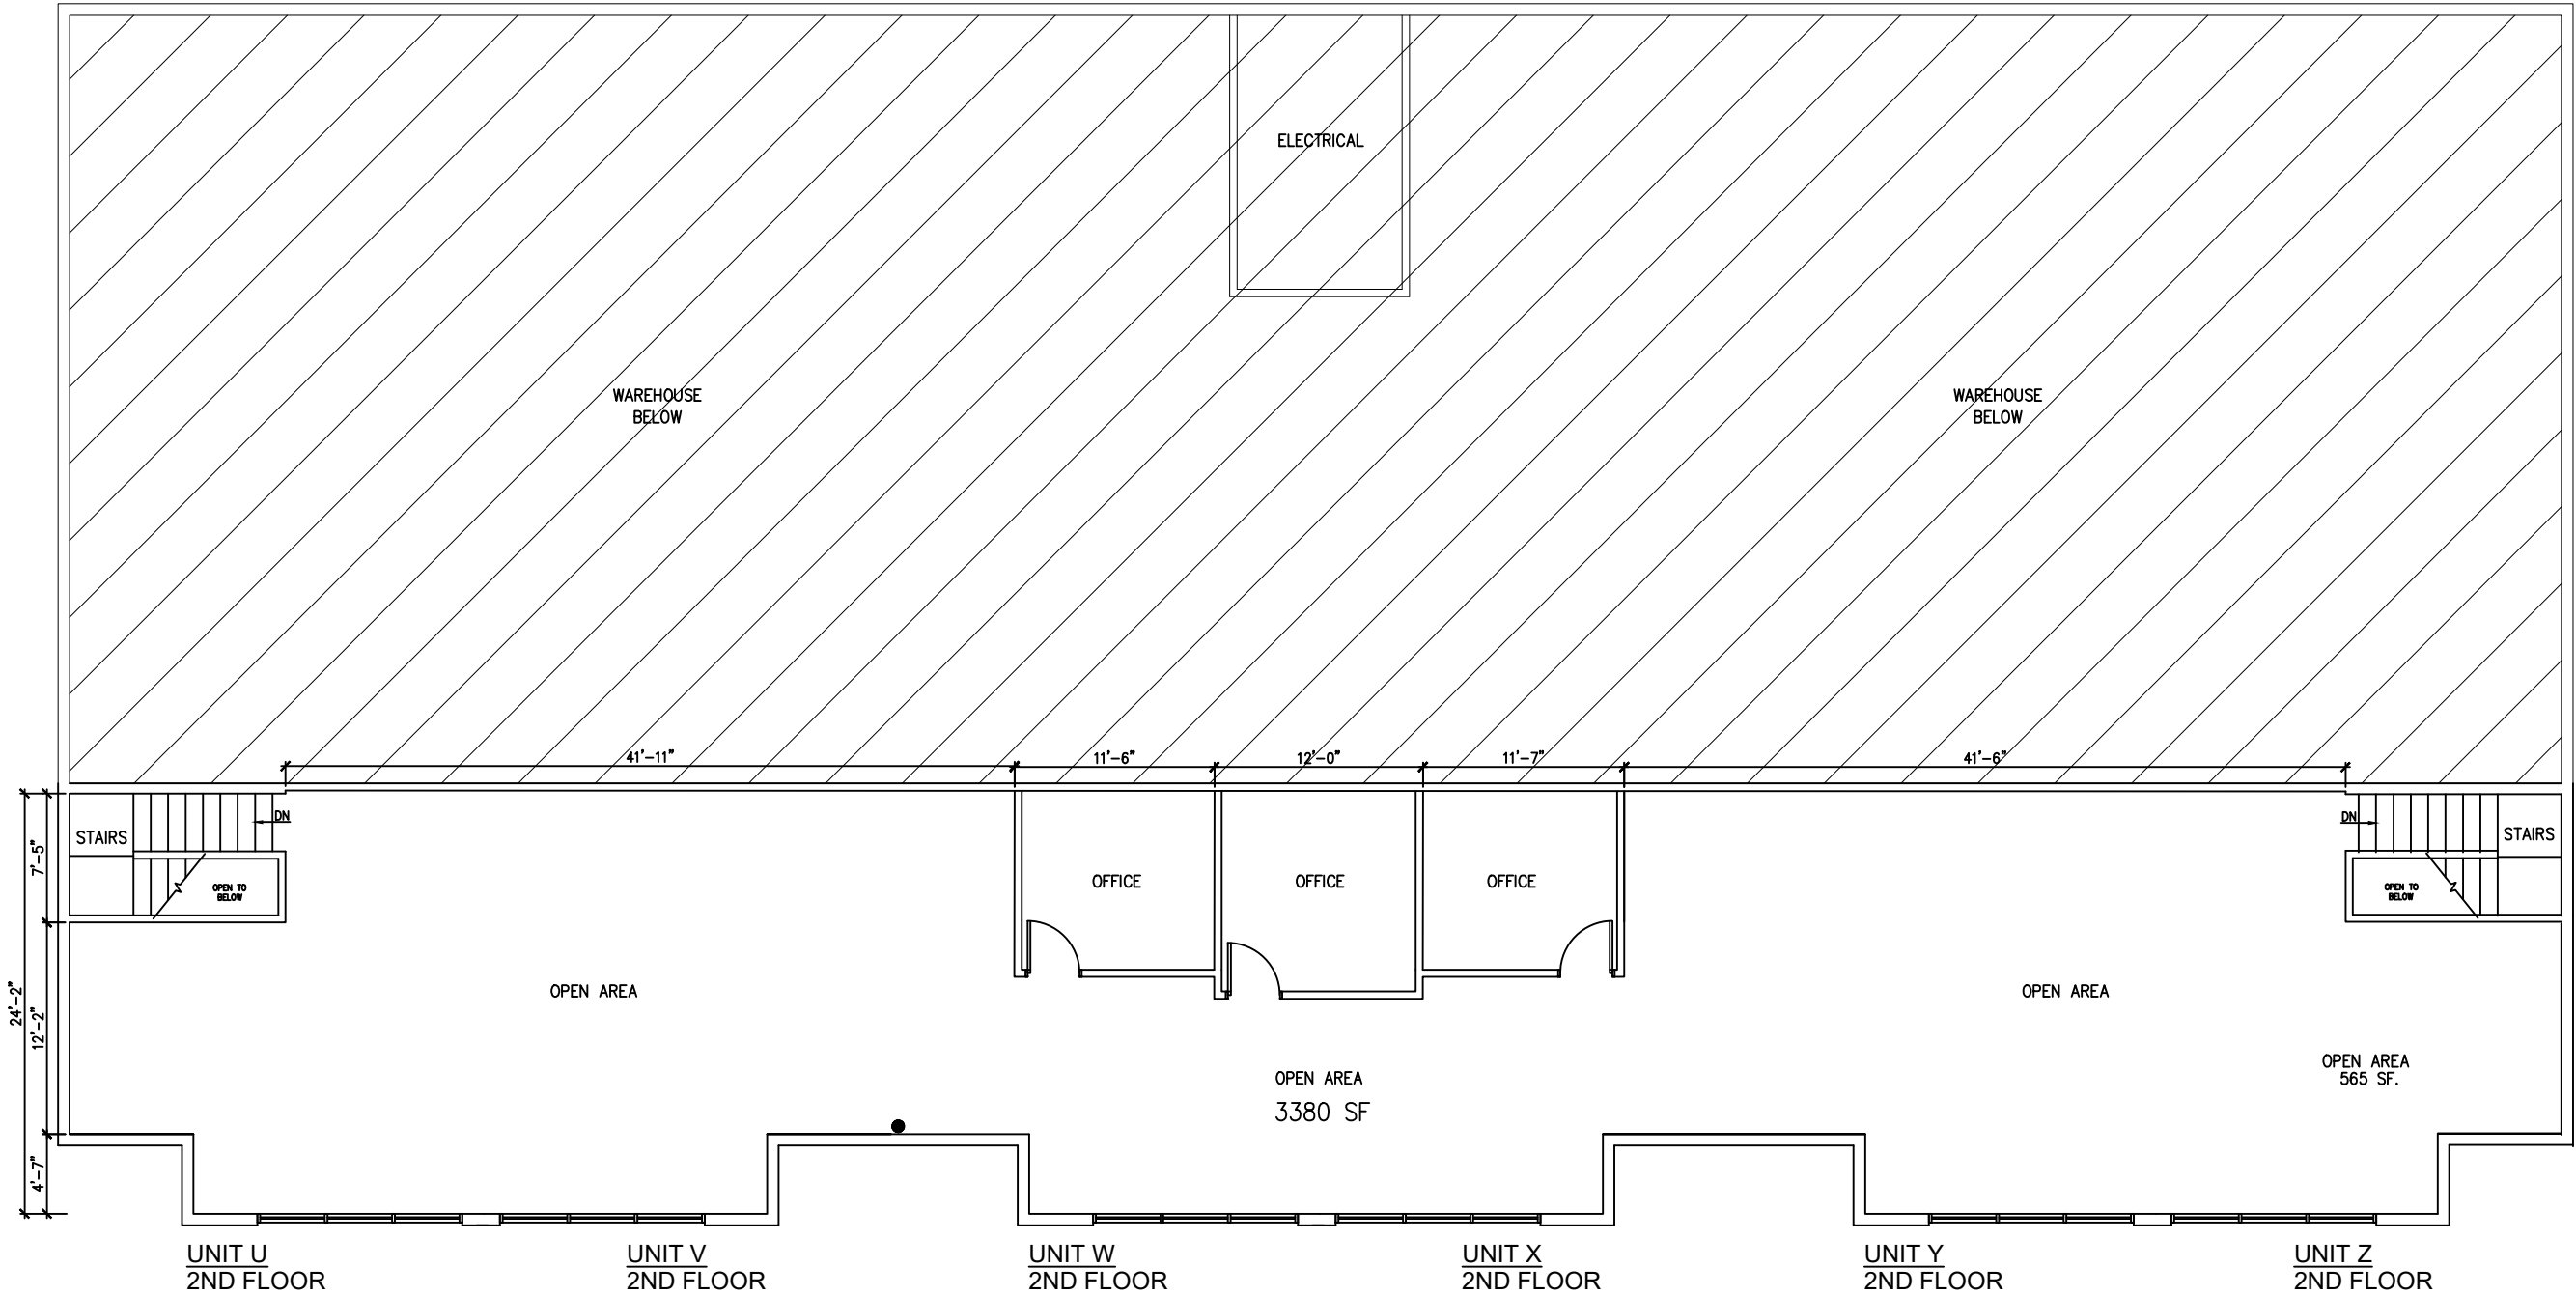

AGOURA BUSINESS CENTER
UNITS U-Z
5304 DERRY AVE
AGOURA HILLS, CA

2ND FLOOR
AS-BUILT
PLAN

Title: AS-BUILT PLAN
Drawn by: J. Burditt
Scale: 3/32"=1'
Date: 12.02.20

BURDITT DESIGNS
COMMERCIAL & RESIDENTIAL INTERIORS

MAIN 805-501-6399 FAX 805-529-3400