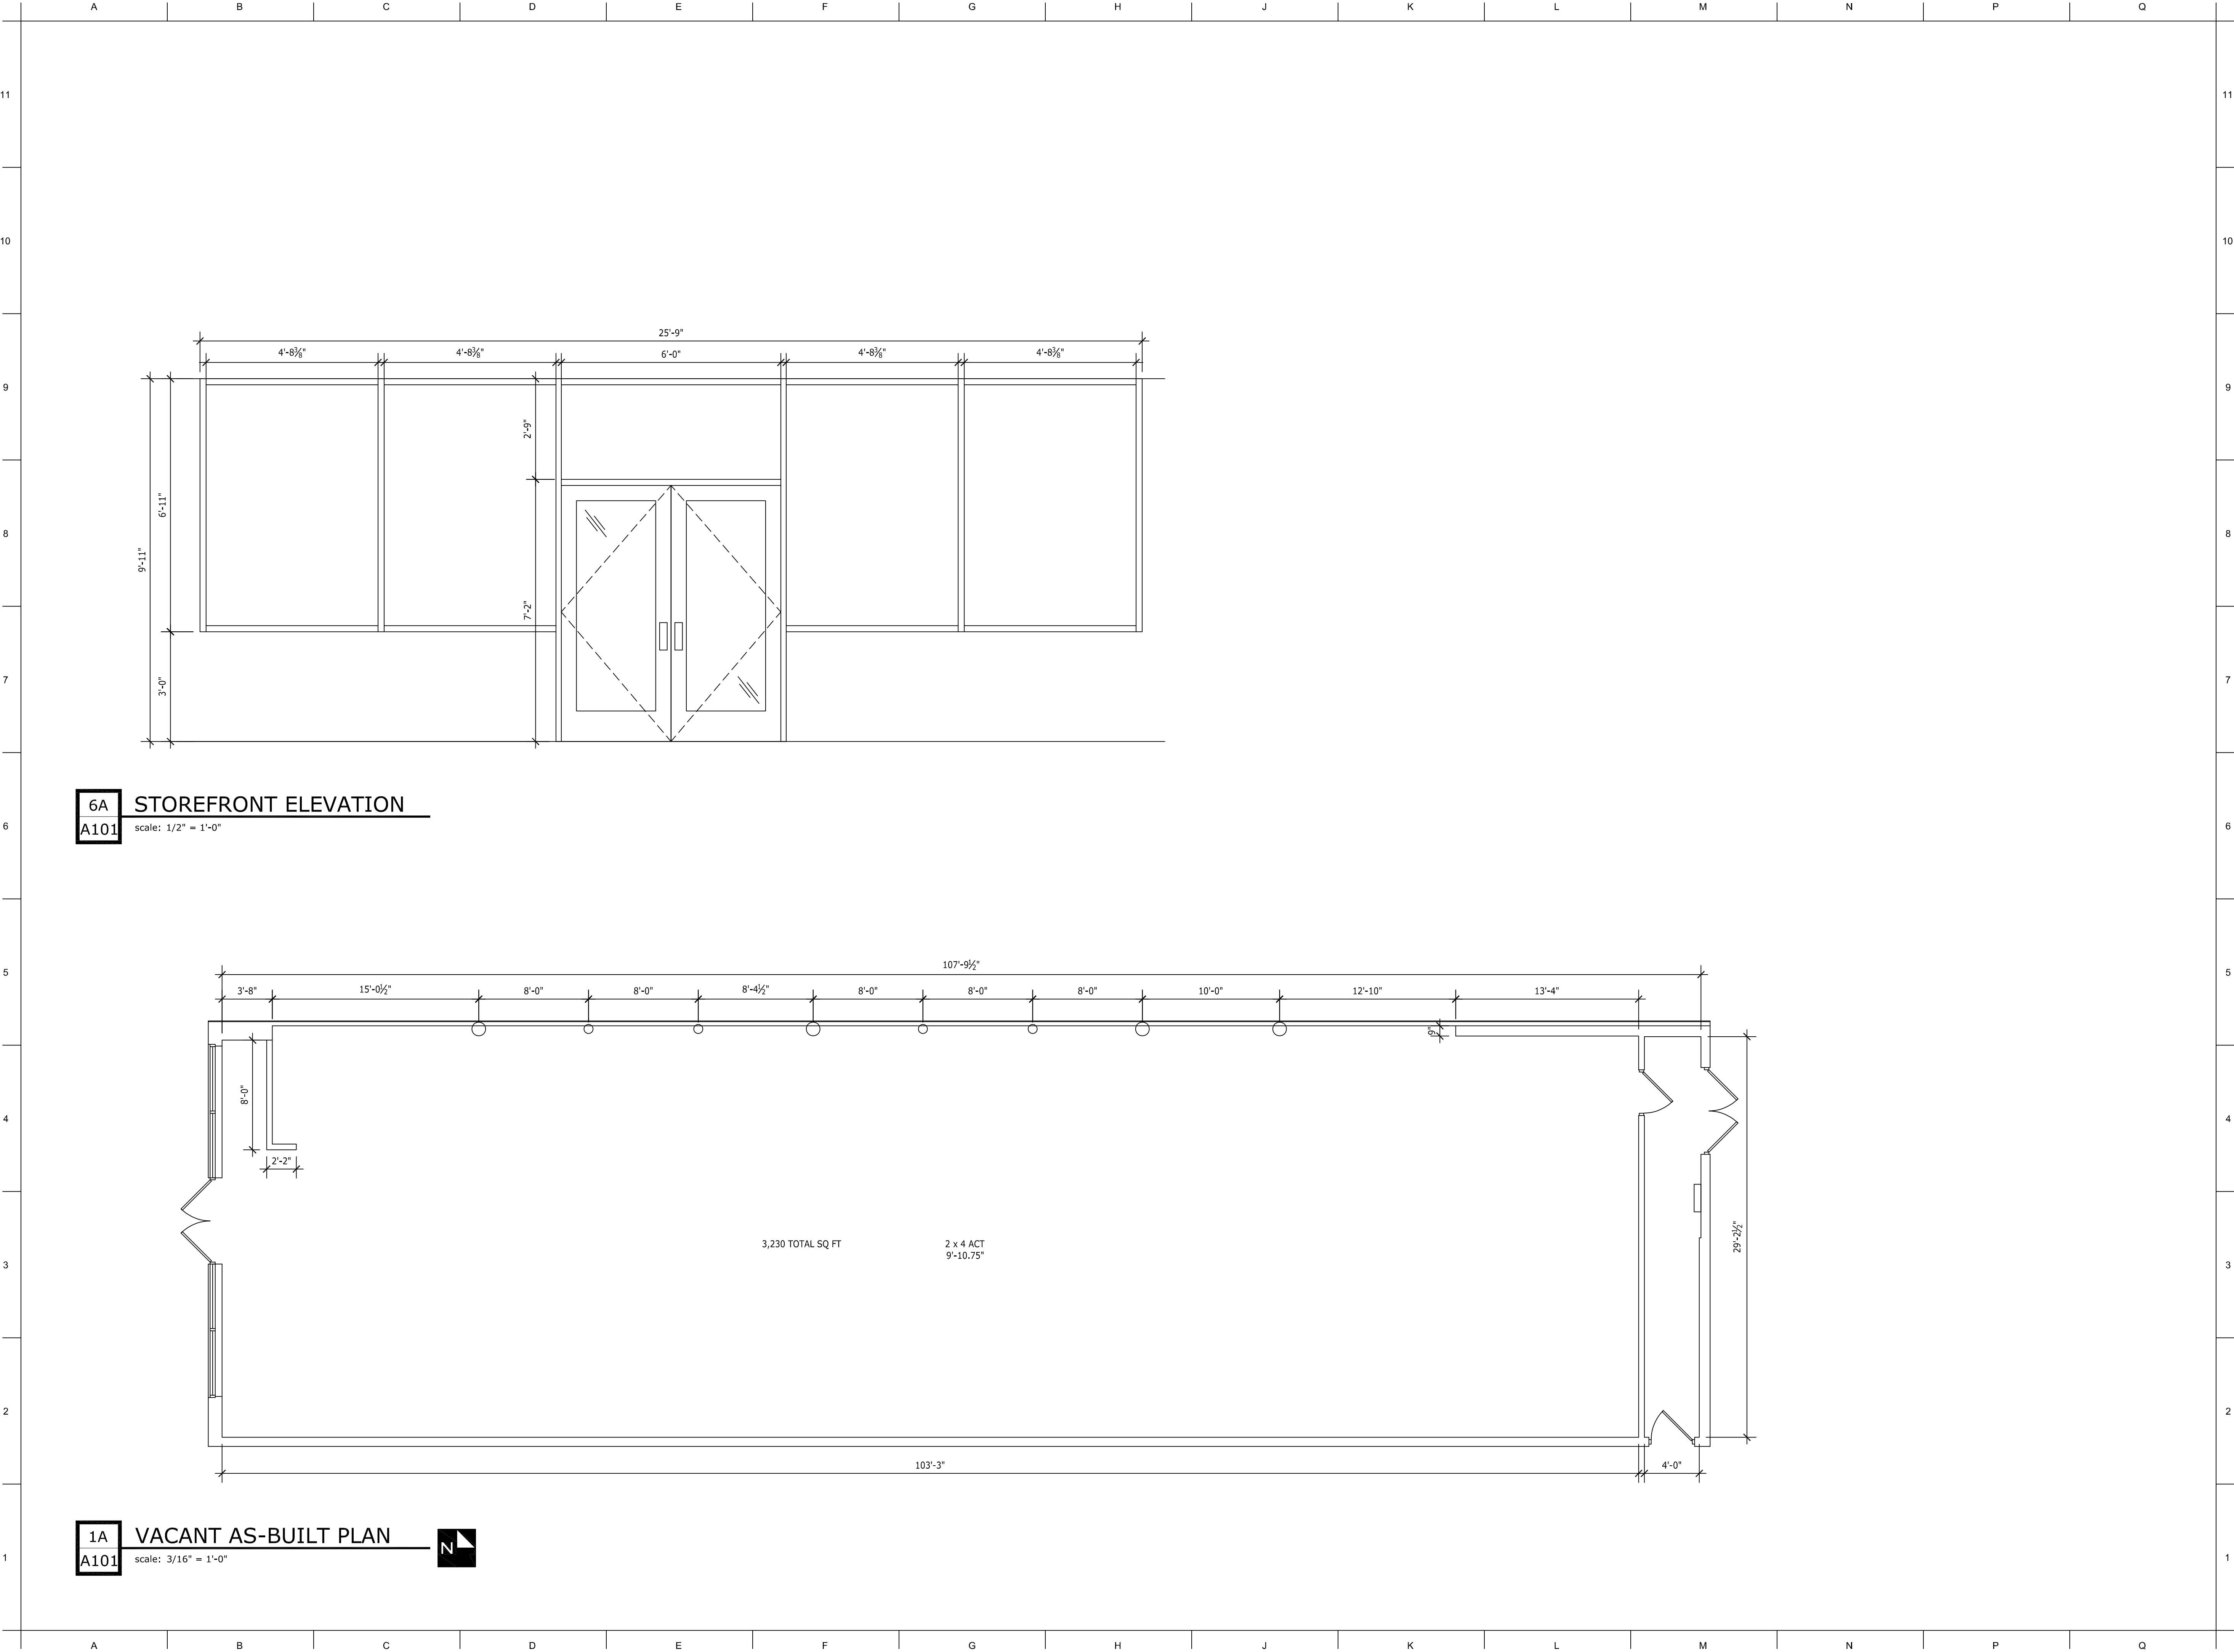


hdesigngroup
architecture + design

5039 S National Avenue | Springfield, MO 65810 | 417.887.6595

OWNER
LEE COWDEN

PROJECT TEAM

MEP ENGINEER
CJD ENGINEERING, LLC
2225 WEST CHESTERFIELD STREET, SUITE 200
SPRINGFIELD, MO 65807
417.877.1700

STRUCTURAL ENGINEER
METTEMAYER ENGINEERING, LLC
2225 WEST CHESTERFIELD STREET #300
SPRINGFIELD, MO 65807
417.890.8002

PROFESSIONAL SEAL

BRENT M. STEVENS, AIA - Architect
KENTUCKY #8822

REVISIONS

NO.	DESCRIPTION	DATE

© 2026 H DESIGN GROUP, LLC
THIS DRAWING AND THE ARCHITECTURAL WORK REPRESENTED ARE OWNED BY H DESIGN GROUP, LLC. COPYRIGHT INCLUDES THIS DRAWING, AS WELL AS ALL COMPONENTS OF THE CONCEPTUAL DESIGN. REPRODUCTION OF ANY KIND IS STRICTLY PROHIBITED WITHOUT THE EXPRESSED WRITTEN CONSENT OF H DESIGN GROUP, LLC.

PROJECT TITLE
VACANT UNIT - AS-BUILTS

PROJECT ADDRESS:
2734 FREDERICA ST.,
OWENSBORO, KY 42301

PROJECT NO.: 26-020
DRAWN BY: PCB
REVIEWED BY: BMS
DATE: 03-24-2026

SHEET
A101