




THE PORTRAIT  
BUILDING

ENTIRE 5TH FLOOR

24,911 RSF

Available Now | As-Built Plan

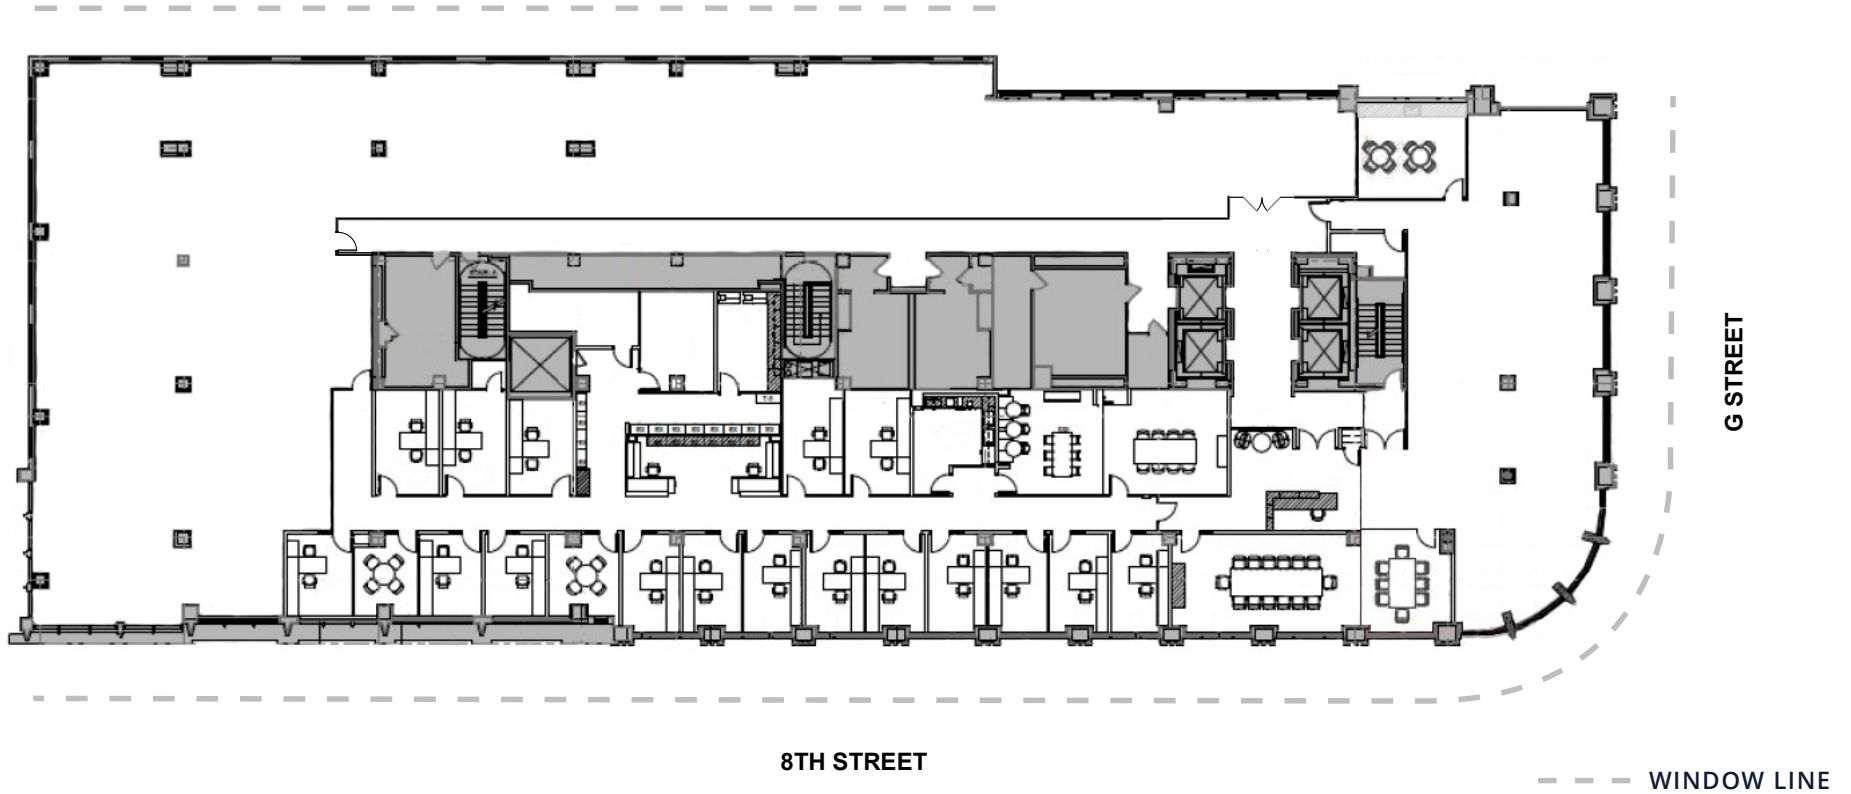

AVISON  
YOUNG

 **Douglas  
Development**  
CORPORATION