


AS-BUILT

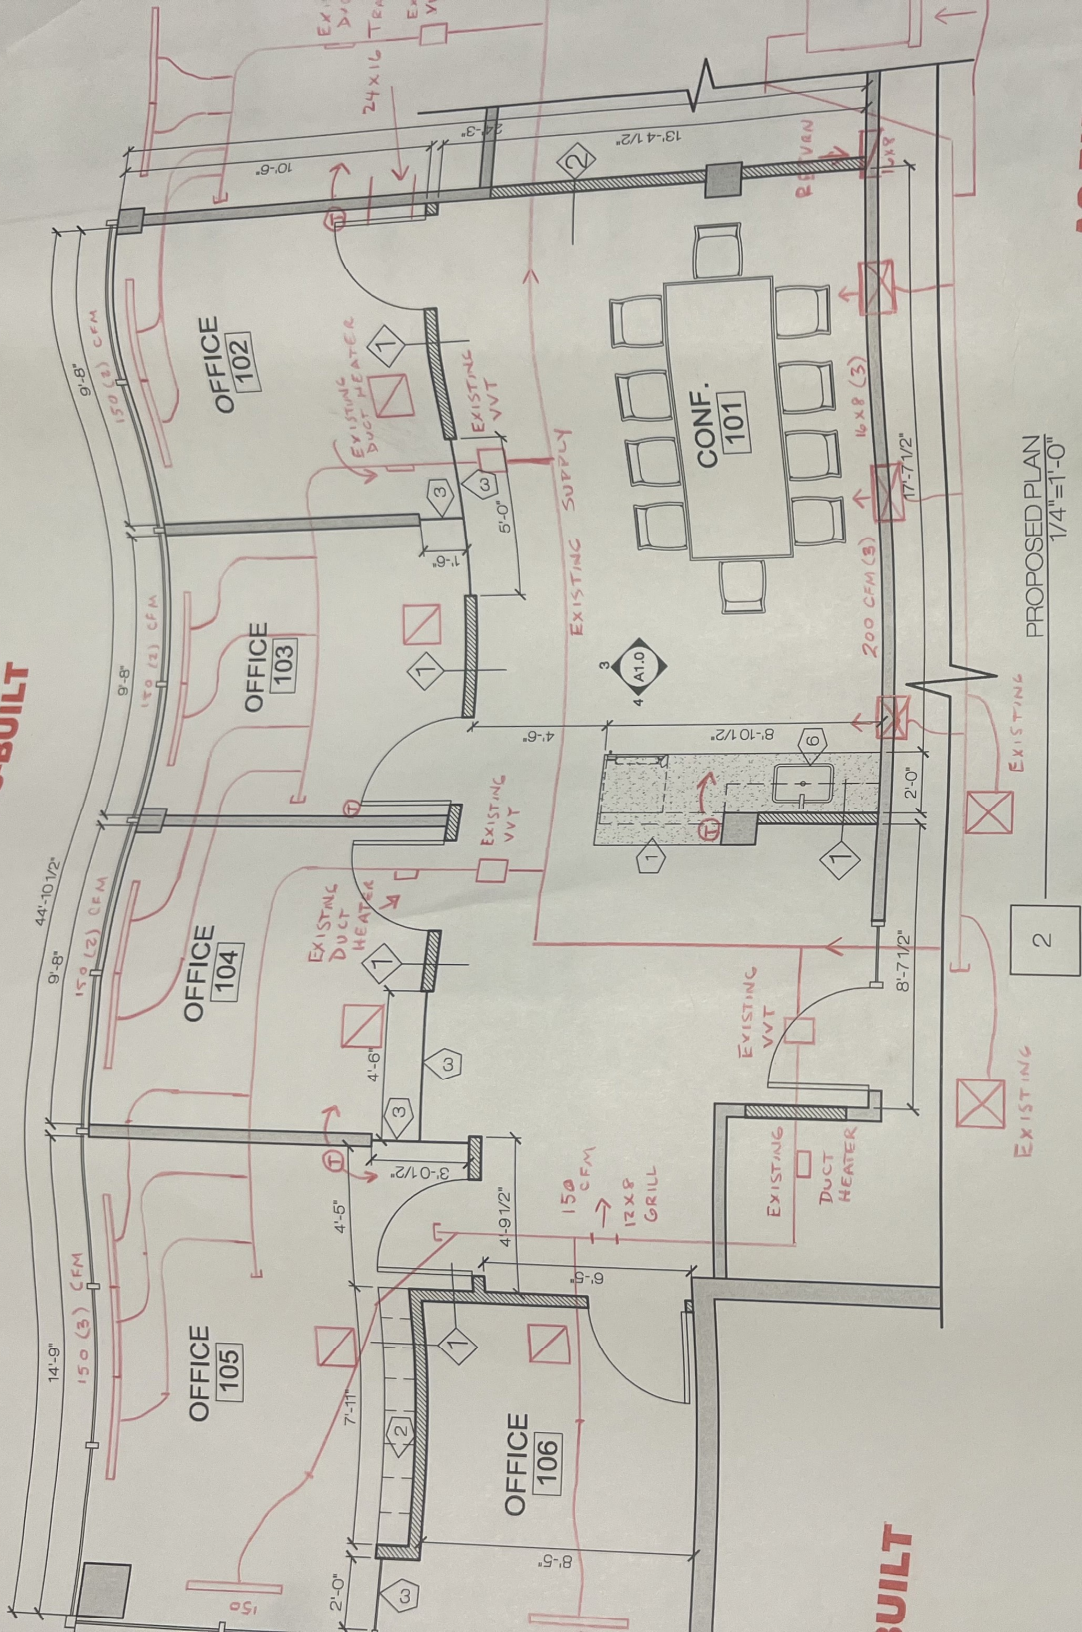


AS-BUILT

PROPOSED PLAN
1/4"=1'-0"

EXISTING

EXISTING

BUILT

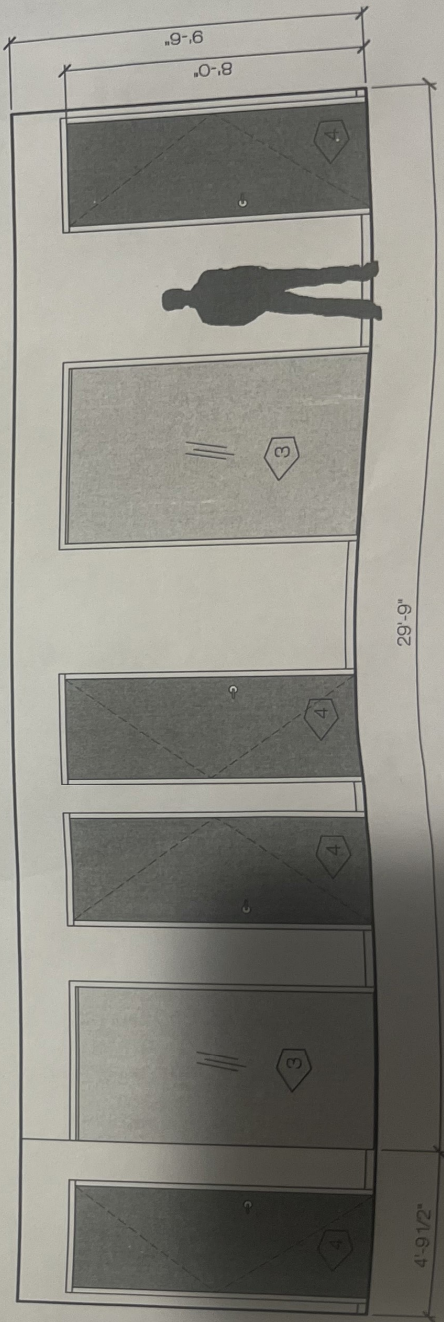

ELEVATION @ WALL
1/4"=1'-0"

ADA COUNTER-HEIGHT
COMPLIANT
UNDERCOUNTER
REFRIGERATOR

NETTE
1/4"=1'-0"