

Property Key



Starkey As Built Marketing Package

12505 Starkey Road, Largo, FL 33773

Building: 12505


Suite: N

Sheet: A-9



BAY SPACE

Scale: Not to Scale
Sheet Size: 8.5" x 11"
Not For Construction

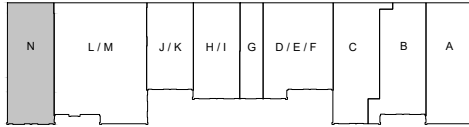

Total Area - 6,500 SF

Building Information

DECK HEIGHT:	13'-8"
CEILING HEIGHT:	10'-0"
CLEAR HEIGHT:	12'-3"
SPRINKLERED:	Yes

