
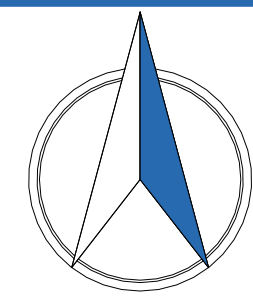


Property Key

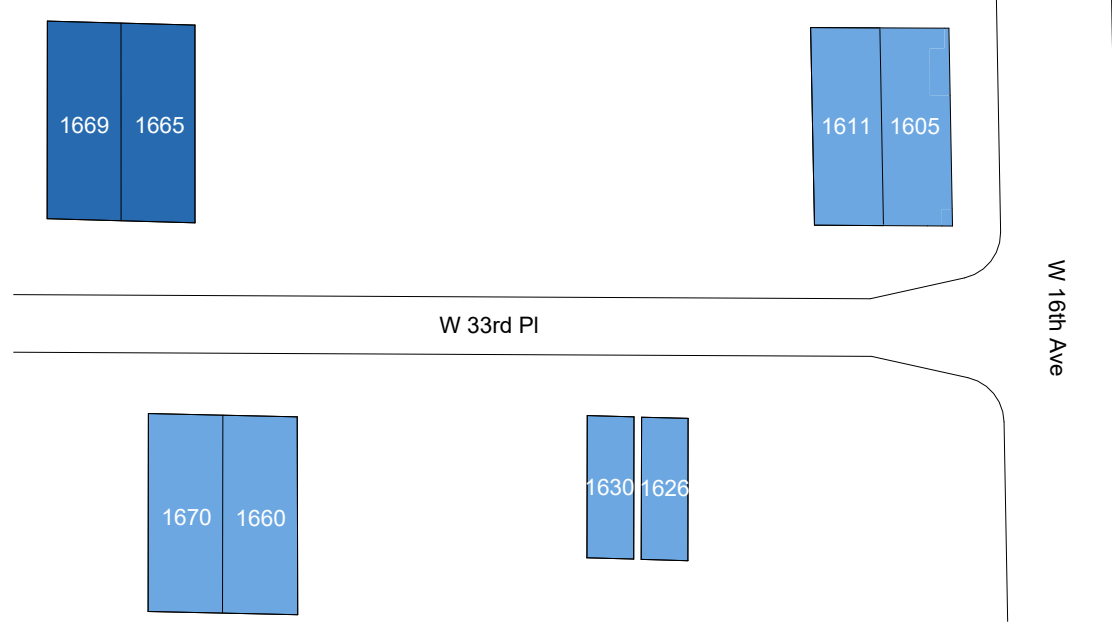


Hialeah Buildings

1669 - 1665 W 33rd St. Hialeah, FL 33012

Building: 23

Suite: 1669-1665

Sheet **E1**

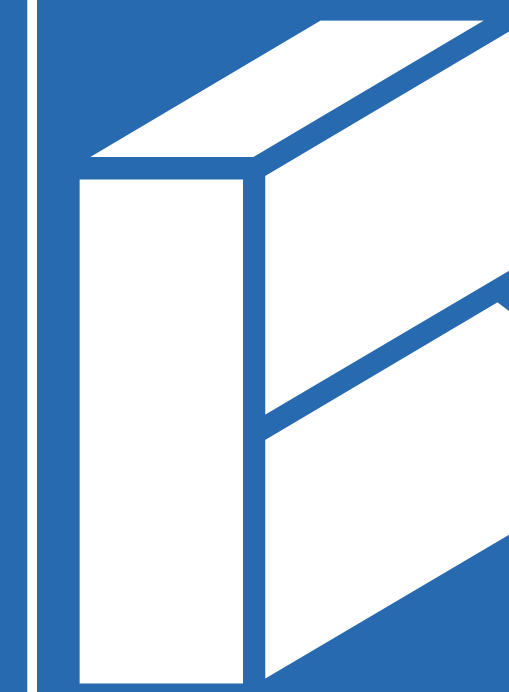

BAY SPACE


Scale: Not to Scale
Sheet Size: 42" x 30"
Not For Construction

Usable Square Foot Analysis

	SQFT	BUILDING PERCENTAGE
Office Area	0	0 %
Warehouse Area	8000	100 %
Total Area	8,000	

Building Information

Deck Height:	18' - 0 3/4"
Clear Height:	16' - 1"
Ceiling Height:	7' - 10 1/2"
Sprinklered:	<input type="checkbox"/> Yes <input checked="" type="checkbox"/> No
Mechanical Area:	0 SQFT

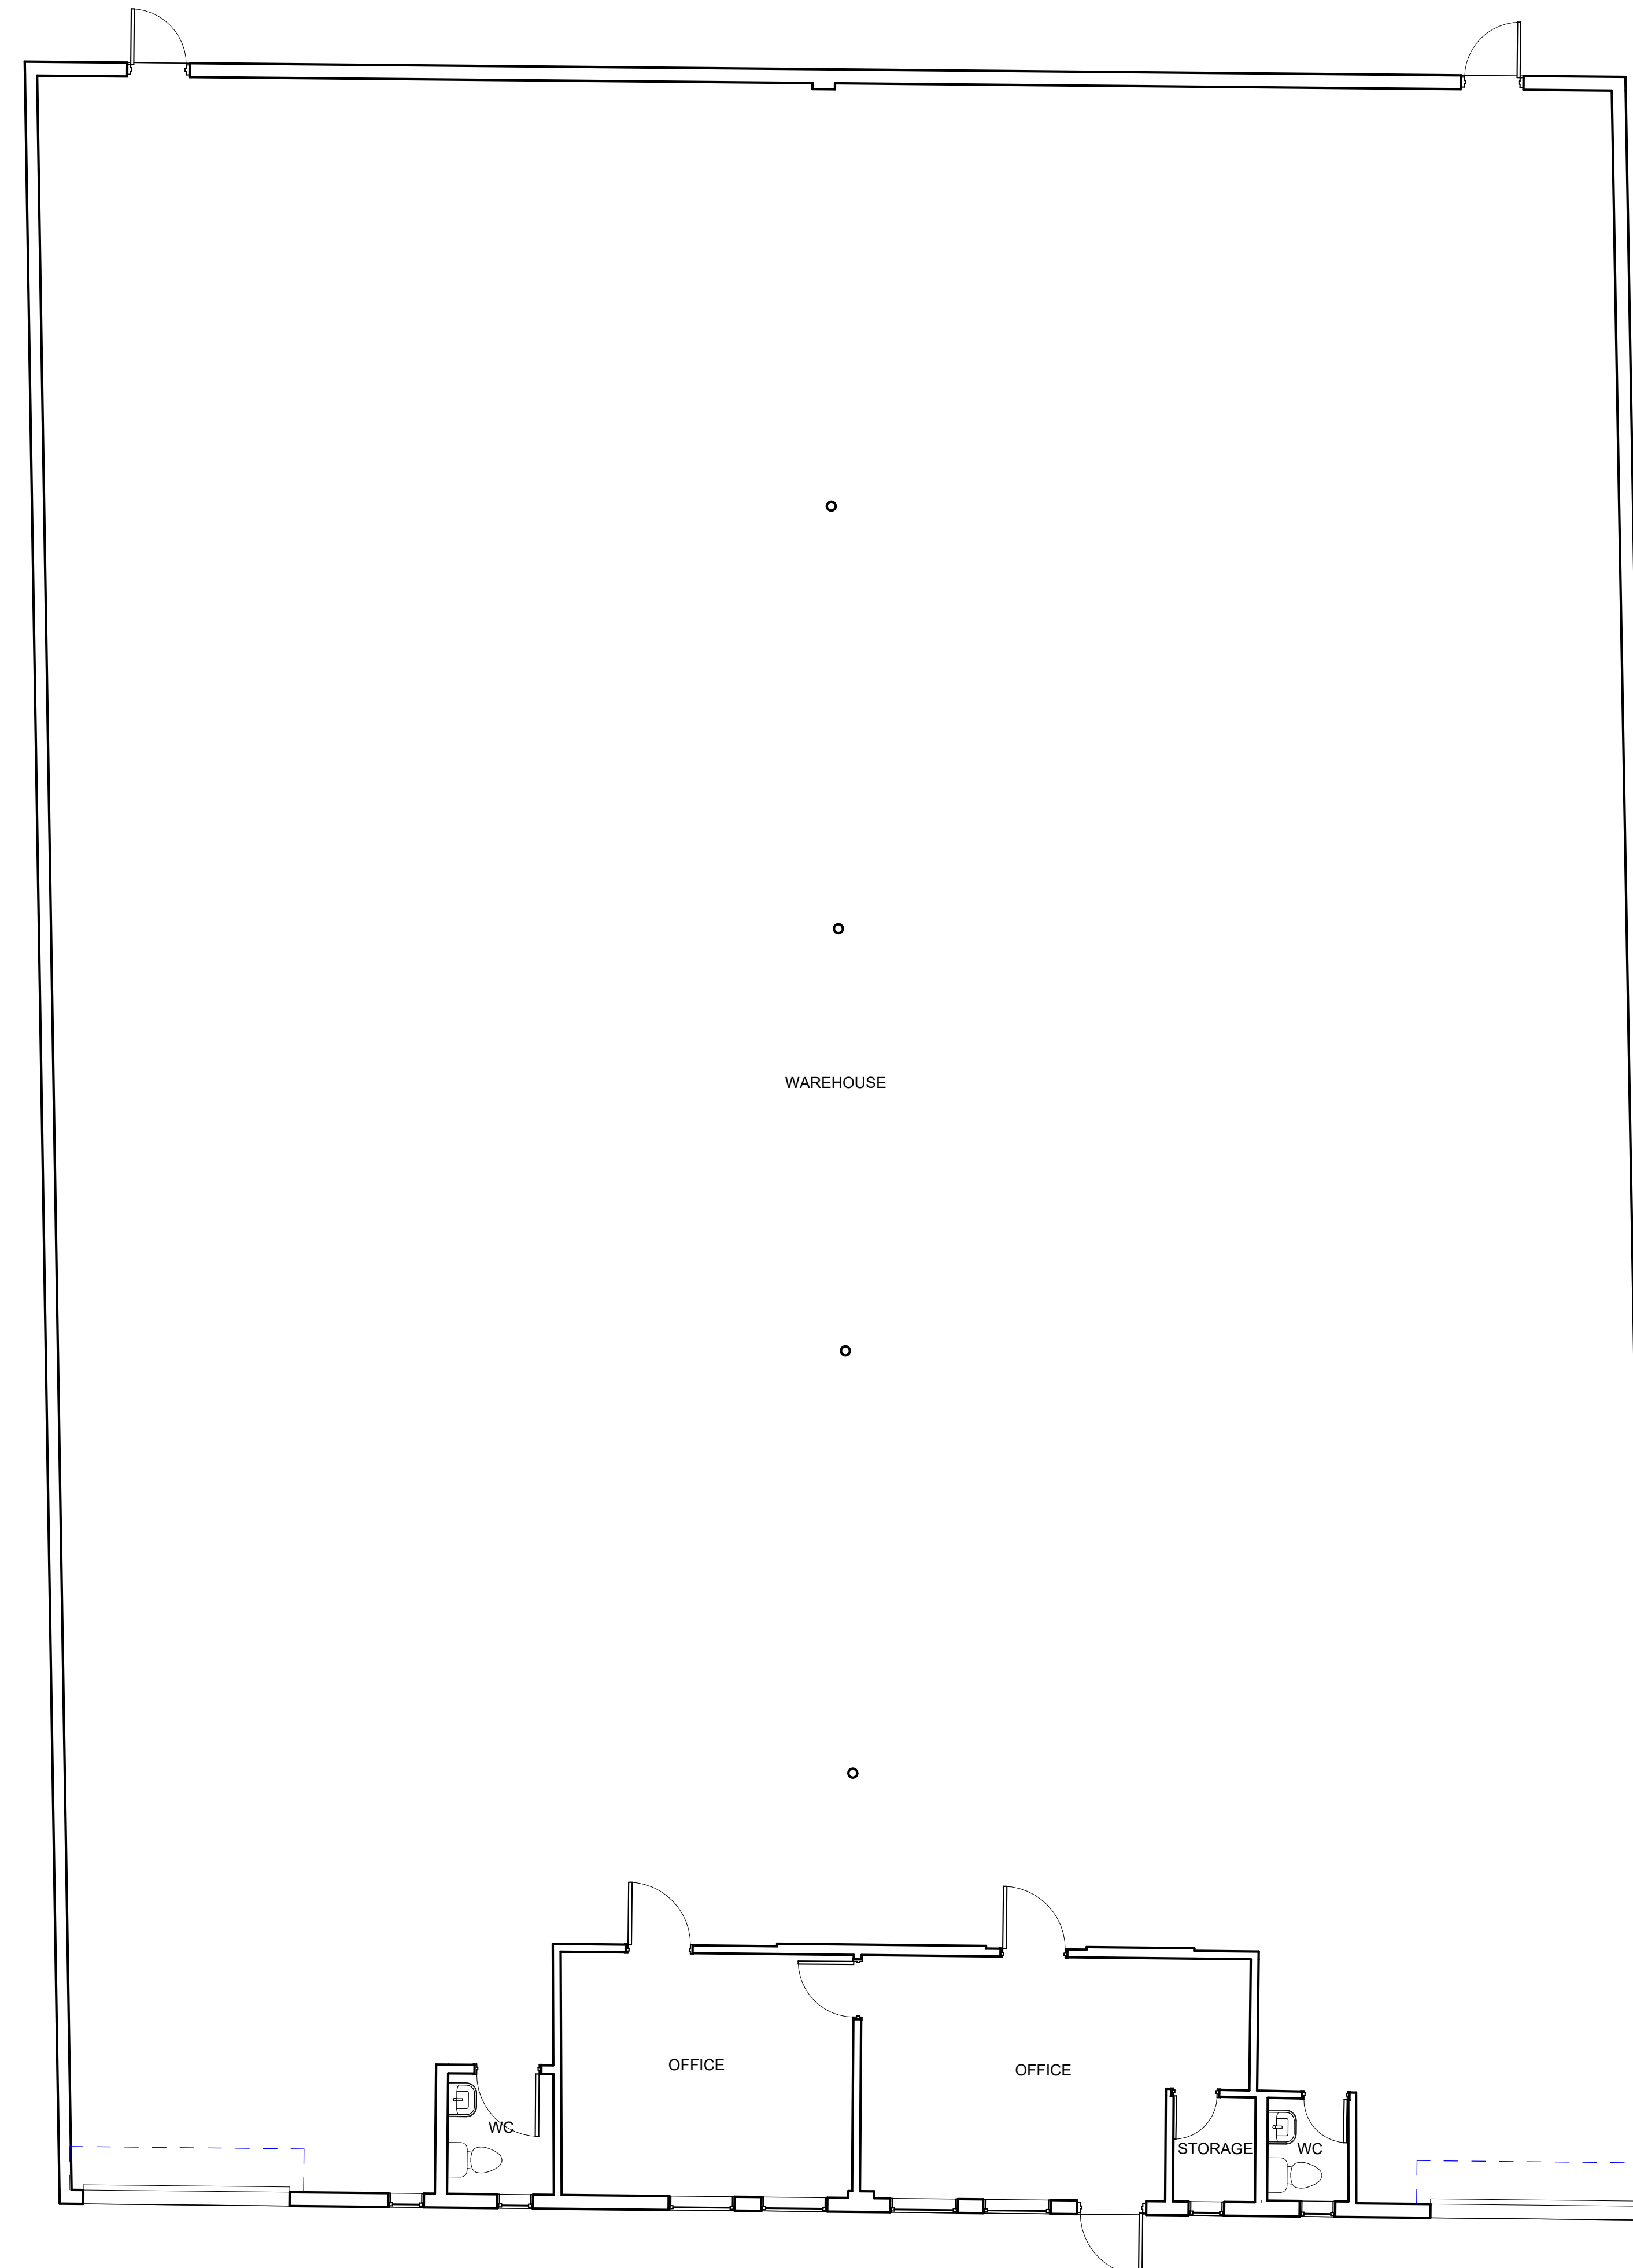

① 1669 - 1665
3/16" = 1'-0"

As Built Floor Plan for Marketing

