


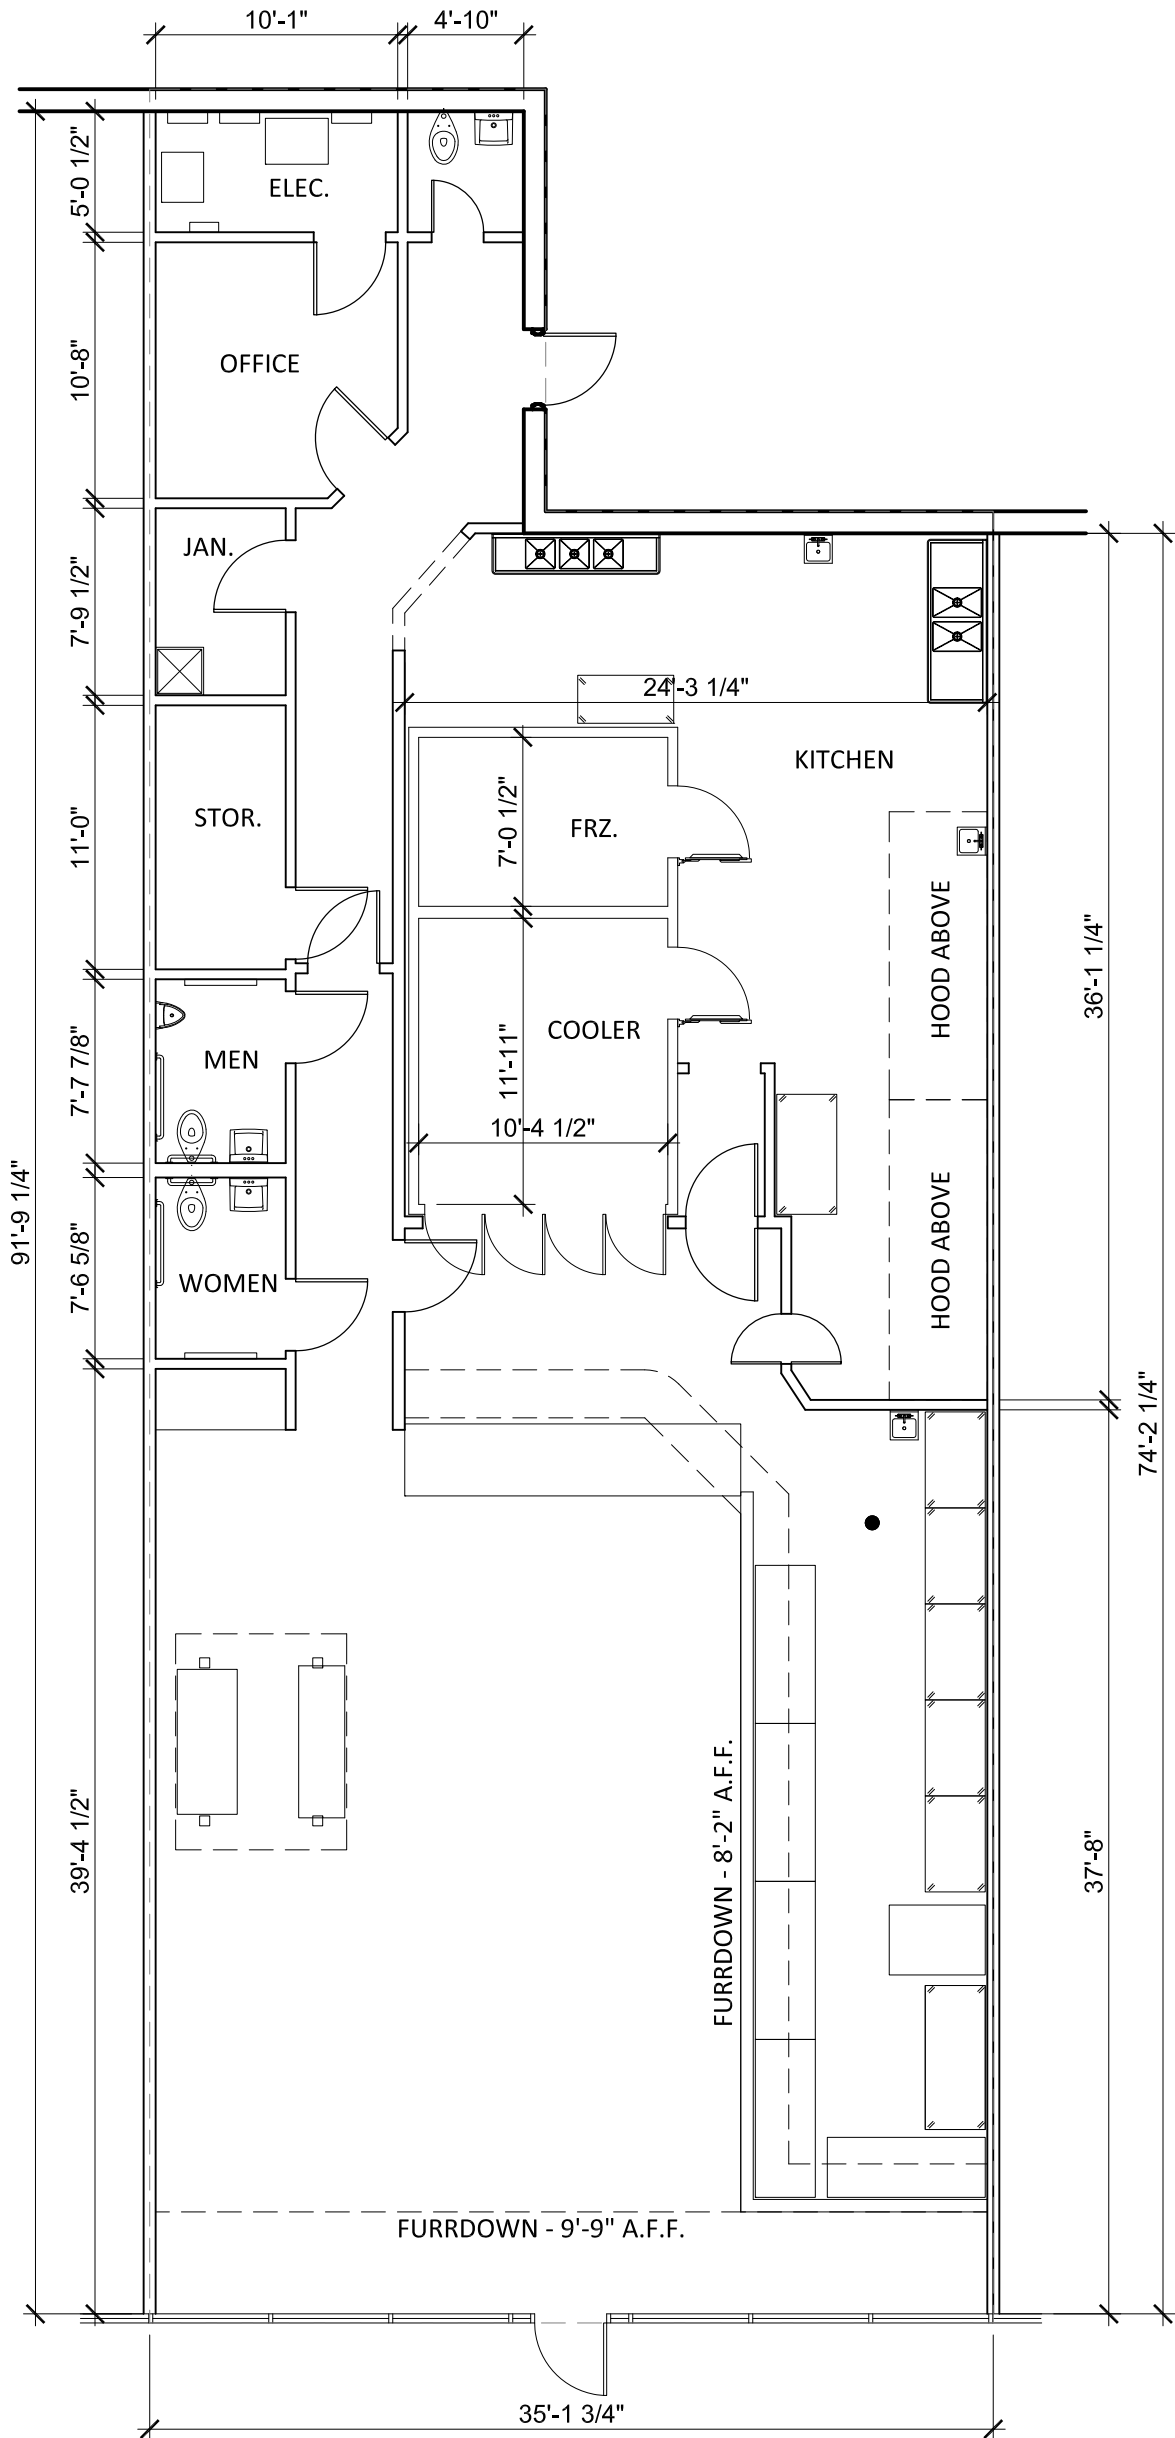

LEASE AREA: 2,942 SF
9'-9-1/4" CEILINGS THROUGHOUT

01 FLOOR PLAN
SCALE: 1/8" = 1'-0"