


# Property Key

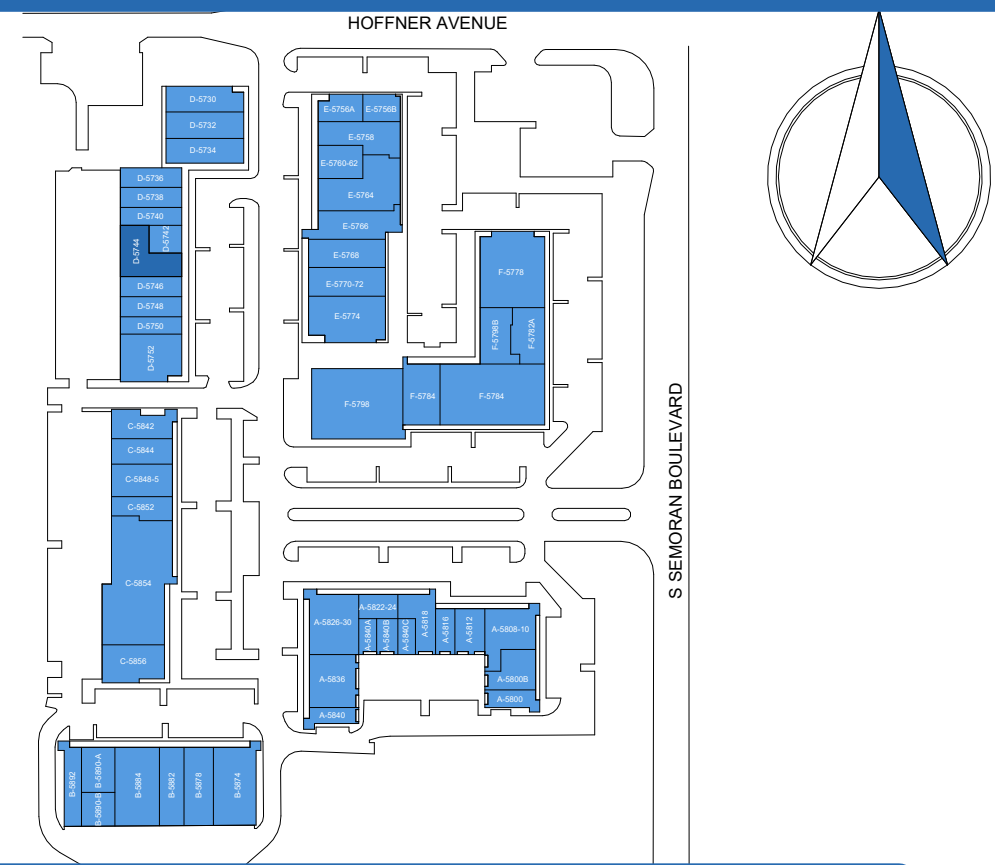


# OBIC As Built Marketing Package

5730-5892 S Semoran Blvd, Orlando, FL 32809, US

Building Number: 5730

Suite: 5744

Sheet **E1**

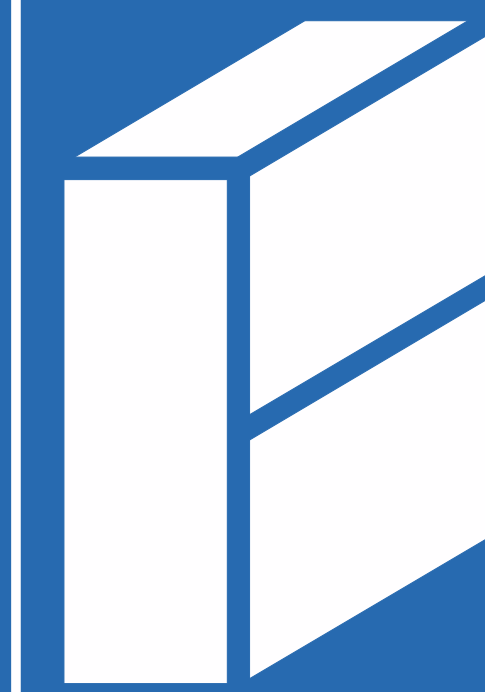

# BAY SPACE

Scale: Not to Scale  
Sheet Size: 42" x 30"  
Not For Construction

## Usable Square Foot Analysis

Office Area	3,859	100 %
Warehouse Area	0	0%
Total Area	3,859	

## Building Information

Deck Height:	15' - 5"
Clear Height:	8' - 10"
Ceiling Height:	8' - 10"
Sprinklered:	<input type="checkbox"/> Yes <input checked="" type="checkbox"/> No
Mechanical Area:	0 SQFT

