

1 FIRST FLOOR PLAN
1/8" = 1'-0"


NOTES:

1. ALL DOORS TO BE 3/0x7/0 U.N.O.
2. PROVIDE WALL OR FLOOR BUMPERS WHERE APPLICABLE.
3. APPLY WEATHER STRIPPING AND SWEEPS TO ALL EXTERIOR DOORS.
4. PROVIDE UL LABELED HARDWARE ON ALL DOORS IN RATED WALLS.
5. ALL OPERATING HARDWARE TO HAVE LEVER OPERATOR DESIGN, U.N.O.. RHODES FINISH SATIN CHROMIUM PLATED
6. PROVIDE HAZARD WARNINGS FOR VISUALLY IMPAIRED ON MECHANICAL ROOM DOOR HANDLES.
7. SPRING HINGES ARE NOT ACCEPTABLE SUBSTITUTES FOR SPECIFIED DOOR CLOSURES.
8. PROVIDE STEEL STRUCTURE OR P.T. BLOCKING FOR OVERHEAD DOOR ATTACHMENT AS REQ. BY MANUF.
9. ALL EXTERIOR GLAZING TO BE THERMAL PANE IN WINDOWS & DOORS
10. EXTERIOR WINDOWS TO HAVE THERMALLY BROKEN FRAMES

NOTE: DIMENSIONS ARE STUD TO STUD.

PLOTTED ON: 2/27/2025 8:49:35 AM
 Z:\2413-JAG WAWRLA\21600SF BLDG\CURRENT DRAWINGS\2413-JAG WAWRLA 21600SF BLDG 25-0224 AS-BUILT.rvt

PROJECT NORTH

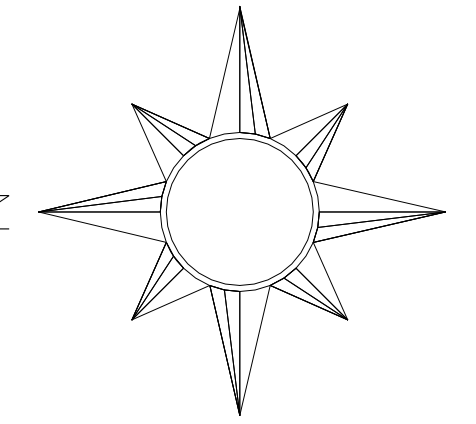

"AS-BUILT DRAWINGS"
 THESE DOCUMENTS HAVE BEEN PROVIDED BASED UPON ADDENDA, SHOP DRAWING REVIEW COMMENTS AND CHANGES DURING CONSTRUCTION. SOME OF THIS INFORMATION HAS BEEN PROVIDED BY OTHERS. THE CONSULTANT HAS NOT VERIFIED THE ACCURACY OR COMPLETENESS OF THIS INFORMATION AND SHALL NOT BE RESPONSIBLE FOR ANY ERRORS OR OMISSIONS THAT MAY BE INCORPORATED AS A RESULT OF ERRONEOUS INFORMATION PROVIDED BY OTHERS.



950 LOUDON RD LATHAM, NY 12110
 T: 518-783-1663 F: 518-786-8294
 WWW.COTLERARCHITECTURE.COM

Copyright © 2025 Cotler Architecture, DPC

All reports, plans, specifications and computer files relating to this project are the property of Cotler Architecture, DPC. Cotler Architecture retains all common law, statute and other reserved rights including the copyright thereto. Reproduction of the material herein or substantial use without written permission of Cotler Architecture, DPC violates the copyright law of The United States and will be subject to legal prosecution.

PROJECT:
 PROPOSED METAL BUILDING
 BUILDING 1 - 21,600 SF
 JAG WAWRLA
 21ST CENTURY PARK DR, 1315 ROUTE
 146 CLIFTON PARK, NY 12065

DRAWING:
 GROUND FLOOR PLAN

SCALE: 1/8" = 1'-0"

DATE: 02/25/2025

DRAWN BY: SM

CHECKED BY: DG

REVISIONS:

PROJECT NO:

2413

DRAWING NO:

A100