



Adjacent Building

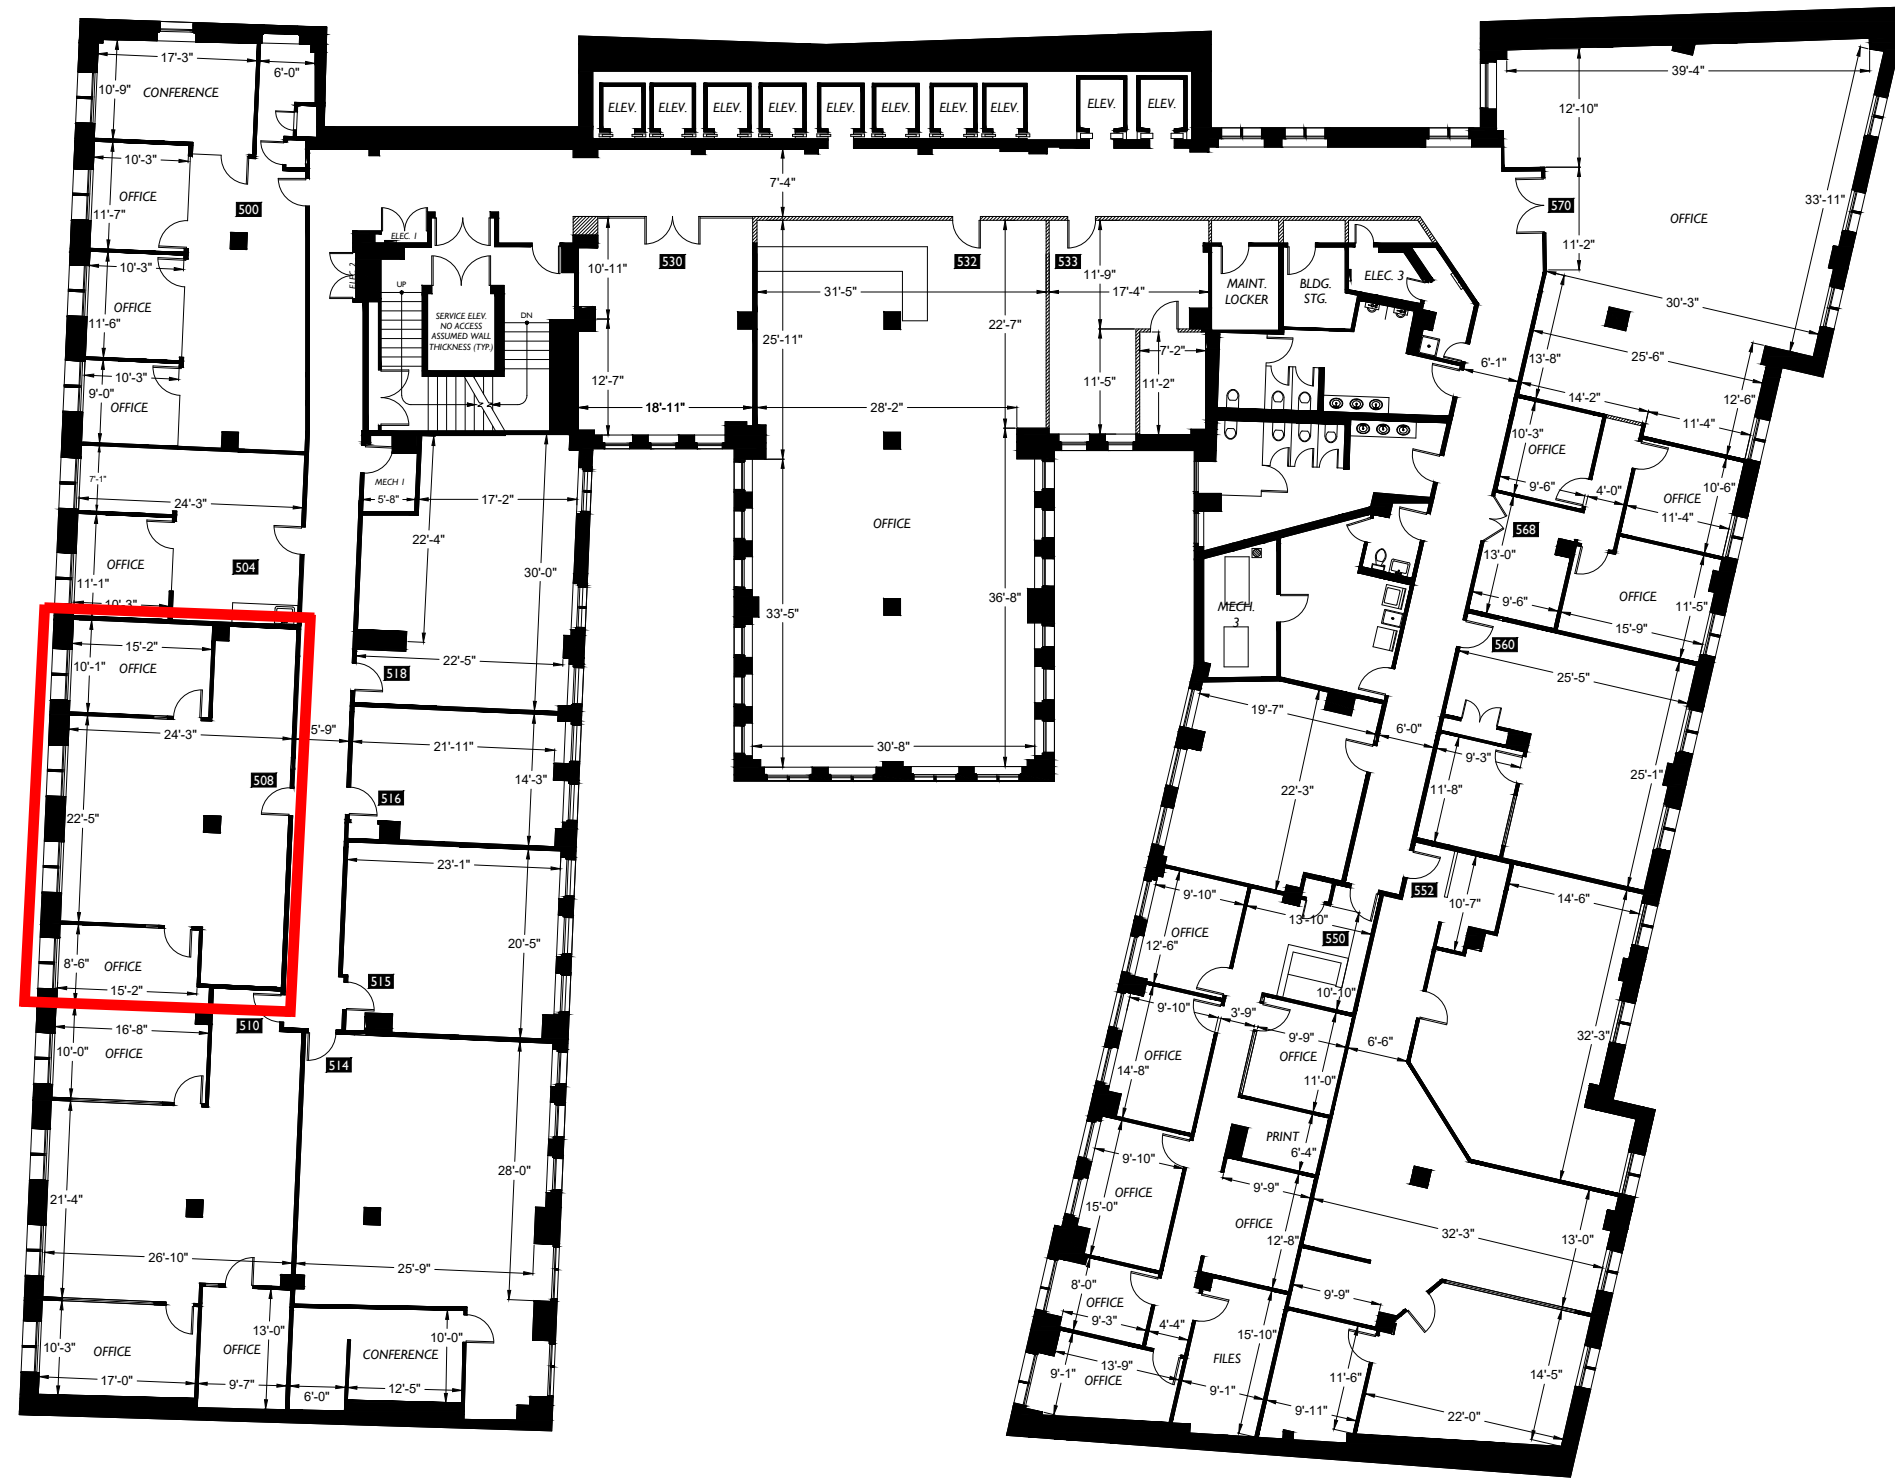

Adjacent Building

Greenwich Street

Broadway

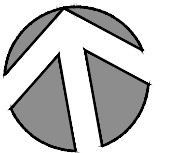


Braun Management, Inc.
 160 Broadway, First Floor
 New York, NY 10038

Office Building
 11 Broadway
 New York, NY 10004

Subject

Floor Plan
5
Floor

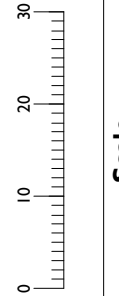

Scale

2DFLOORPLANS.COM
 206-328-7410
2-D
 AS-BUILT
 FLOOR PLANS
 371 NE Gilman Blvd., Ste. 140
 Issaquah, WA 98027
 Measured: August 2017
 Project: C25-289