


KENMORE AVENUE

(80' WIDE) TOWN OF TONAWANDA

NORTH LINE OF LOT 66, T-12, R-7
CITY OF BUFFALO

ST MH RIM 651.69
INV 12" RCP W 642.54
INV 12" PVC SW 645.69

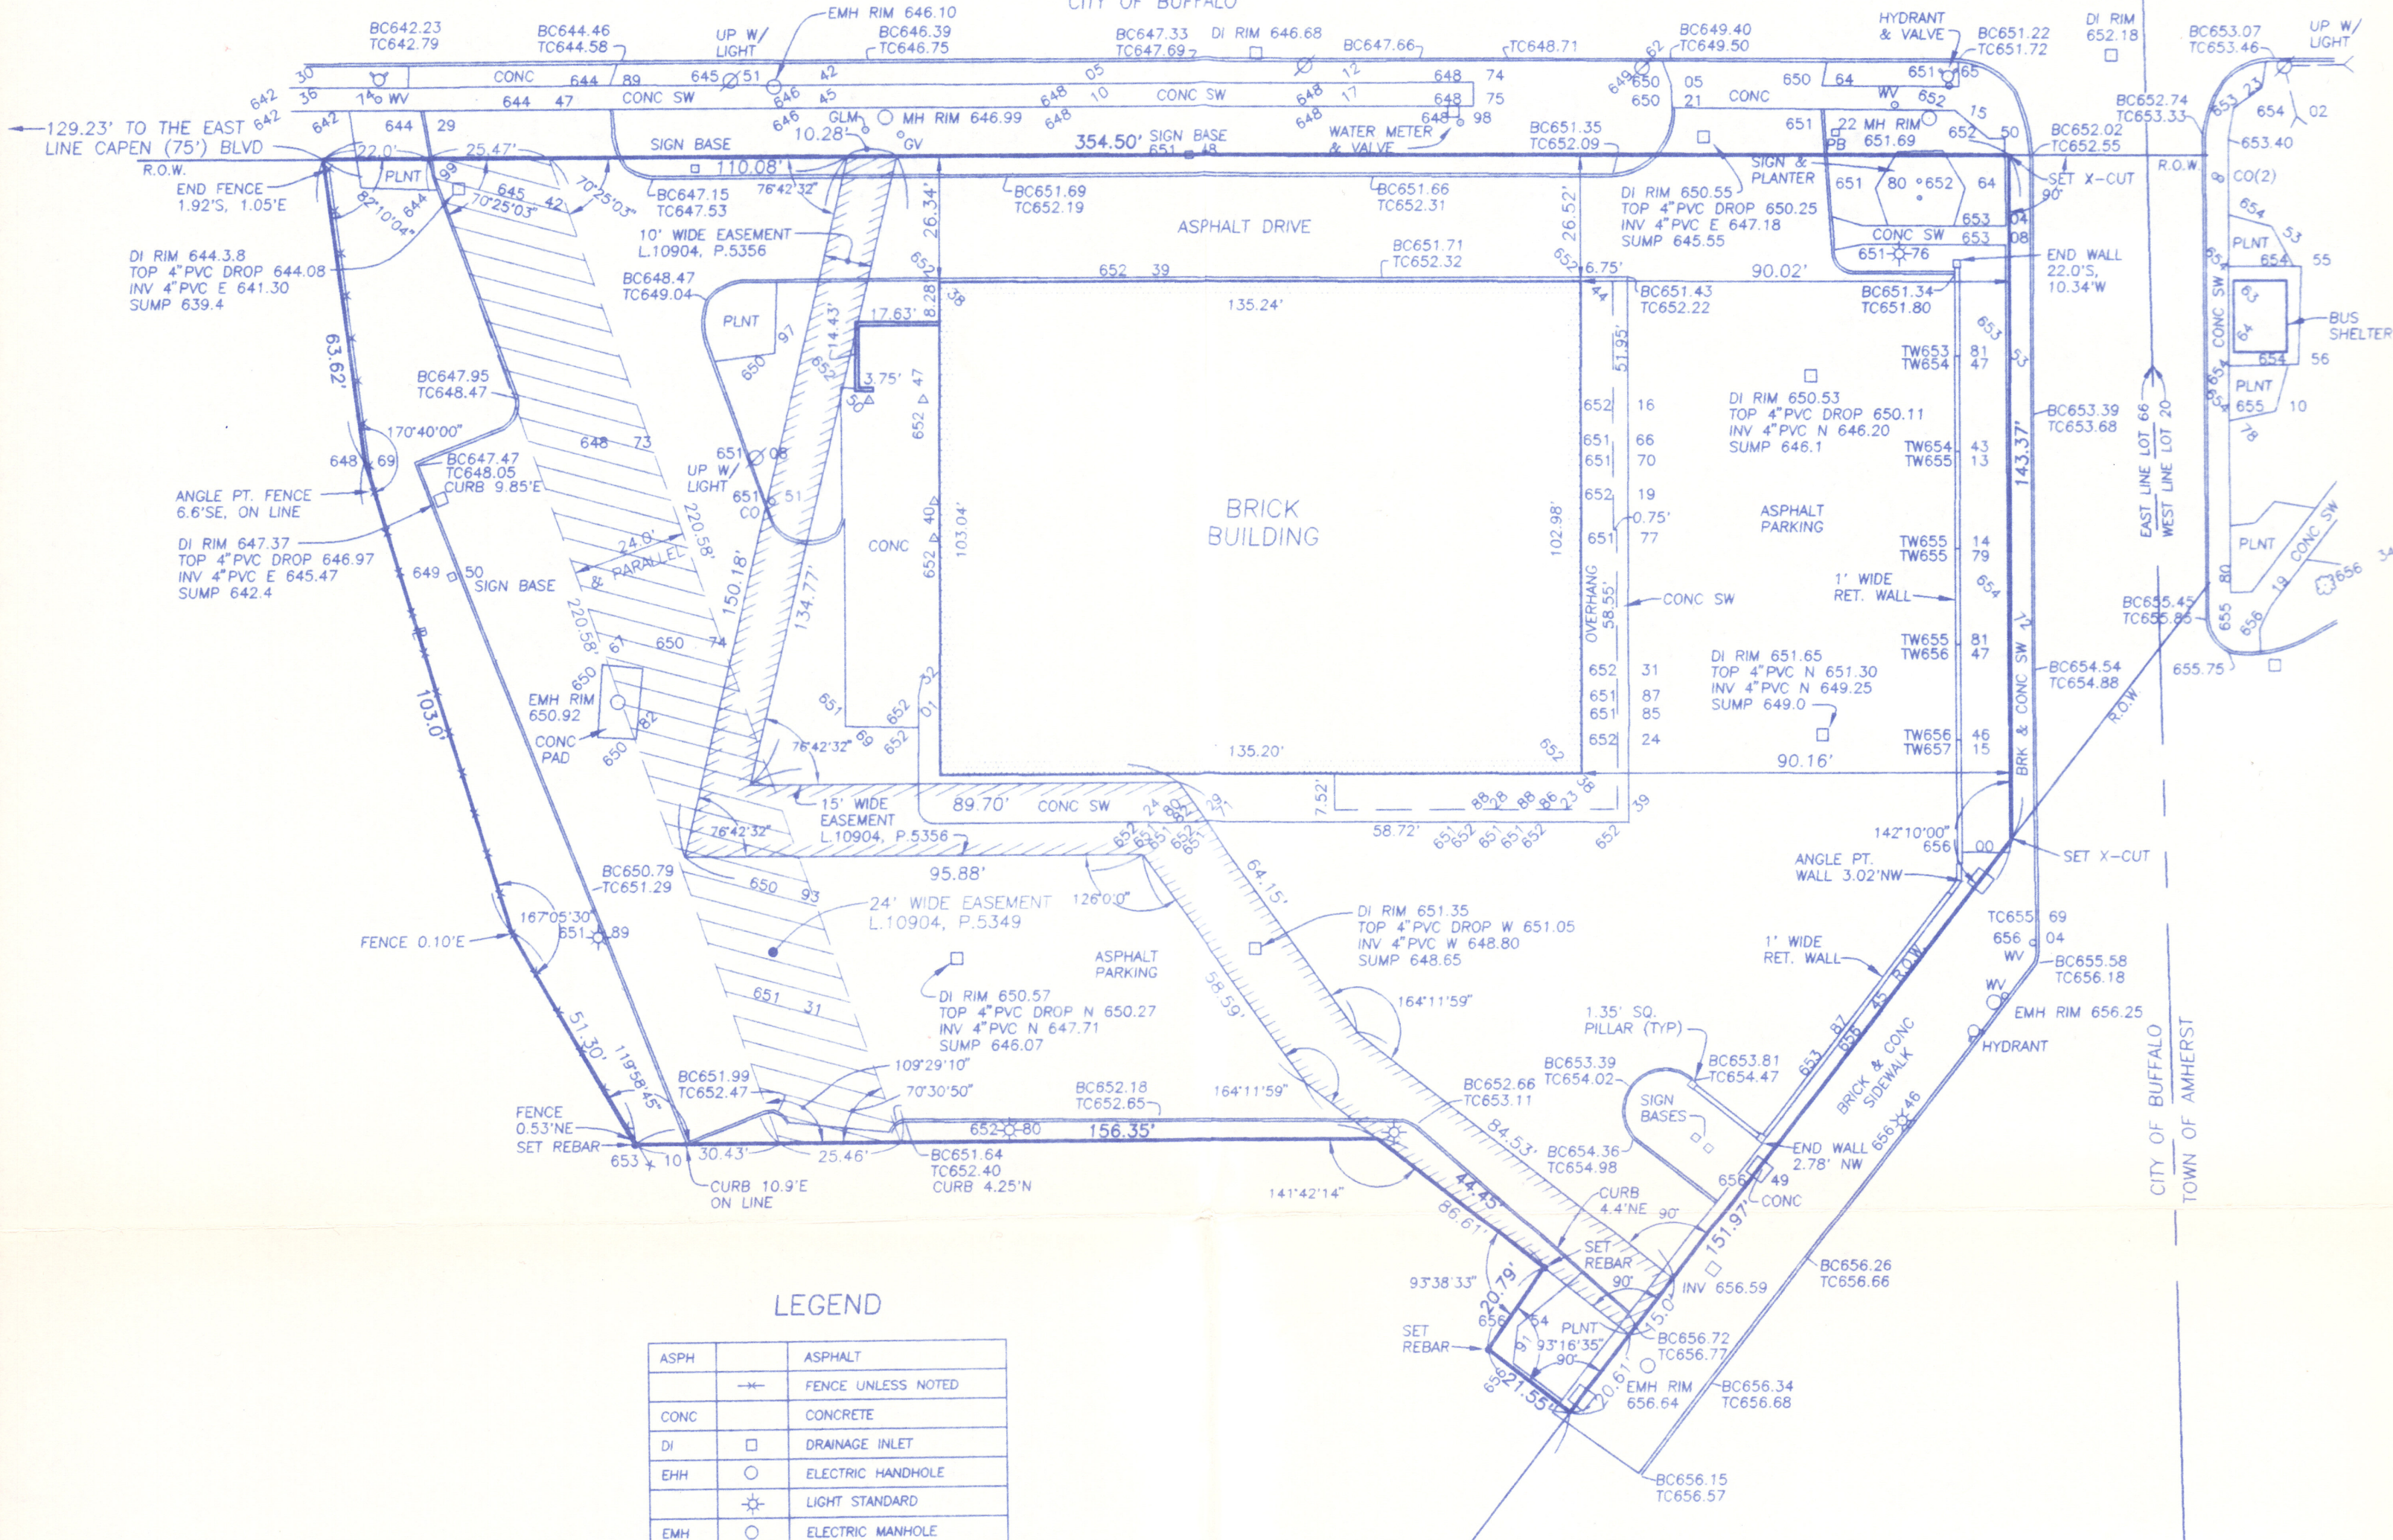

LEGEND

ASPH	—	ASPHALT
CONC	—	CONCRETE
DI	□	DRAINAGE INLET
EHH	○	ELECTRIC HANDHOLE
EMH	○	ELECTRIC MANHOLE
UE	—	UNDERGROUND ELECTRIC
OE	—	OVERHEAD ELECTRIC
UP	⊗	UTILITY POLE
WV	○	WATER VALVE
W	—	WATER LINE
	⊕	HYDRANT
BC	—	BOTTOM OF CURB
TC	—	TOP OF CURB
TW	—	TOP OF WALL

I HEREBY CERTIFY TO:

WALGREEN EASTERN CO., INC.
200 WILMOT ROAD
DEERFIELD, ILLINOIS 60015-4681

TICOR TITLE GUARANTEE COMPANY
110 FRANKLIN STREET
BUFFALO, NEW YORK 14202

CONSECO MORTGAGE CAPITAL, INC.
11815 NORTH PENNSYLVANIA STREET - B1A
CARMEL, INDIANA 46032

THAT THIS SURVEY WAS PREPARED IN ACCORDANCE
WITH THE CURRENT CODE OF PRACTICE FOR LAND
SURVEYS ADOPTED BY THE NEW YORK STATE
ASSOCIATION OF PROFESSIONAL LAND SURVEYORS AND
THE BAR ASSOCIATION OF ERIE COUNTY (NEW YORK).

Deborah A. Naylor

RECORD PLAN WALGREEN'S PARCEL

SURVEY

PART OF MAPCOVER 1403
PART OF LOT 66, T-11, R-7
TOWN OF AMHERST
COUNTY OF ERIE STATE OF NEW YORK

DEBORAH A. NAYBOR PLS, PC.
LAND SURVEYING - LAND PLANNING
11901 BROADWAY
ALDEN, NEW YORK 14004
(716) 937-9448

DATE : 11/25/96 SHEET : 1 OF 1
JOB NO.: 95100 SCALE : 1" = 30'

WARNING: ALTERING THIS DOCUMENT IS IN
VIOLATION OF THE LAW EXCEPTING AS
PROVIDED IN SECTION 7209, PART 2 OF
THE NEW YORK STATE EDUCATION LAW.

CAD: P120 \ 95100 \ WAL_REC.DWG