

Property Key



A site map showing the location of the property at the intersection of Hoffner Avenue and S Semoran Boulevard. The property is highlighted in blue. A north arrow is located in the top right corner of the map.

Alt Springs As Built Marketing Package


5842-5856 S Semoran Blvd, Orlando, FL 32809, US

Building: C

Suite: 5852

Sheet **E1**

Scale: Not to Scale
Sheet Size: 42" x 30"
Not For Construction

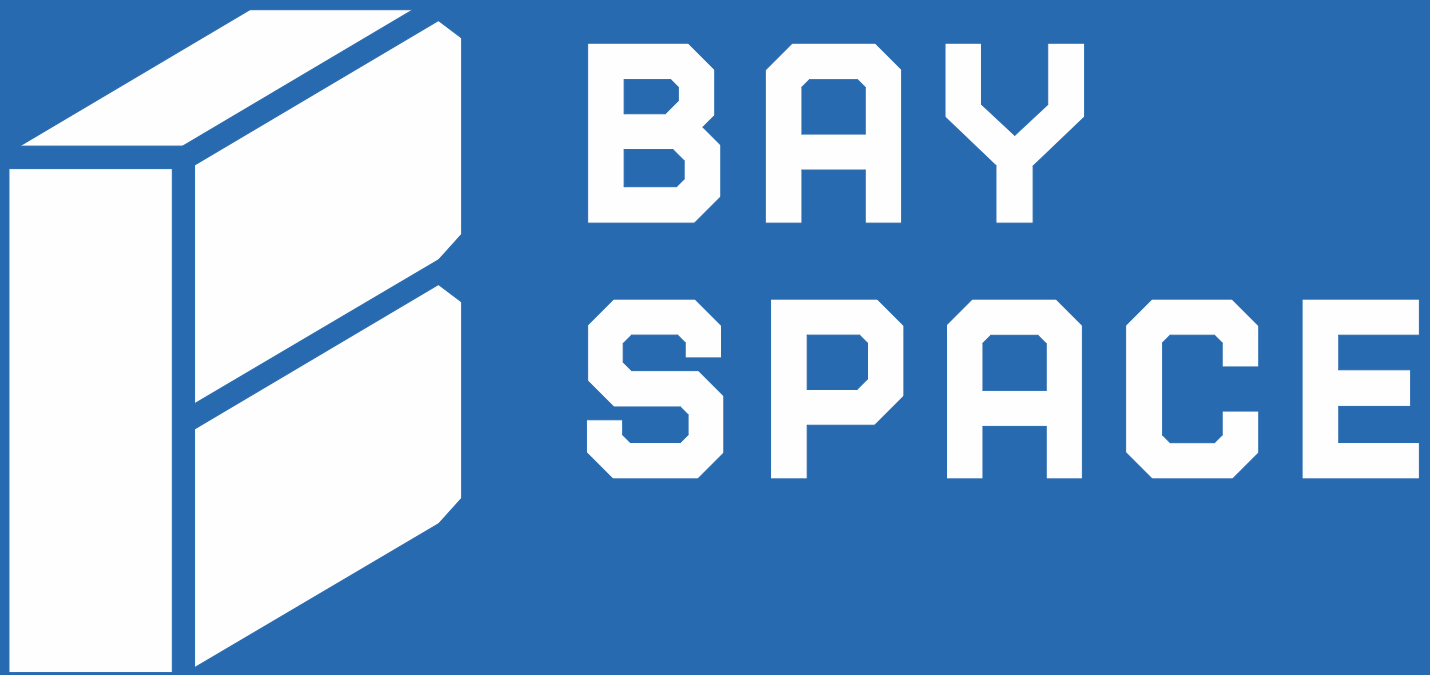

Usable Square Foot Analysis

Office Area	2,376	100 %
Warehouse Area	0	0%
Total Area	2,376	

Building Information

Deck Height:	14' - 10"
Clear Height:	12' - 4"
Ceiling Height:	7' - 9"
Sprinklered:	☐ Yes ☒ No
Mechanical Area:	0 SQFT

