




THIS DRAWING IS THE PROPERTY OF M ARCHITECTURE INC. AND SHALL NOT BE REPRODUCED, COPIED, LENT, OR DISPOSED OF DIRECTLY OR INDIRECTLY NOR USED FOR ANY PURPOSE OTHER THAN THAT FOR WHICH IT WAS SPECIFICALLY CREATED AND MUST BE RETURNED TO M ARCHITECTURE INC. UPON COMPLETION OF WORK. IF REQUESTED, DO NOT SCALE DRAWINGS.

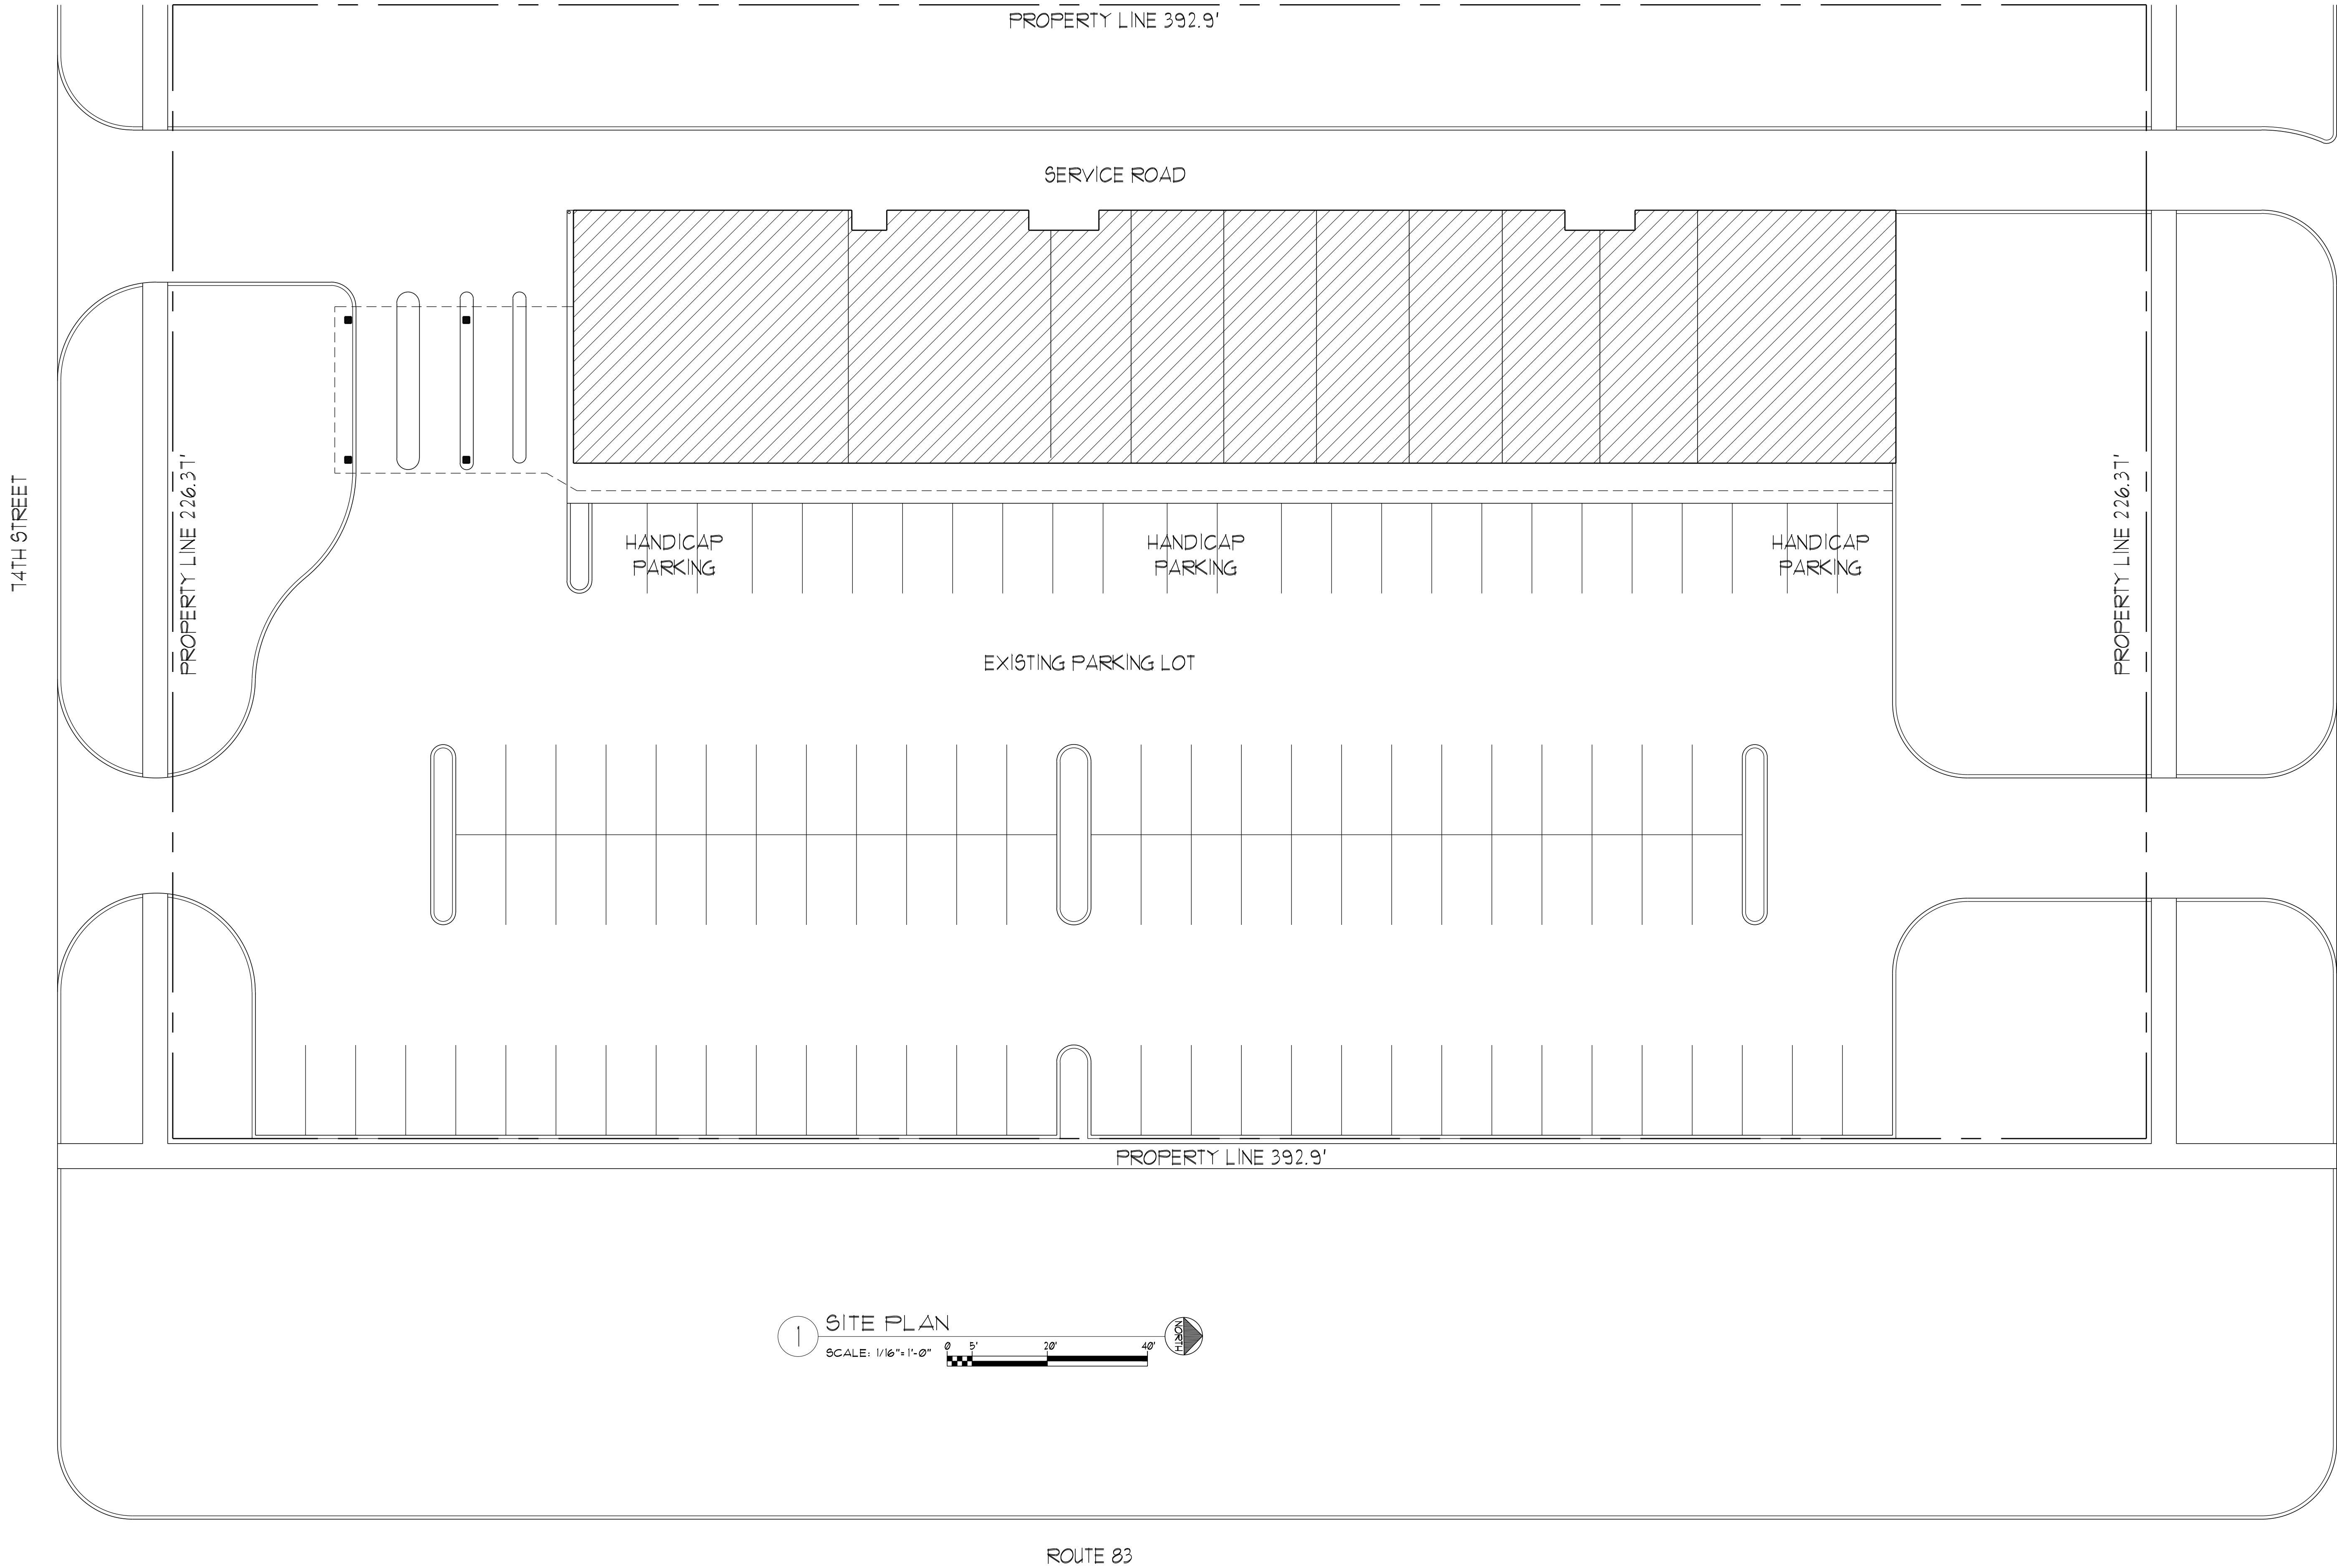

1 SITE PLAN  
SCALE: 1/16" = 1'-0"

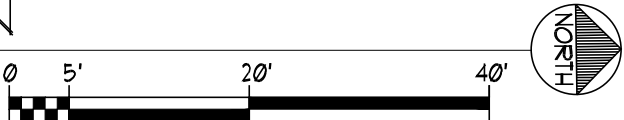

ELM STREET

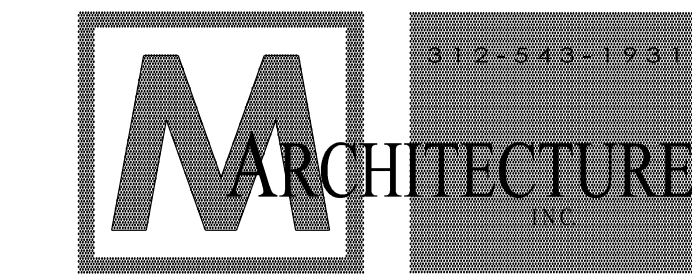

7372-80 KINGERY HIGHWAY  
WILLOWBROOK, ILLINOIS 60561  
AS BUILT CONDITIONS

SITE PLAN

ISSUED FOR REVIEW 11-22-24

C-24-341	A1
----------	----