



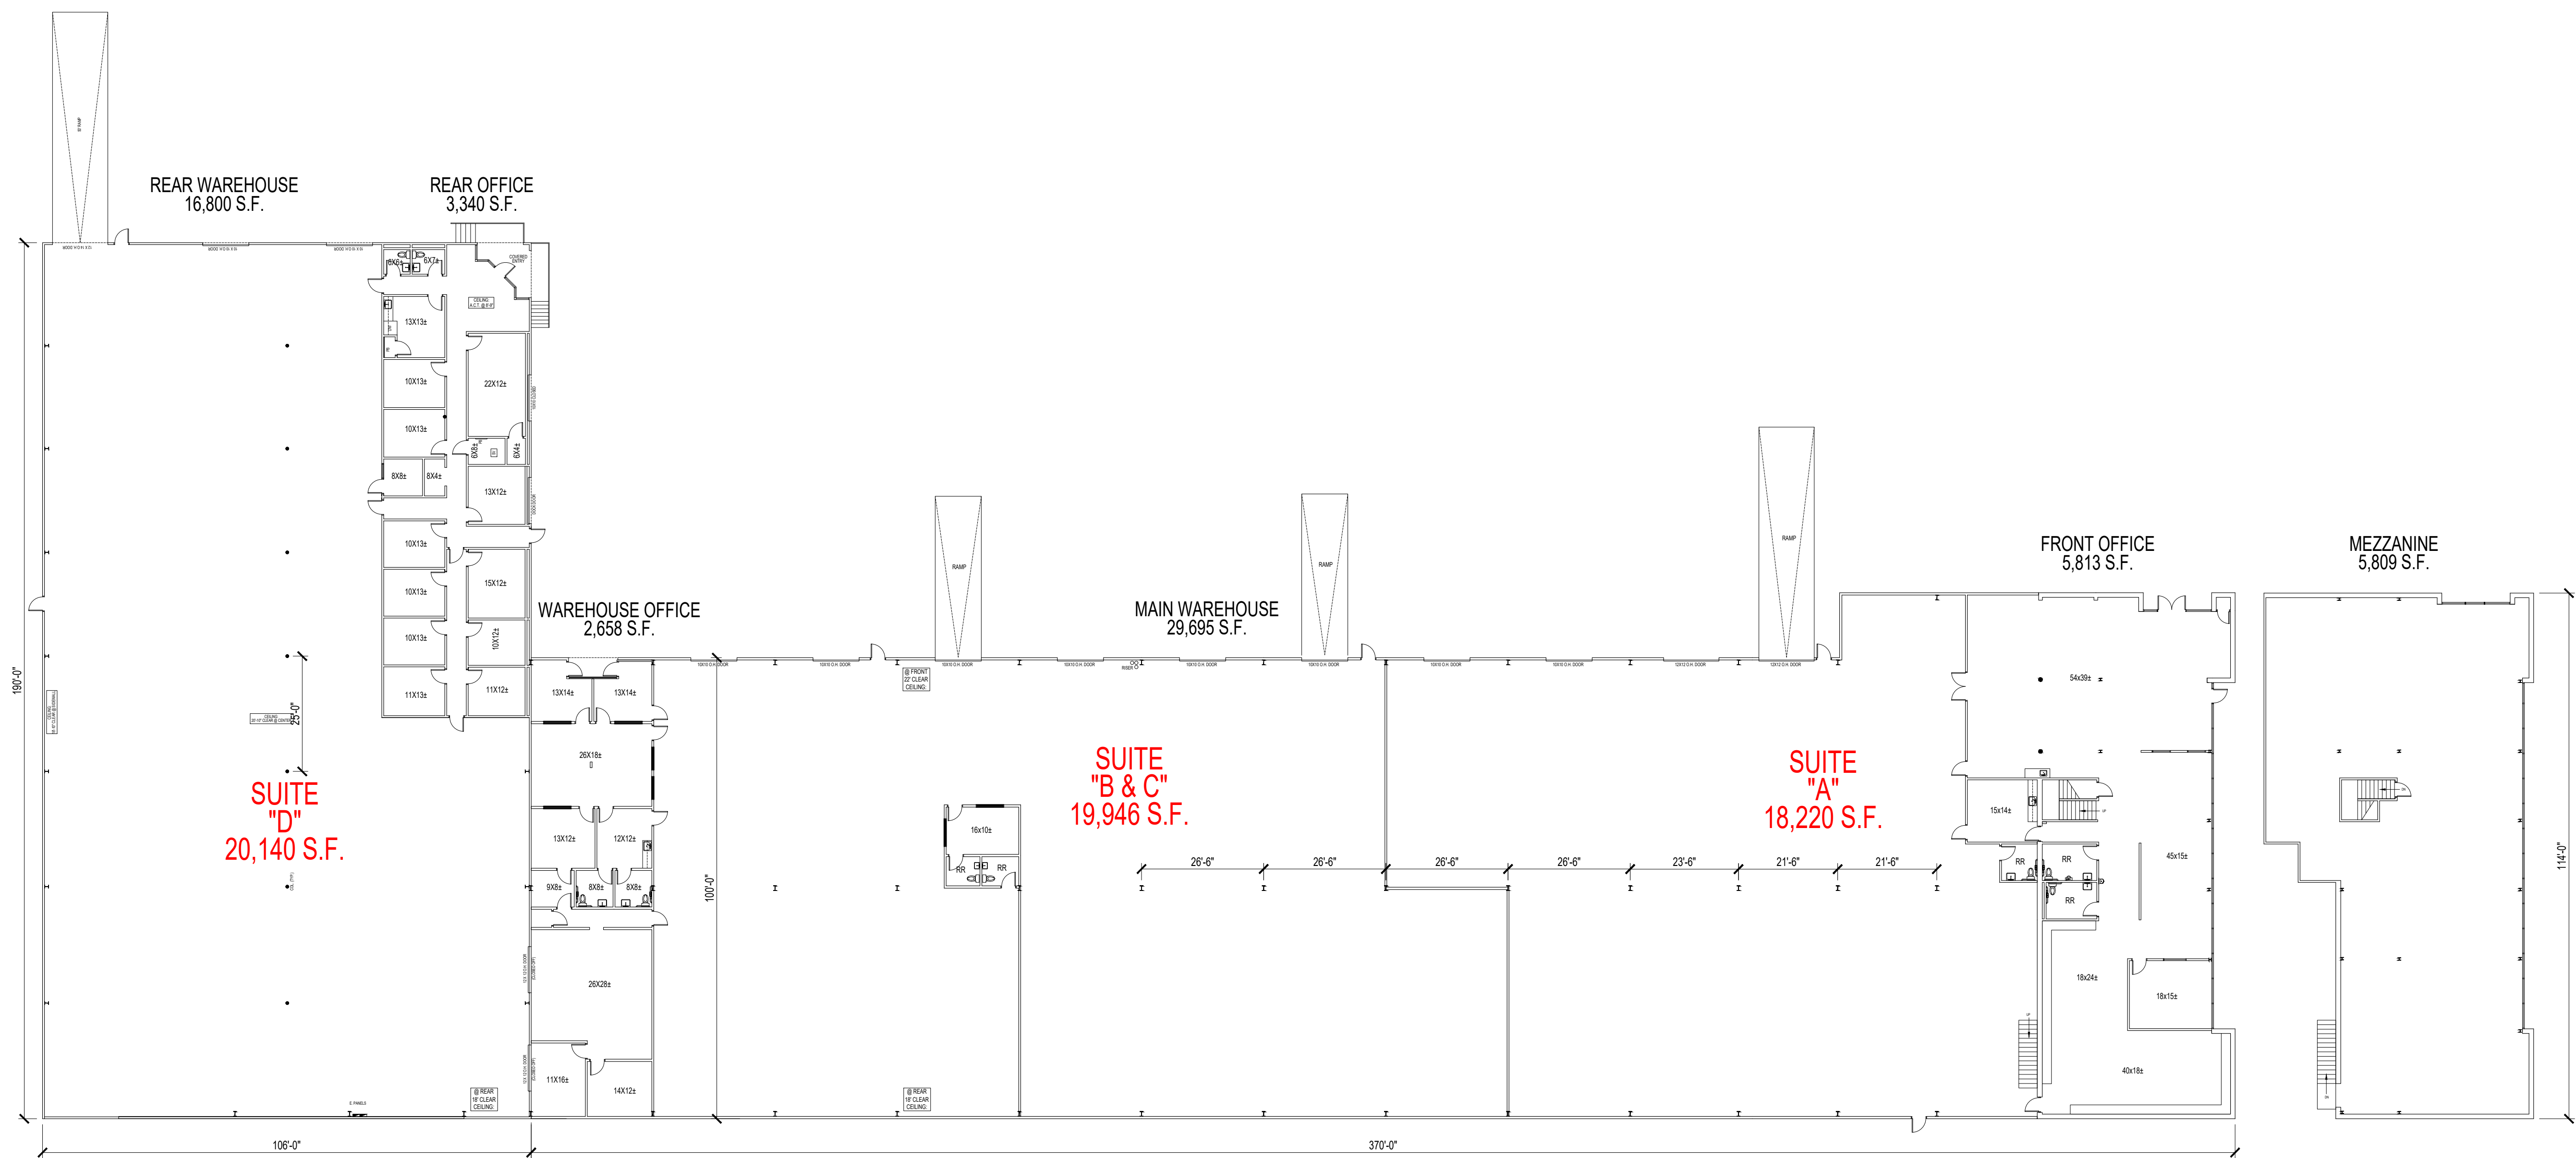

FLOOR PLAN

TABULATIONS:

AREA:	SQ. FT.:
FRONT OFFICE	5,813
MAIN WAREHOUSE	29,695
WAREHOUSE OFFICE	2,658
REAR OFFICE	3,340
REAR WAREHOUSE	16,800
TOTAL:	58,306

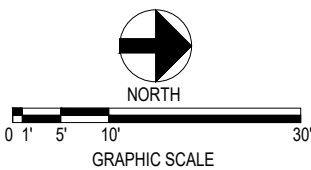

CLIENT:

PROJECT:

TITLE:
BUILDING PLAN

SHEET:
A-1

6312 AIRPORT FREEWAY
HALTOM CITY, TEXAS

SCALE: 1/16" = 1'-0"
(when printed on 30x42 paper)

DATE: 7/14/26
REVISION: 2