



Property Key

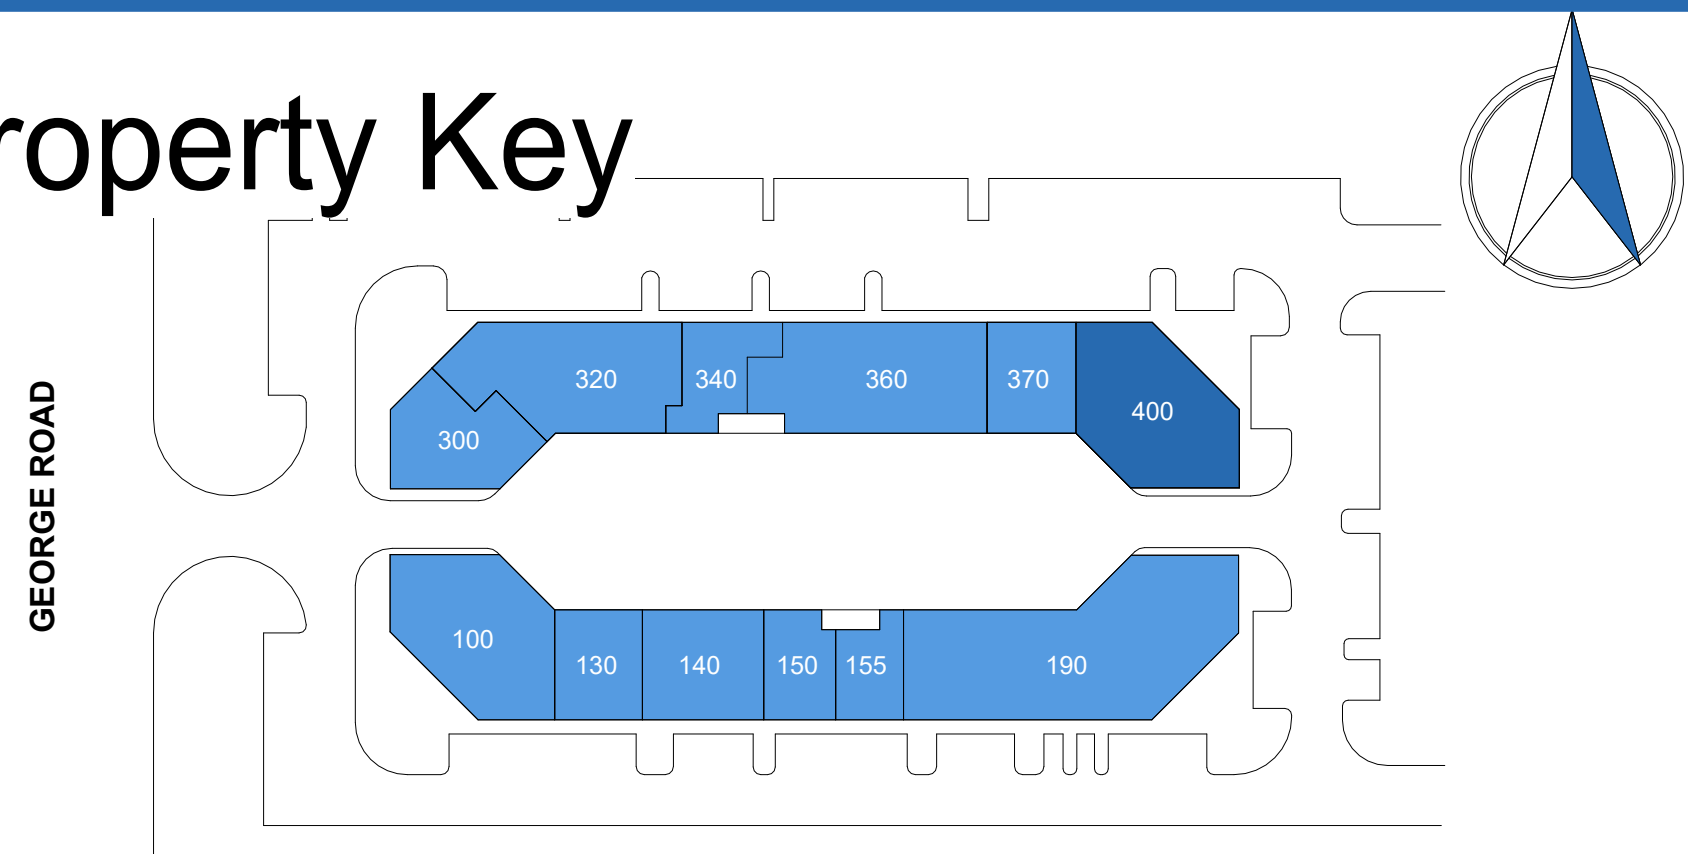

Presidents As Built Marketing Package

4801 - 4803, George Rd, Tampa, FL 33634, US

Building: 4803
 Suite: 400
 Sheet **E1**

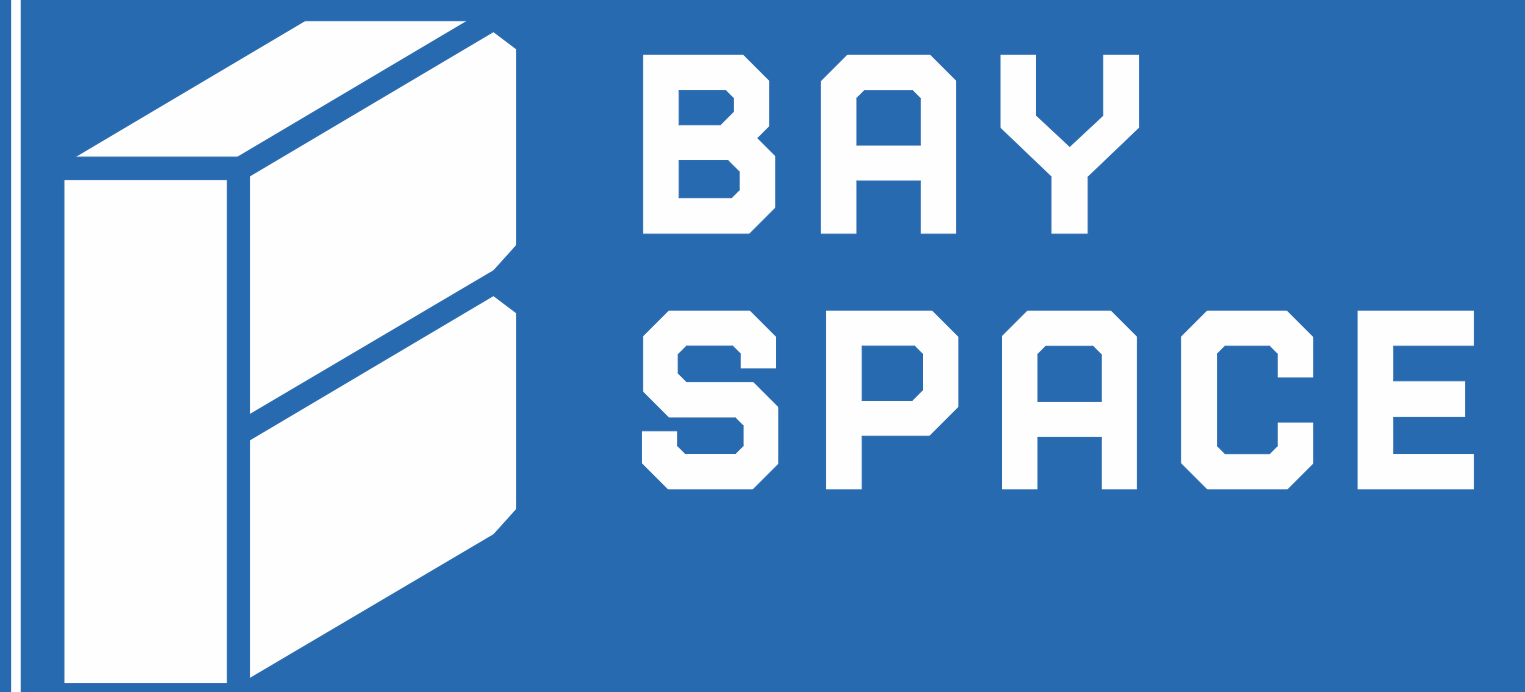

Scale: Not to Scale
 Sheet Size: 42" x 30"
 Not For Construction

Usable Square Foot Analysis

Office Area	4,663	100 %
Warehouse Area	0	0%
Total Area	4,663	

Building Information

Deck Height:	16' - 1"
Clear Height:	8' - 10"
Ceiling Height:	8' - 10"
Sprinklered:	<input checked="" type="checkbox"/> Yes <input type="checkbox"/> No
Mechanical Area:	0 SQFT



As Built Floor Plan for Marketing

