

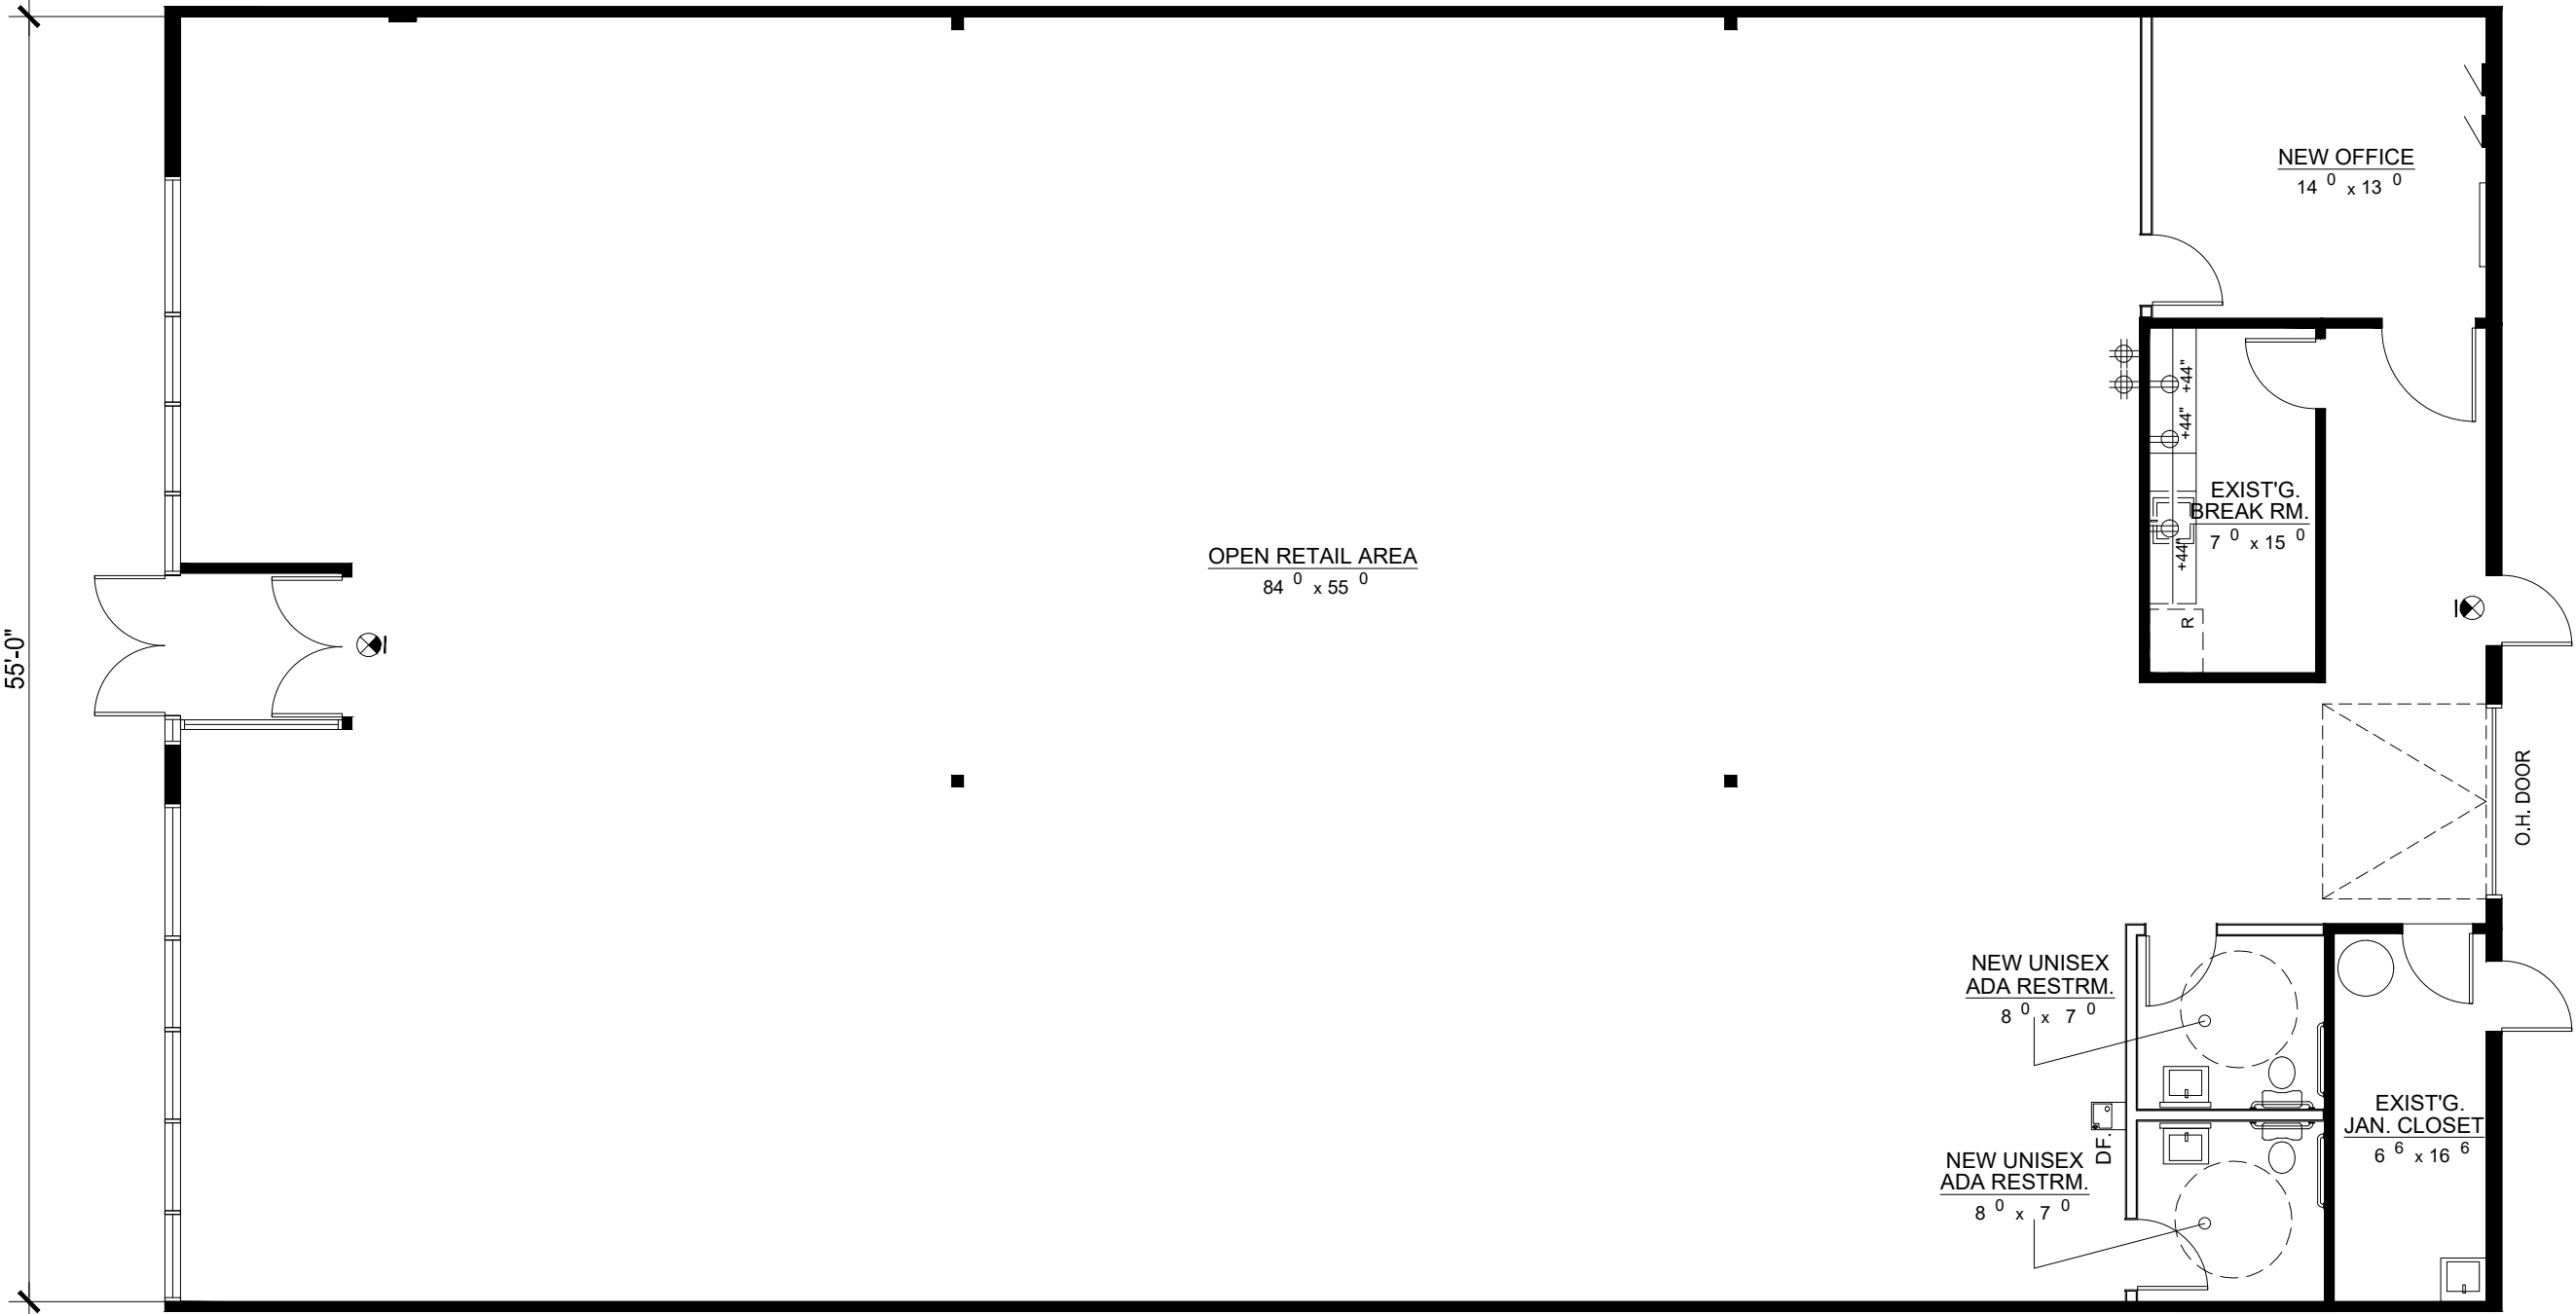
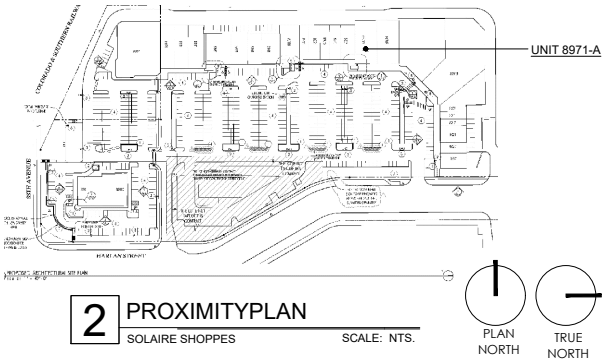


NEW SPACE PLAN: SOLAIRE SHOPPES (LANDLORD WORK)

88TH AVE. AND HARAN STREET
WESTMINSTER, COLORADO

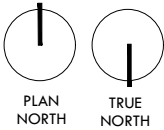

1 NEW SPACE PLAN
SCALE 1/8"=1'-0"
UNIT 8971A

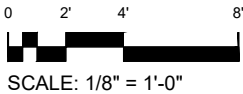

ADVANCED
PLANNING
SOLUTIONS INC
DESIGN & PLANNING

11178 HURON STREET SUITE 204
NORTHGLENN, COLORADO 80234
PHONE: 303.817.4464
WWW.ADVANCEDPLANNINGSOLUTIONSINC.COM

NEW SPACE PLAN (LANDLORD WORK)
UNIT 8971A SOLAIRE SHOPPES
88TH AVE. AND HARAN STREET
WESTMINSTER, COLORADO


REV. DATE: 12/03/2020
PROJECT NO: 8801-1001
DRAWN BY: MH / IO

TITLE:
NEW SPACE PLAN

SHEET NO:
SP1

AS-BUILT FLOOR PLAN: SOLAIRE SHOPPES

88TH AVE. AND HARAN STREET
WESTMINSTER, COLORADO

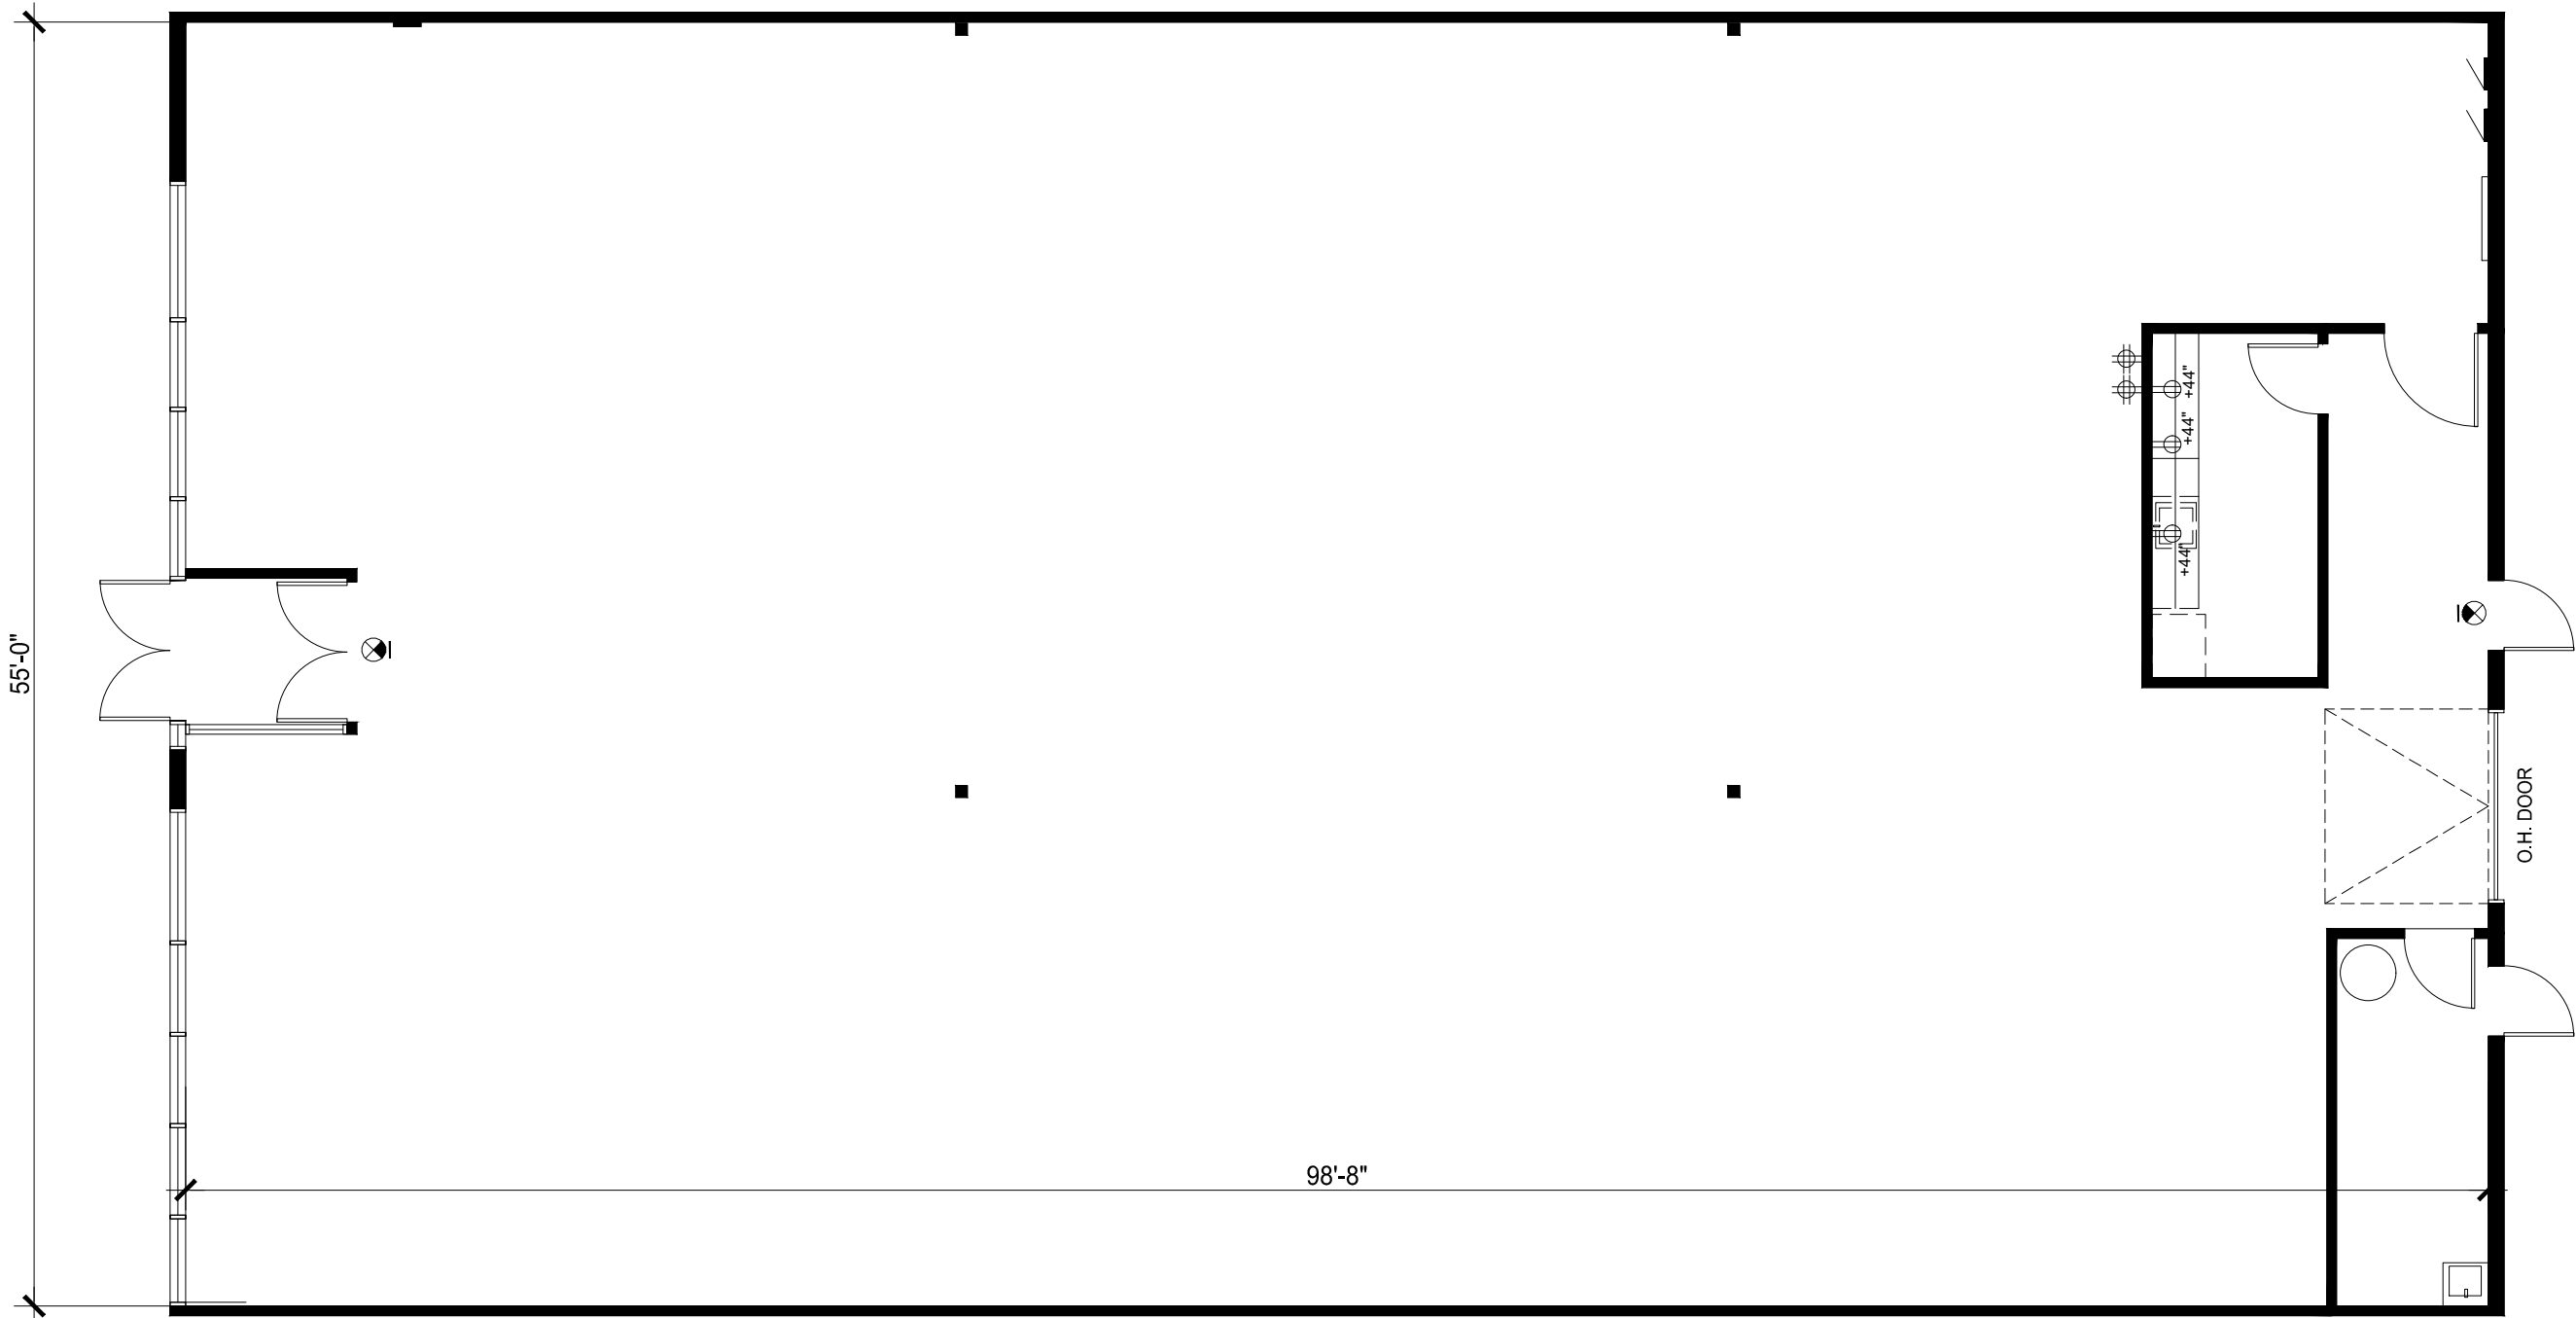



1 AS-BUILT FLOOR PLAN

SCALE 1/8"=1'-0"

UNIT 8971A




SCALE: 1/8" = 1'-0"

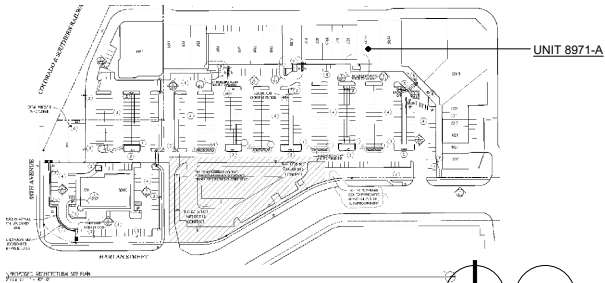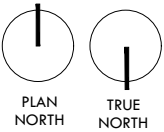


2 PROXIMITY PLAN

SOLAIRE SHOPPES

SCALE: NTS.

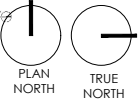

ADVANCED
PLANNING
SOLUTIONS INC
DESIGN & PLANNING

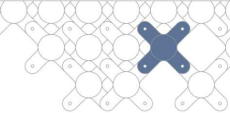

11178 HURON STREET SUITE 204
NORTHGLENN, COLORADO 80234
PHONE: 303.817.4464
WWW.ADVANCEDPLANNINGSOLUTIONSINC.COM

AS-BUILT FLOOR PLAN
UNIT 8971A SOLAIRE SHOPPES
88TH AVE. AND HARAN STREET
WESTMINSTER, COLORADO

REV. DATE: 12/03/2020
PROJECT NO: 8801-1001
DRAWN BY: MH / IO

TITLE:
AS-BUILT PLAN

SHEET NO:
AB1