


Floor Plan 205-217

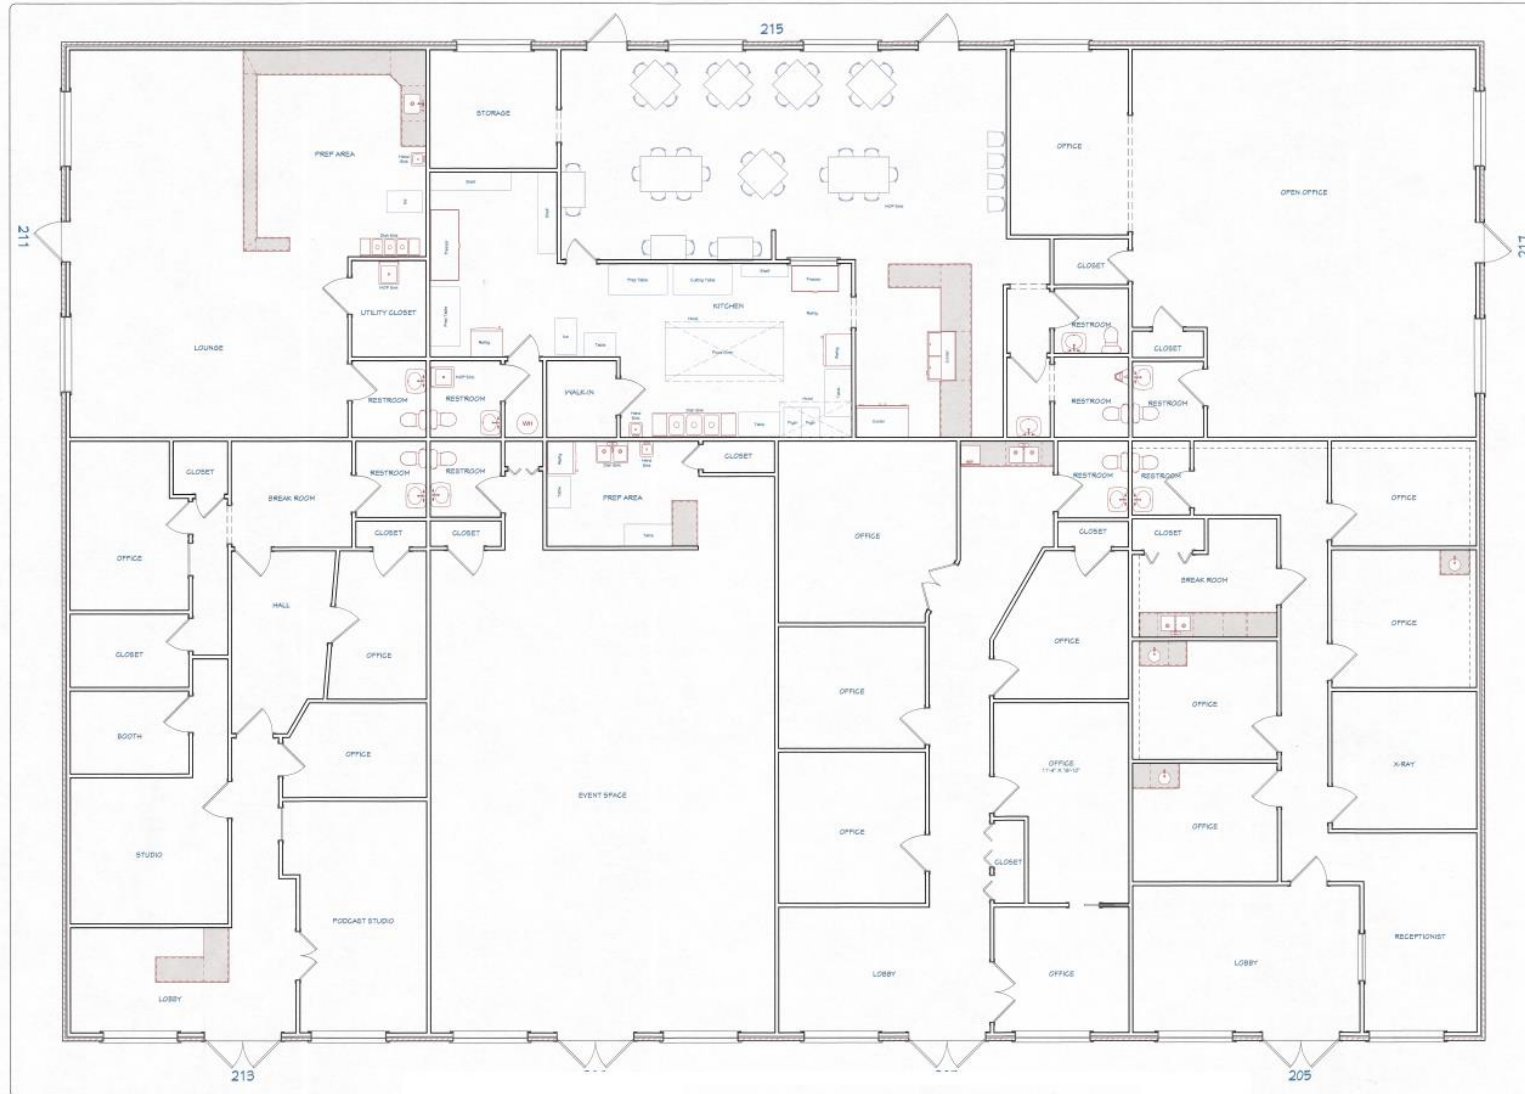

**NETTERFIELD
DESIGNS**
ARCHITECTURAL DRAFTING SERVICES
netterfield_design@hotmail.com
909-8142

SOLVING THE PROBLEM			
What Do I Know?	What Do I Need?	What Plan?	What Answer?
1. The number of people who attended the concert was 1,200. 2. The number of people who attended the concert was 1,200.	1. The number of people who attended the concert was 1,200. 2. The number of people who attended the concert was 1,200.	1. The number of people who attended the concert was 1,200. 2. The number of people who attended the concert was 1,200.	1. The number of people who attended the concert was 1,200. 2. The number of people who attended the concert was 1,200.

**505 - 517
GIFFORD PLACE**

DRAWN BY:	GUN
CHECKED BY:	GUN
DATE:	7/6/54
PROJECT NO:	A0054
SCALE:	1/4" = 1'

AS-BUILT
SHEET NUMBER
A1.0