


Property Key

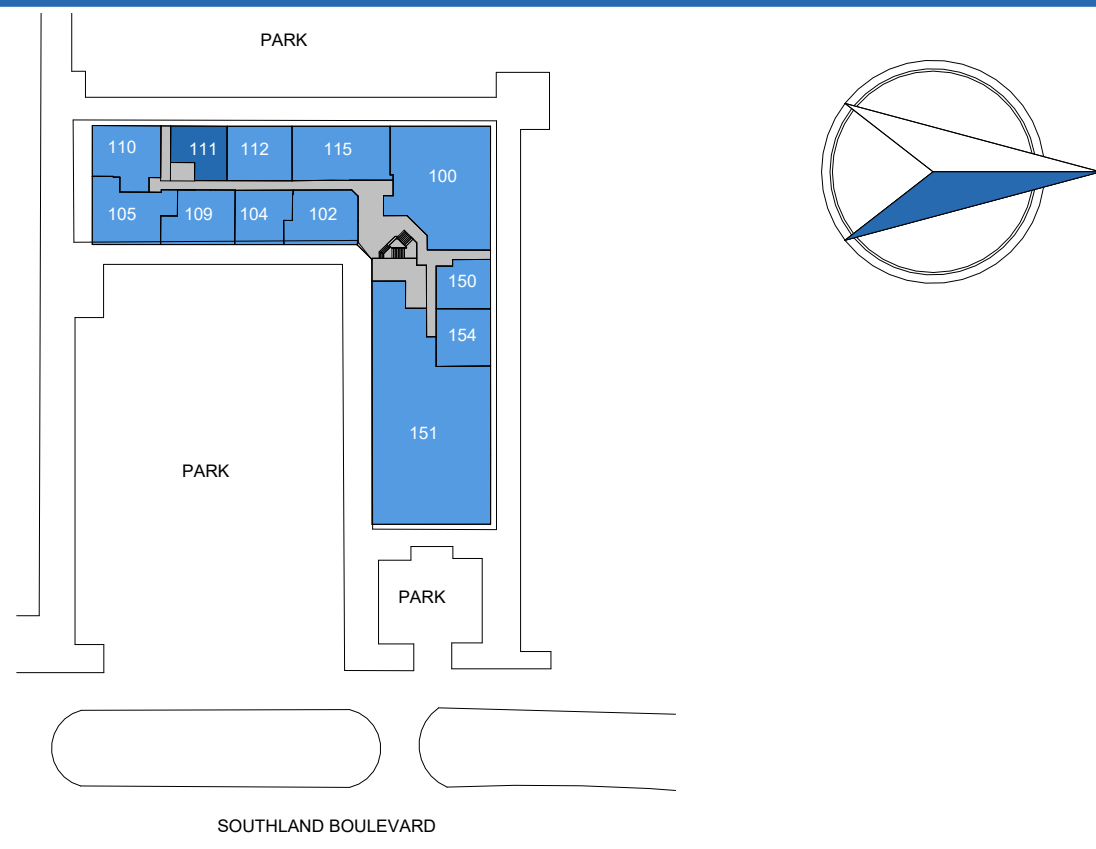


Southland As Built Marketing Package

7800 Southland Blvd, Orlando, FL 32809, US

Building: 7800

Suite: 111 Floor 1

Sheet **E1**

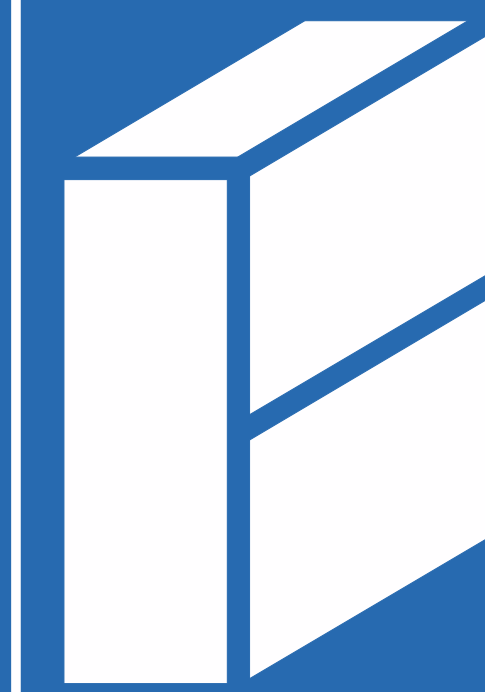

BAY SPACE


Scale: Not to Scale
Sheet Size: 42" x 30"
Not For Construction

Usable Square Foot Analysis

Office Area	1,105	100 %
Warehouse Area	0	0%
Total Area	1,105	

Building Information

Deck Height:	N/A	
Clear Height:	8' - 5"	
Ceiling Height:	8' - 5"	
Sprinklered:	<input type="checkbox"/> Yes	<input checked="" type="checkbox"/> No
Mechanical Area:	0 SQFT	

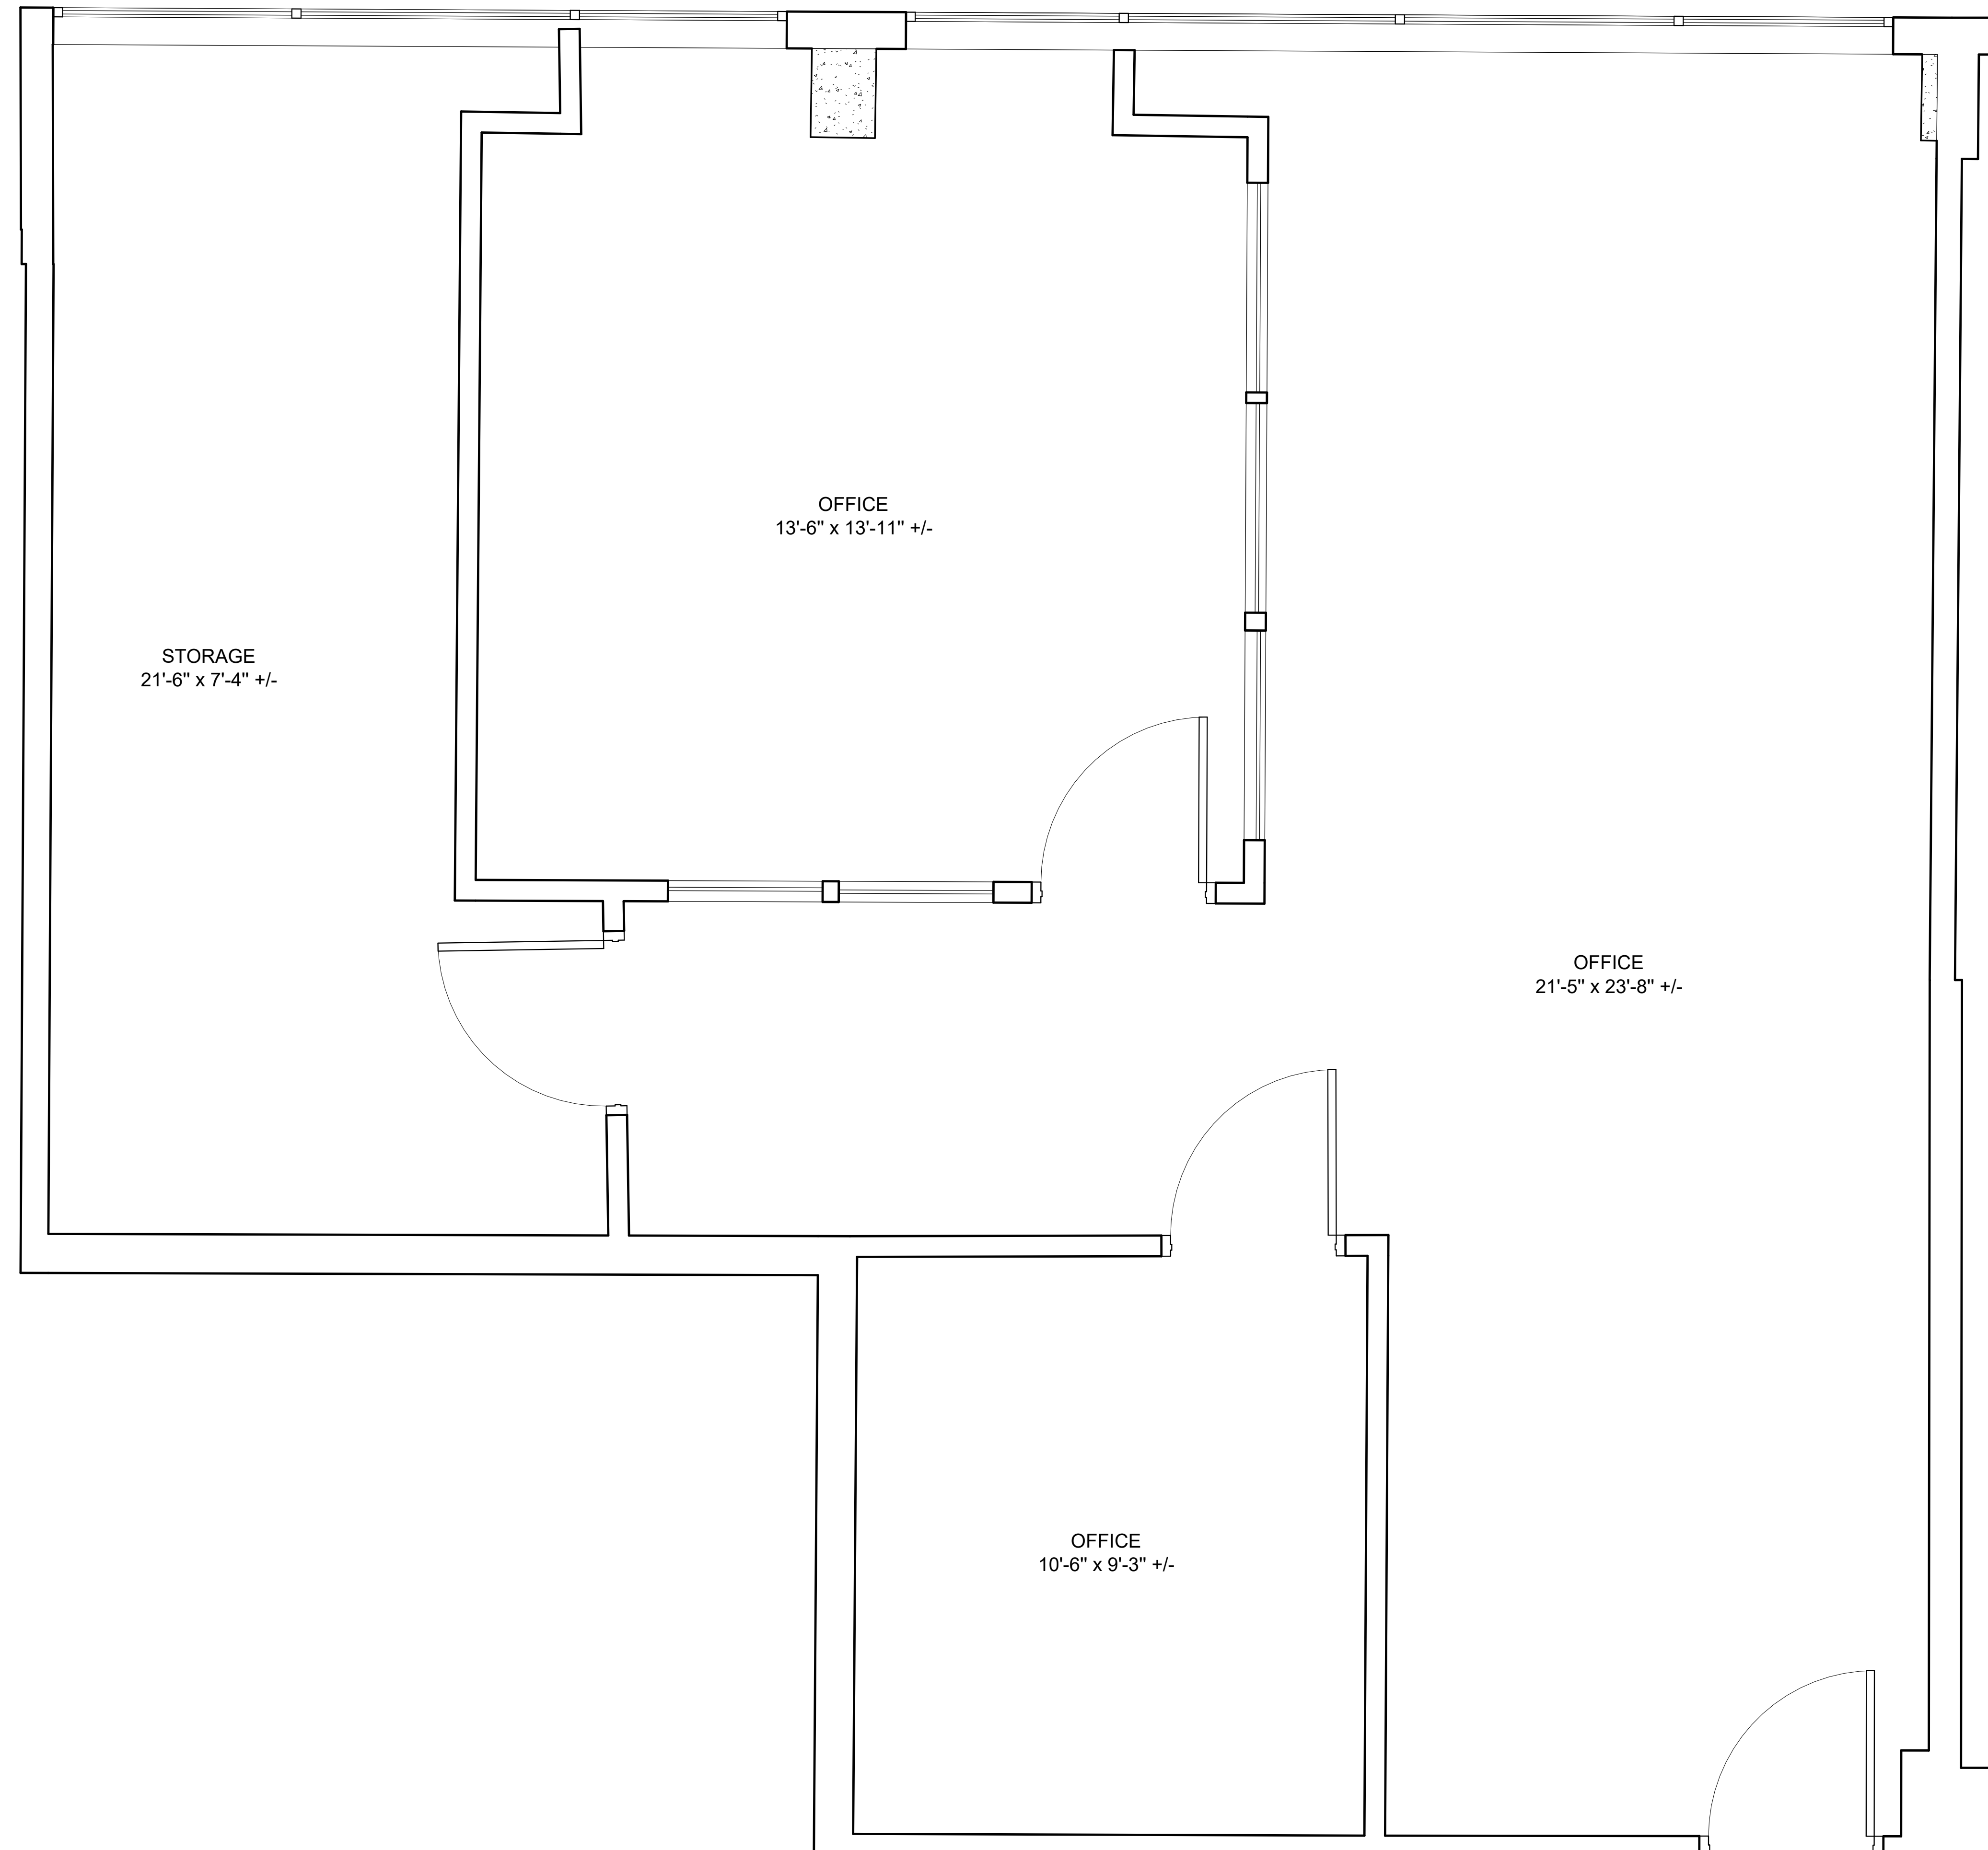

② 1st Floor - 111
1 : 20

