


SUITE 800 28,485 RSF

AS-BUILT PLAN

Beale Street

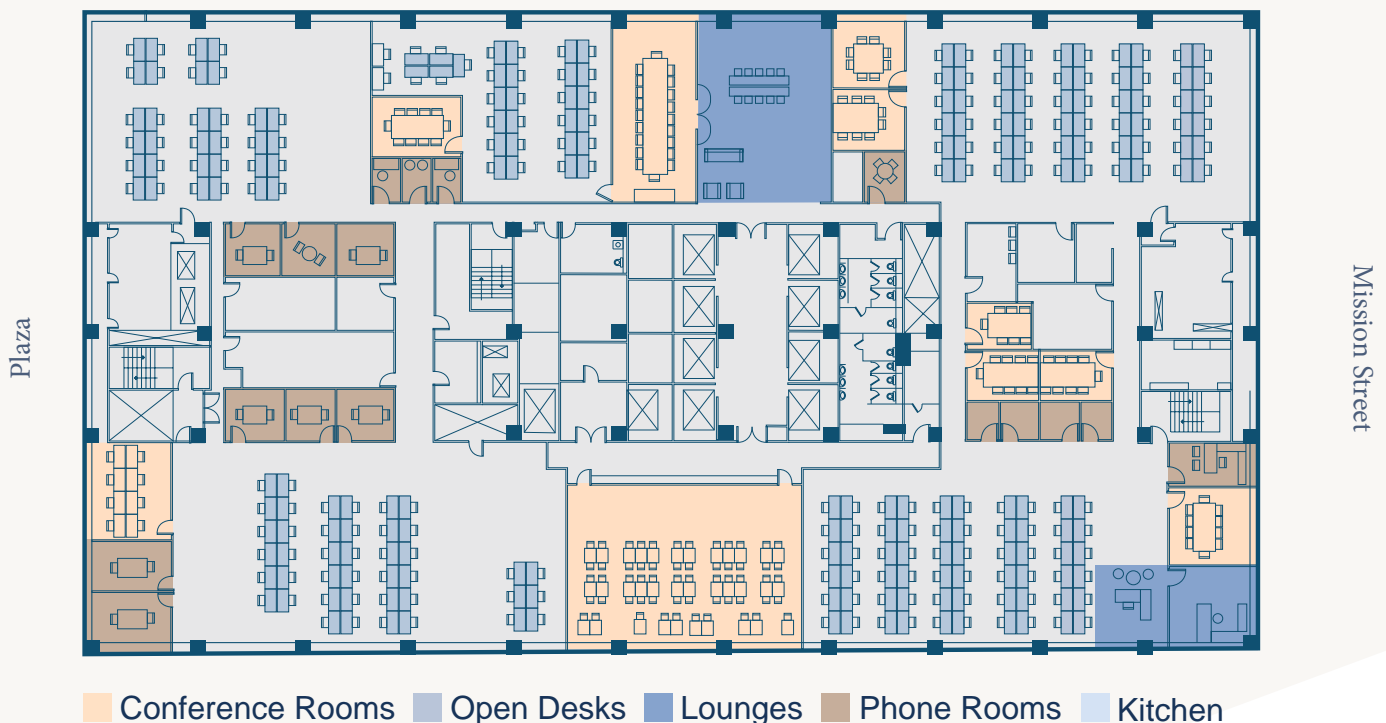

- Available 11/1/2025
- Furniture may be available
- Open space for ~240 workstations
- Highly creative floor
- Large all-hands kitchen
- 27 meeting rooms
- Mother's room

Christopher Roeder
Wes Powell
Ted Davies
Tom Doupe
Teva Myatt

415 395 4971
415 395 4901
415 395 4972
415 395 4933
415 395 7290

chris.roeder@jll.com
wes.powell@jll.com
ted.davies@jll.com
tom.doupe@jll.com
teva.myatt@jll.com

RE License # 01190523
RE License # 01702003
RE License # 01460185
RE License # 01921218
RE License # 02198058

