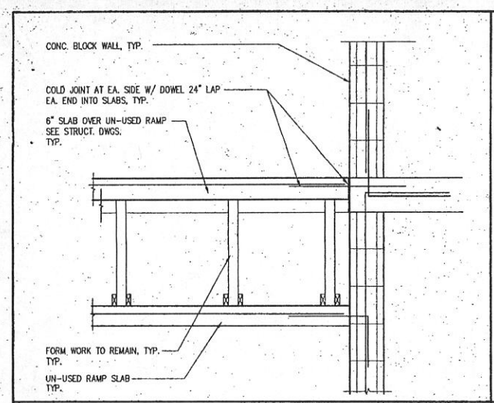

DECK O/ RAMP DETAIL — SCALE: N.T.S. — 5

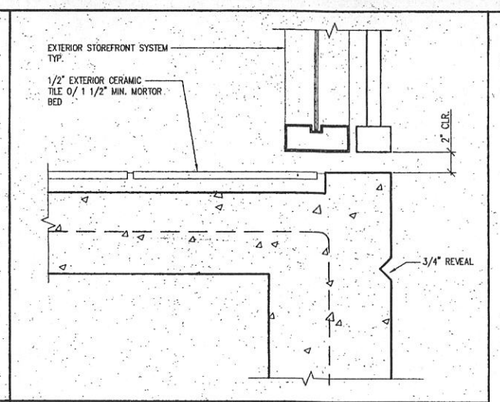

DETAIL — SCALE: N.T.S. — 1

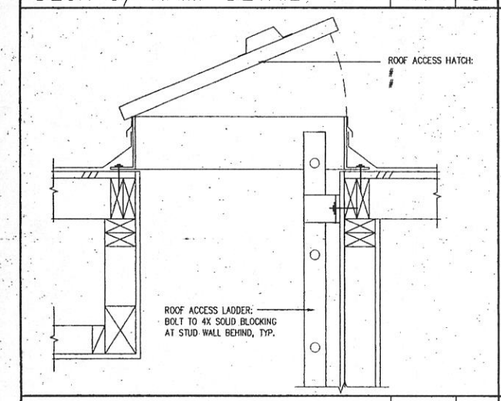

DETAIL — SCALE: N.T.S. — 6

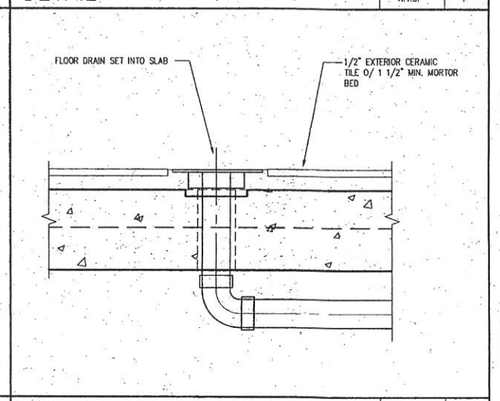

DETAIL — SCALE: N.T.S. — 2

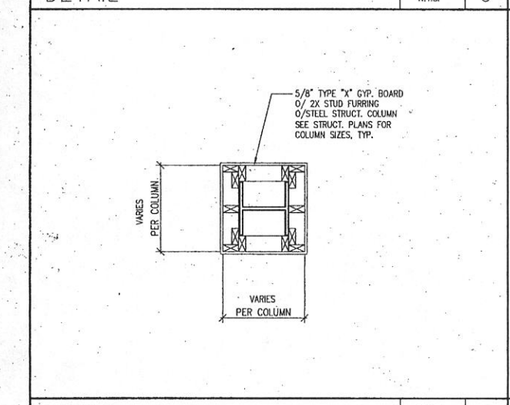

DETAIL — SCALE: N.T.S. — 7

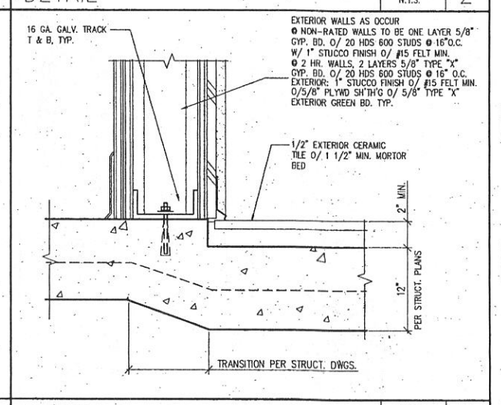

DETAIL — SCALE: N.T.S. — 3

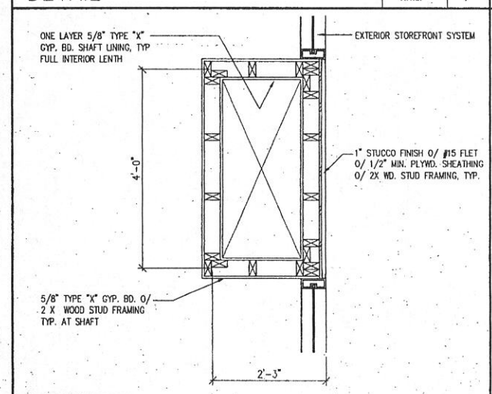

DETAIL — SCALE: N.T.S. — 8

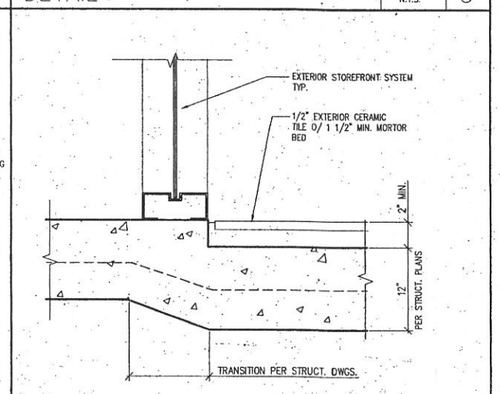

DETAIL — SCALE: N.T.S. — 4

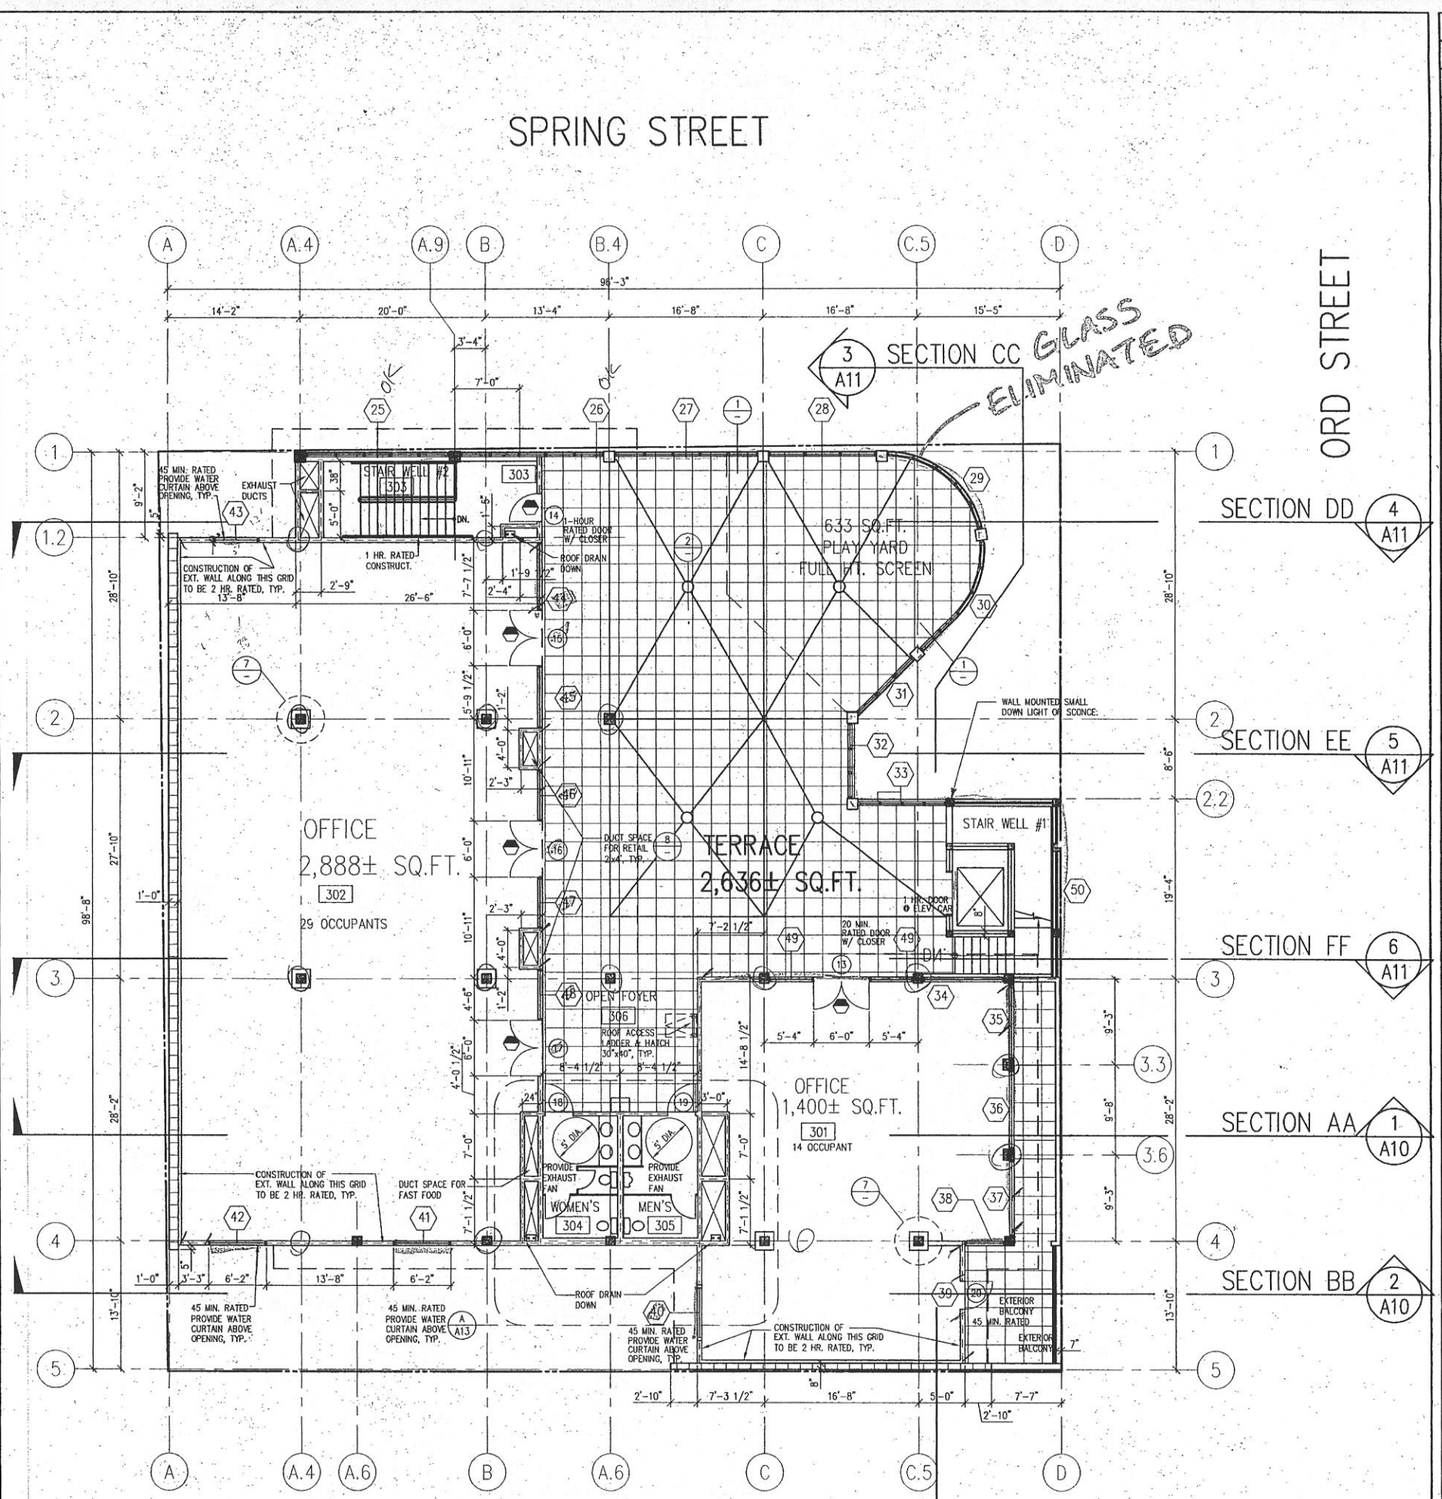

3RD LEVEL - FLOOR PLAN

REVISION SET

REVISION	DATE
1 PLAN CHECK CORRECTION	7-13-98

CHINA TOWN COMMERCIAL DEVELOPMENT
686-690 SPRING STREET
LOS ANGELES, CA

FLOOR PLAN
3RD LEVEL

JOHN G. CATALDO A.I.A., C.S.I.
553 South Lake Avenue
Pasadena, California 91101
office(818) 796-1153 fax(818) 796-1786
ARCHITECTURE PLANNING

Date	2-18-97
Scale	1/8"=1'-0"
Drawn by	J.C.B.\V.S.
Job #	14660

REVISED
A3
\PROJECTS\14660\AP3.DWG