San Marco Plaza Medical & Wellness Center
1399 Ygnacio Valley Road, Suite 14
Walnut Creek, Ca 94598

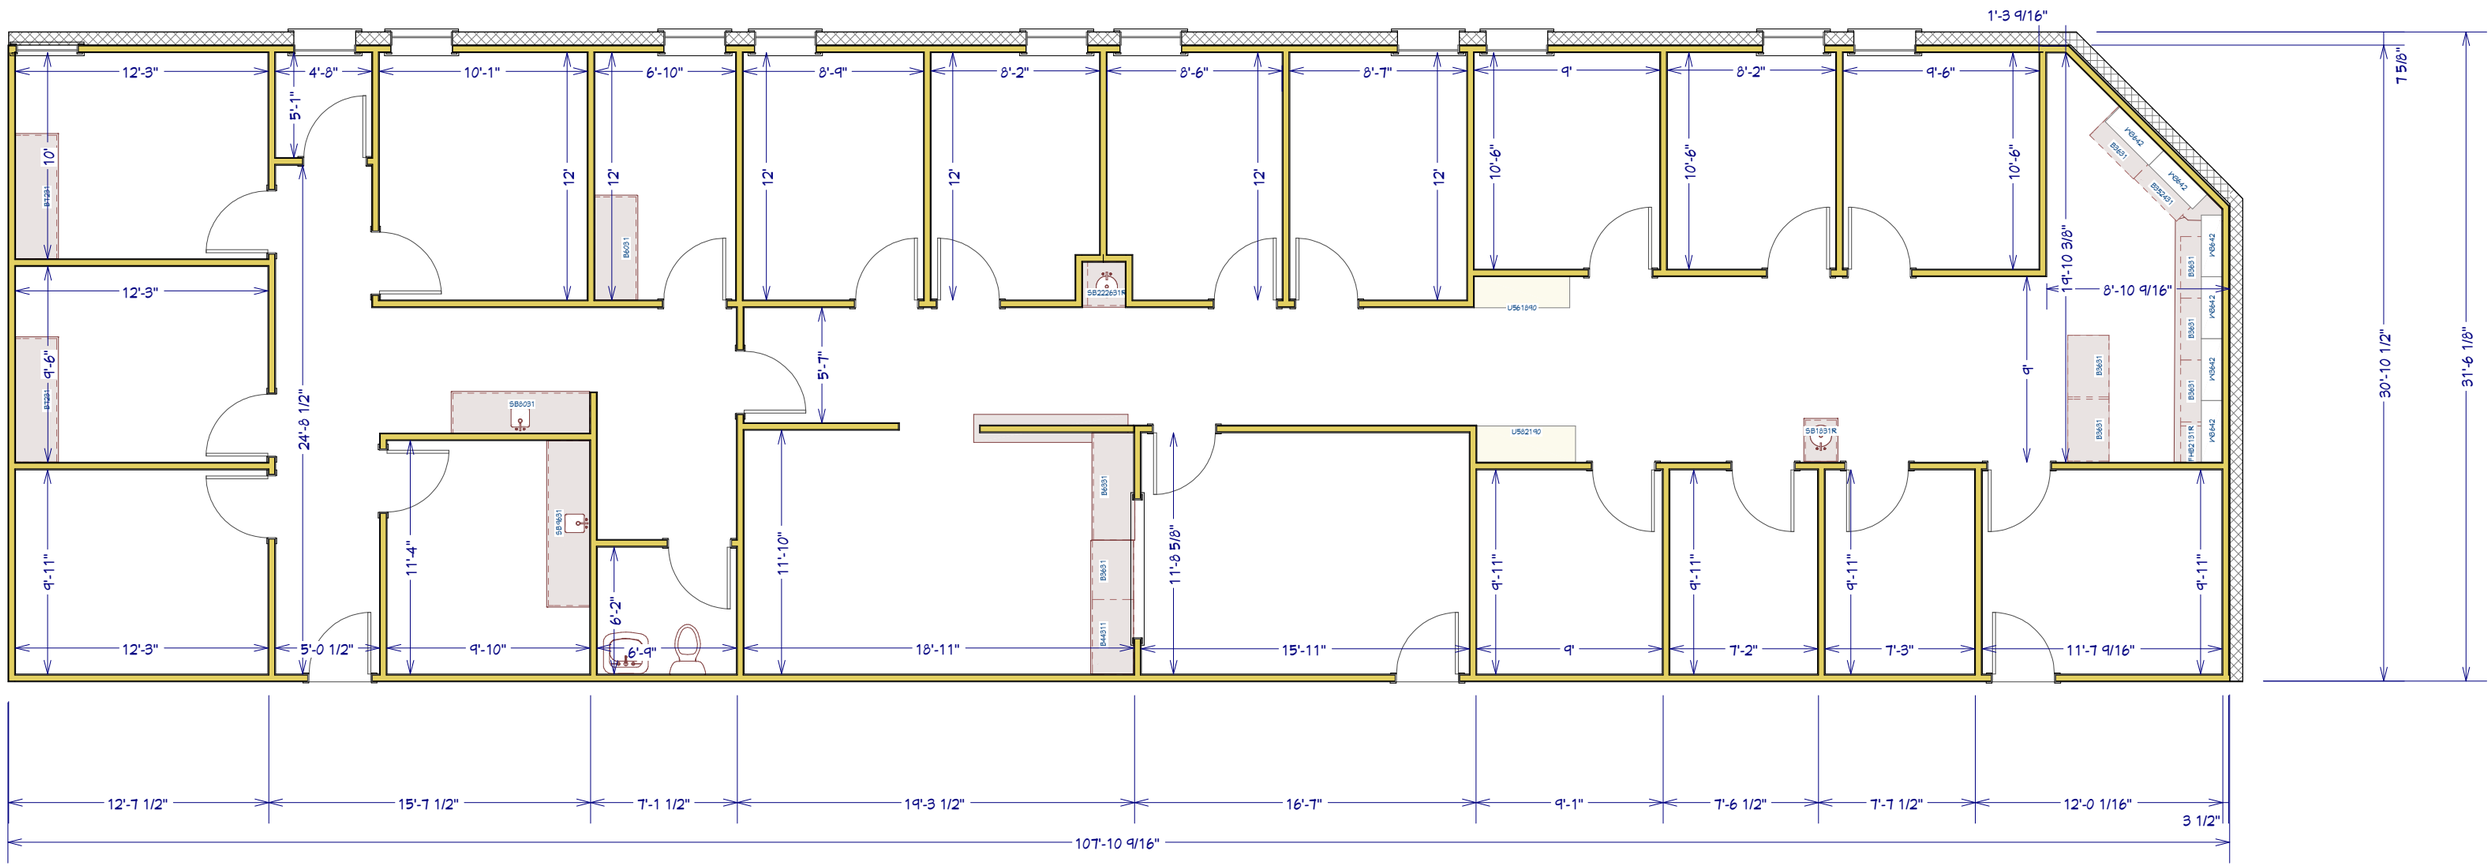

Office Space
3738 sqft (3398 x 10% Load)