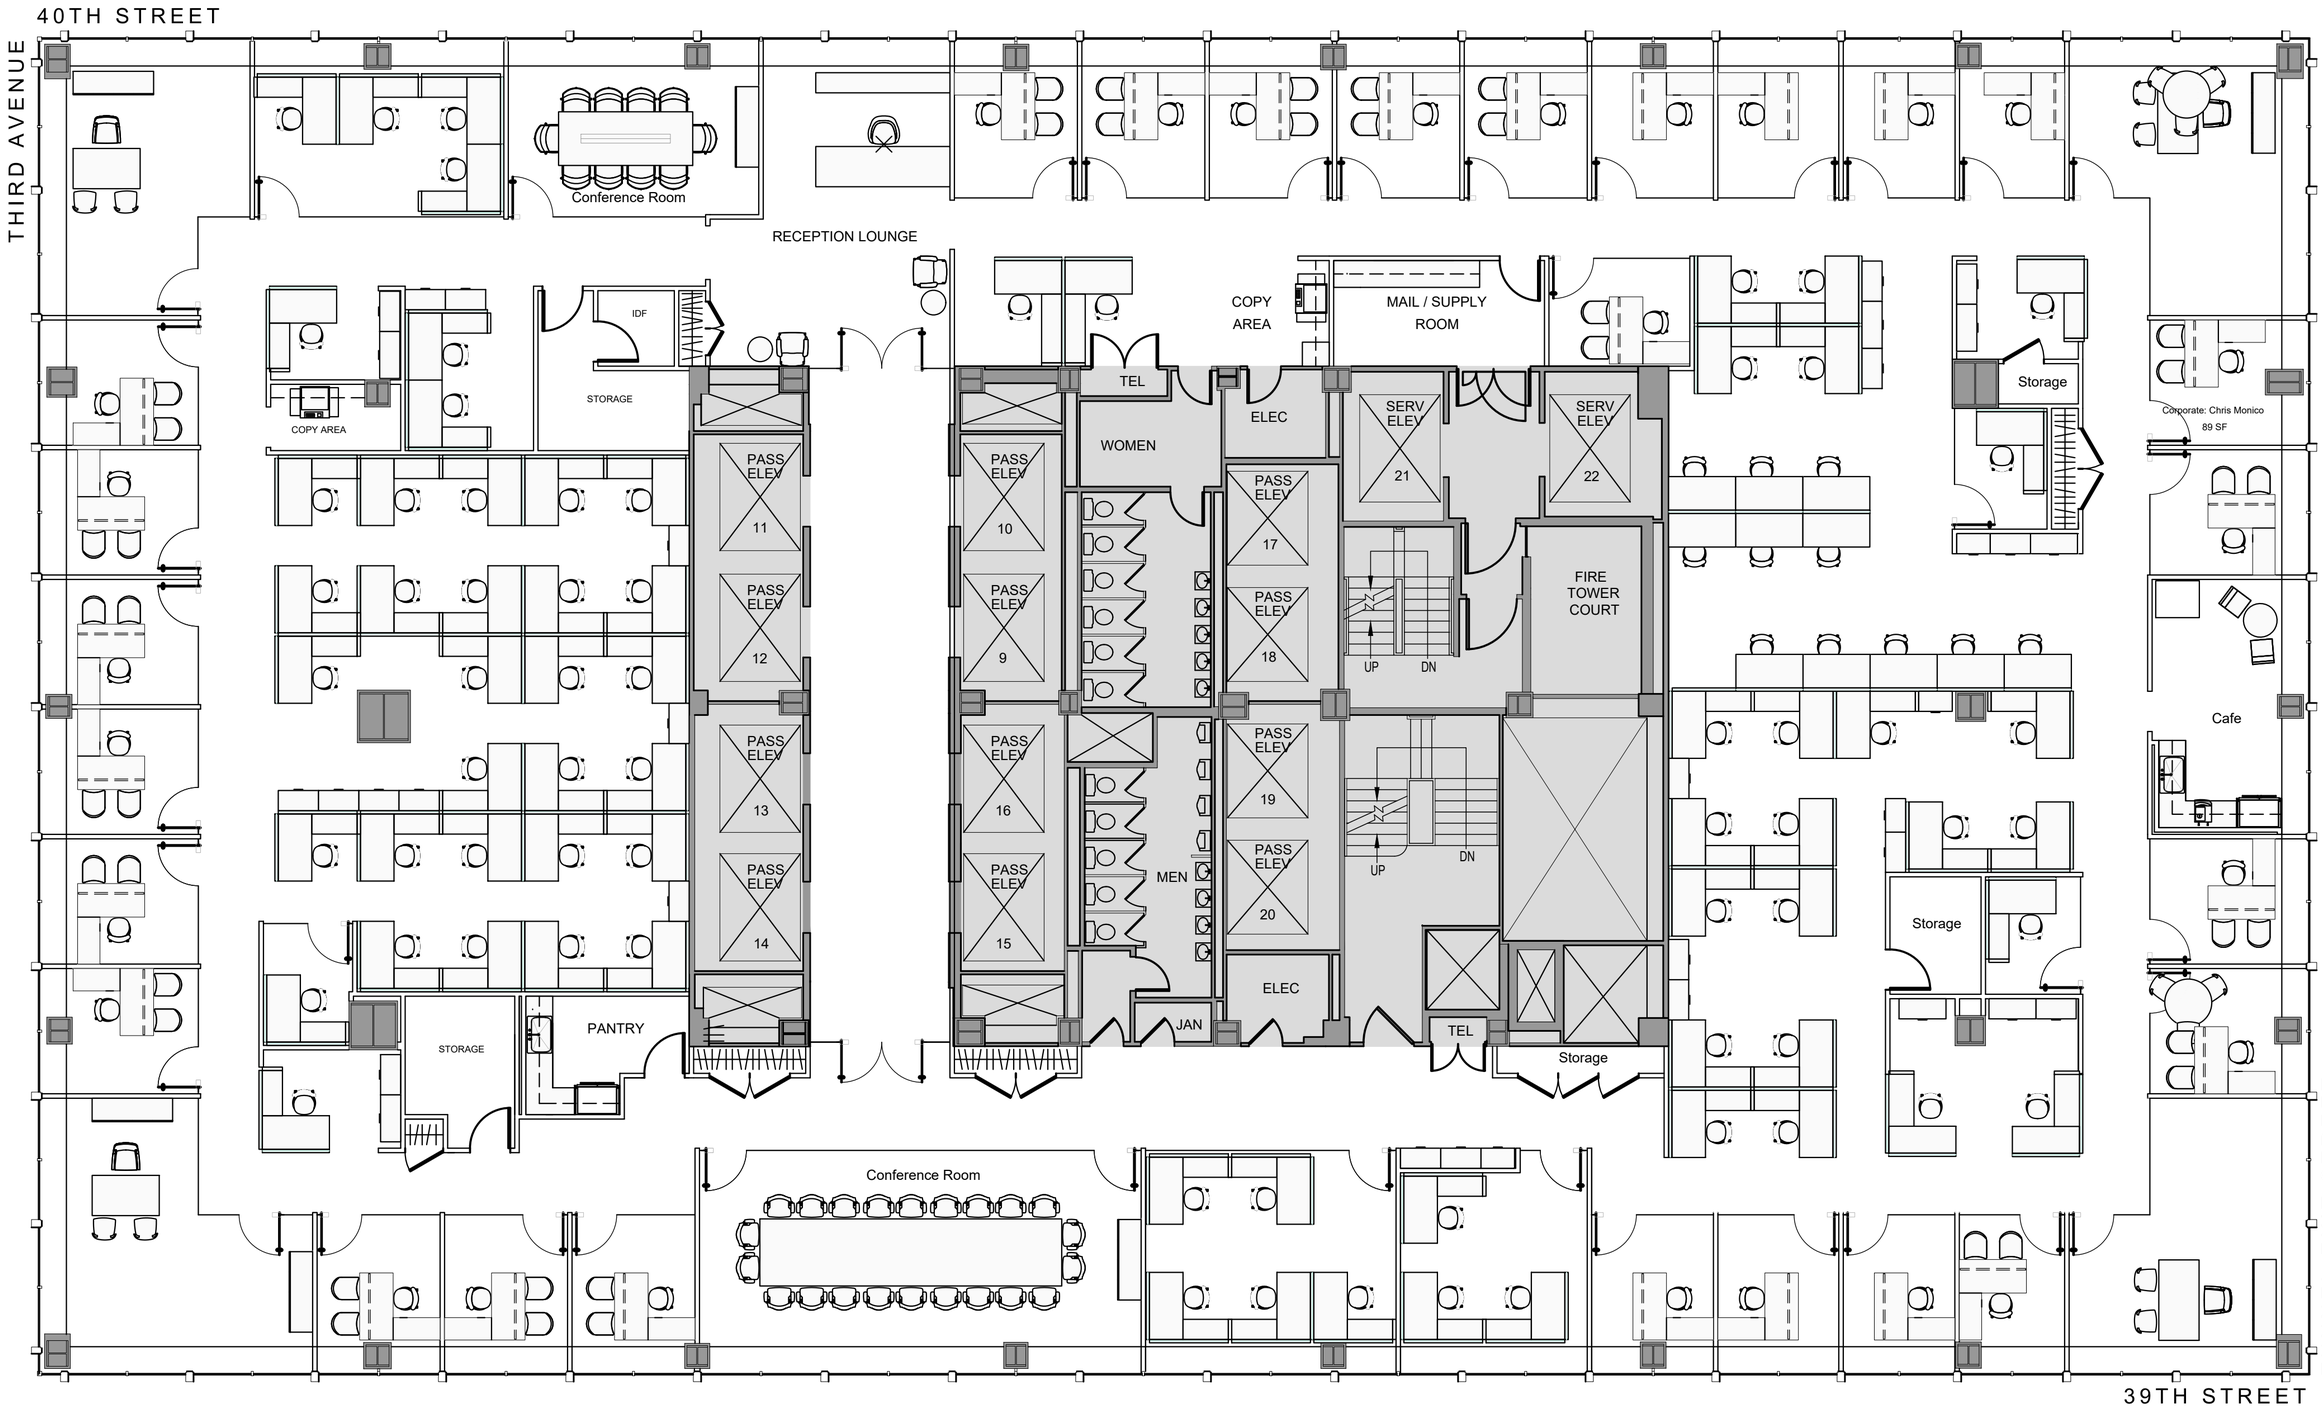

605

THIRD AVENUE

19TH FLOOR | **AS BUILT** | 08.31.20

MKDA
902 BROADWAY, NEW YORK, NY 10010, TELE 212 532-9800 FAX 212 889-2180

Z:\605 3rd Avenue\19th and 24th floor VW\2020 VW As Built Plan\2020.08.31_605 Third_19 & 24_As Built.dwg Plotted: Aug 31, 20 - 4:56pm hgershen

3' 12' 24'
SCALE

© 2018 MKDA, INC.