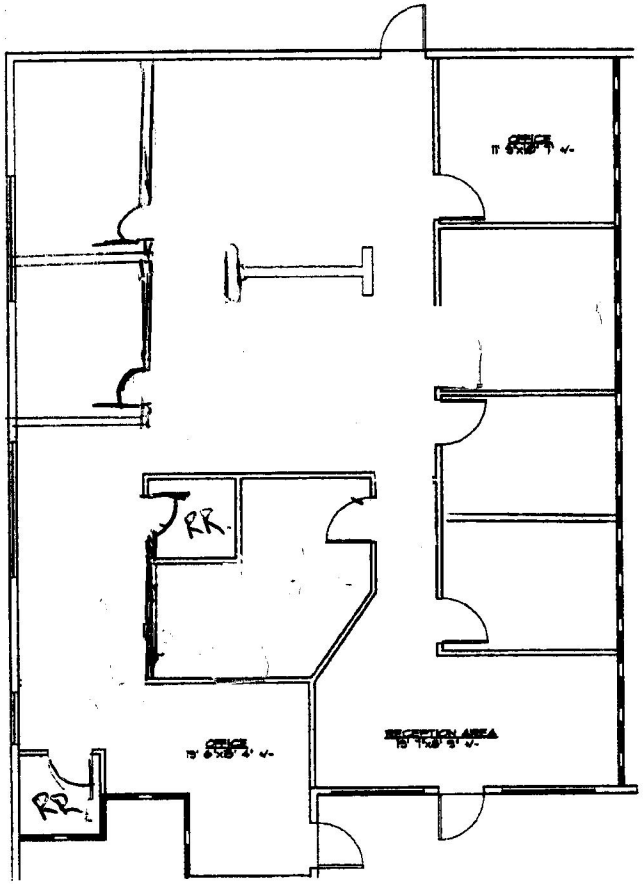


ISLAND LAKE CENTER

WEST STATE ROAD 434
LONGWOOD, FL 32750

2ND FLOOR
SUITE 228

2,198 □' ±

AS-BUILT FLOOR PLAN

THIS IS NOT A SURVEY. ALL DIMENSIONS ARE NOMINAL AND SUBJECT TO FIELD VERIFICATION.

0 4' 8' 16'

1/8"=1'-0"

KELLOGG DEVELOPMENT COMPANY

CHANTILLY COURT
9849 Hazelhurst Branch Rd., Suite C-2000
Winter Park, FL 32789

AS-BUILT FLOOR PLAN

NOT FOR CONSTRUCTION

PROJECT BY:
JOHNNY B. PALLO
200 Lyman Ave.
Winter Park, FL 32789
Ph. (407) 333-0114
Fax (407) 333-0115

BERLON & TAYLOR ARCHITECTS

PROJECT MANAGER:
JOHNNY B. PALLO

PROJECT ENGINEER:

228

SHEET 14 OF 19