


- 32,000 SF
- 8,000 SF
- 87,200 SF
- 49,407 SF

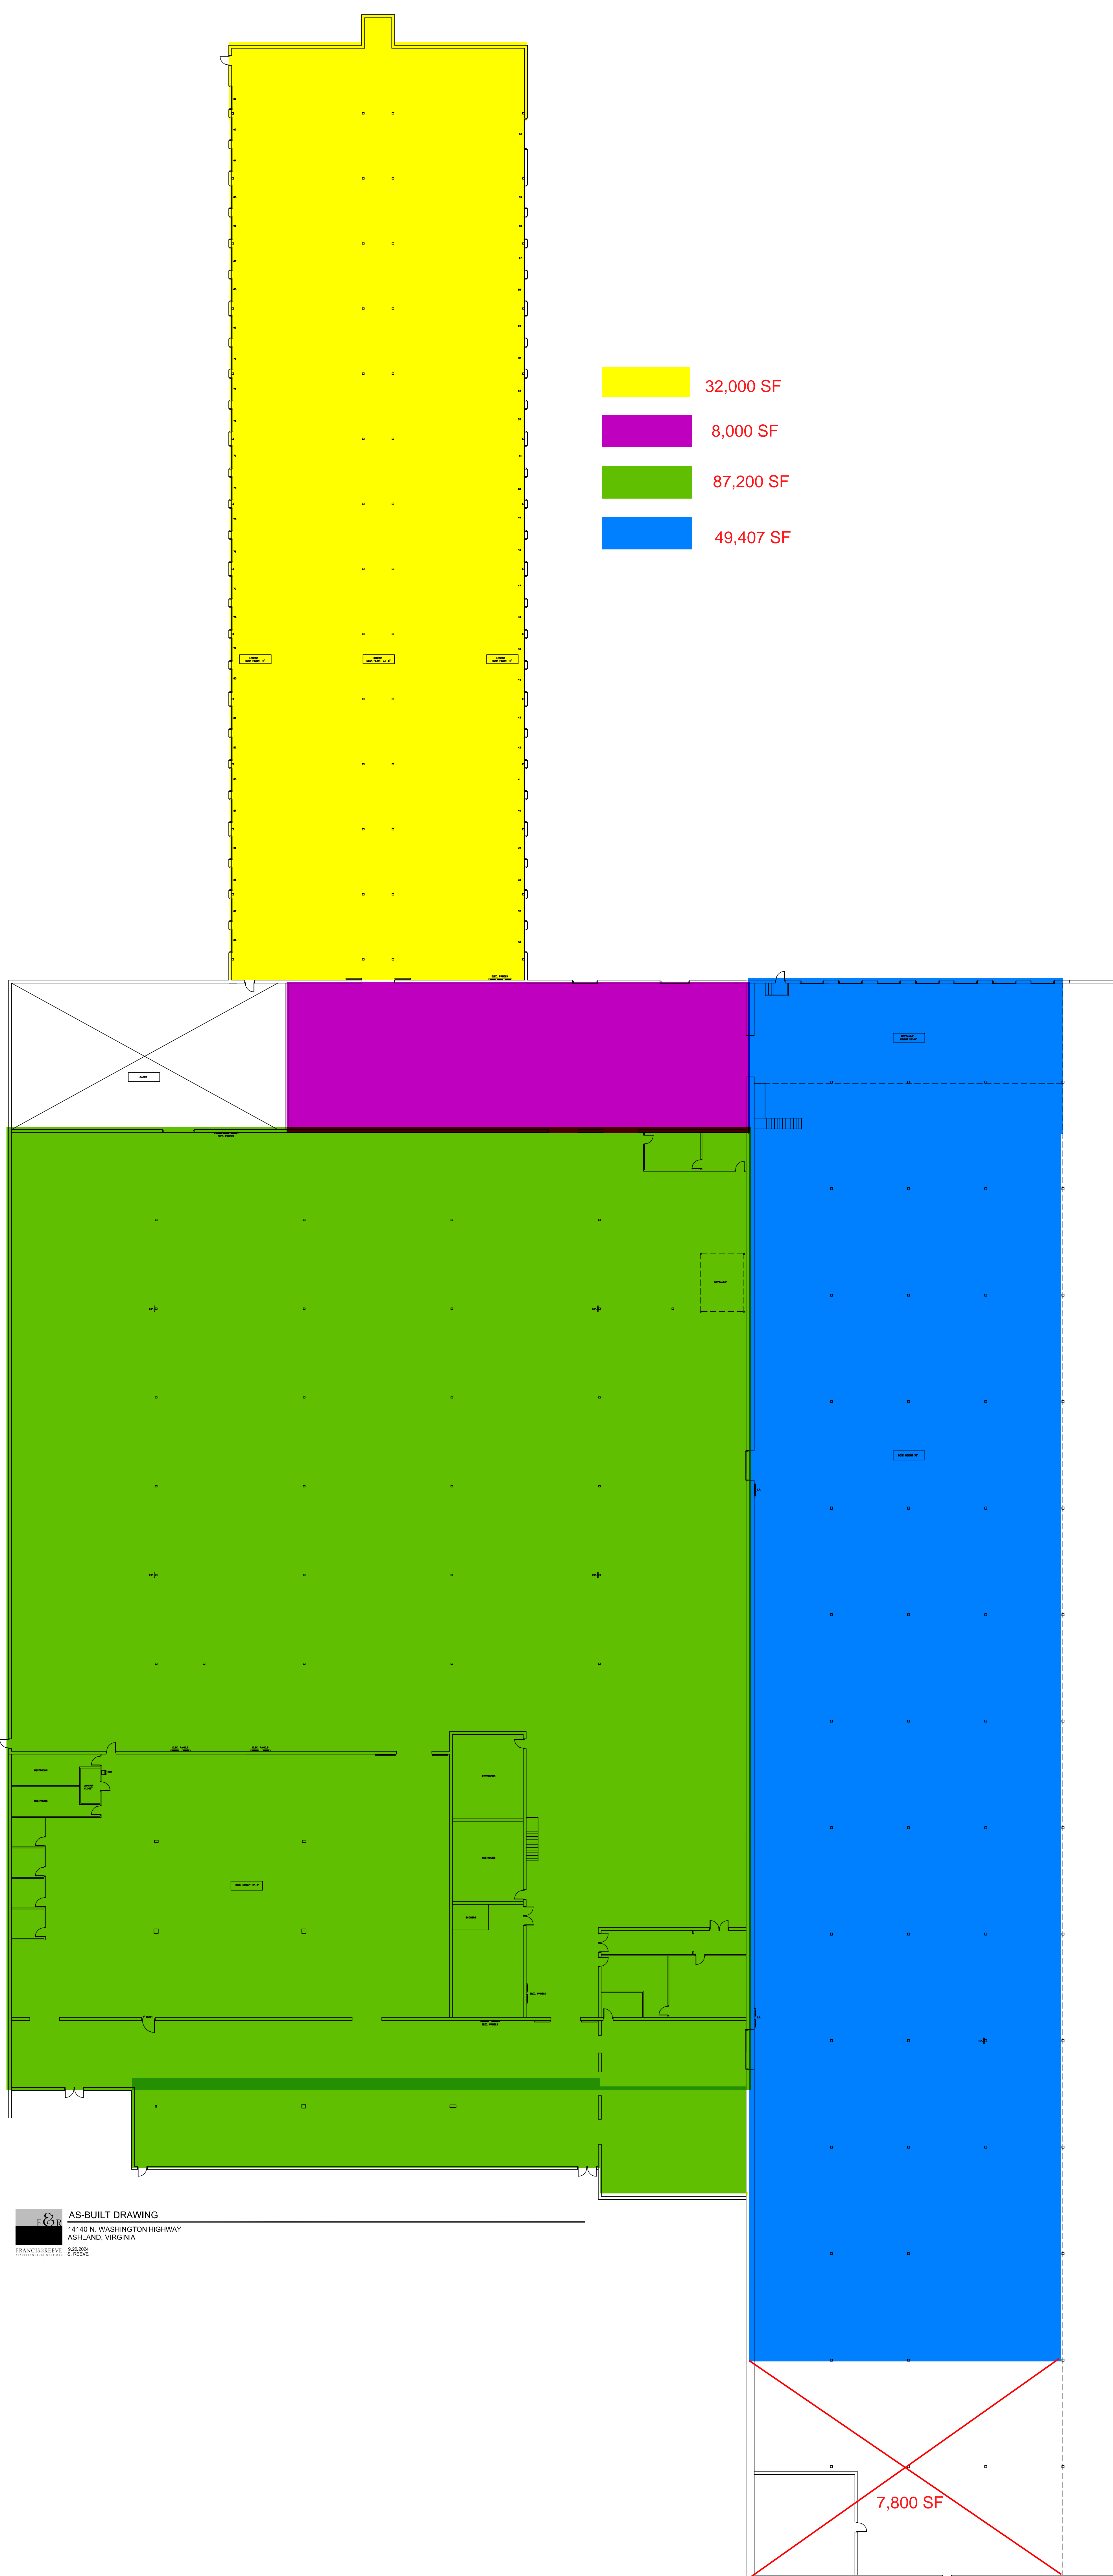

AS-BUILT DRAWING
14140 N. WASHINGTON HIGHWAY
ASHLAND, VIRGINIA
