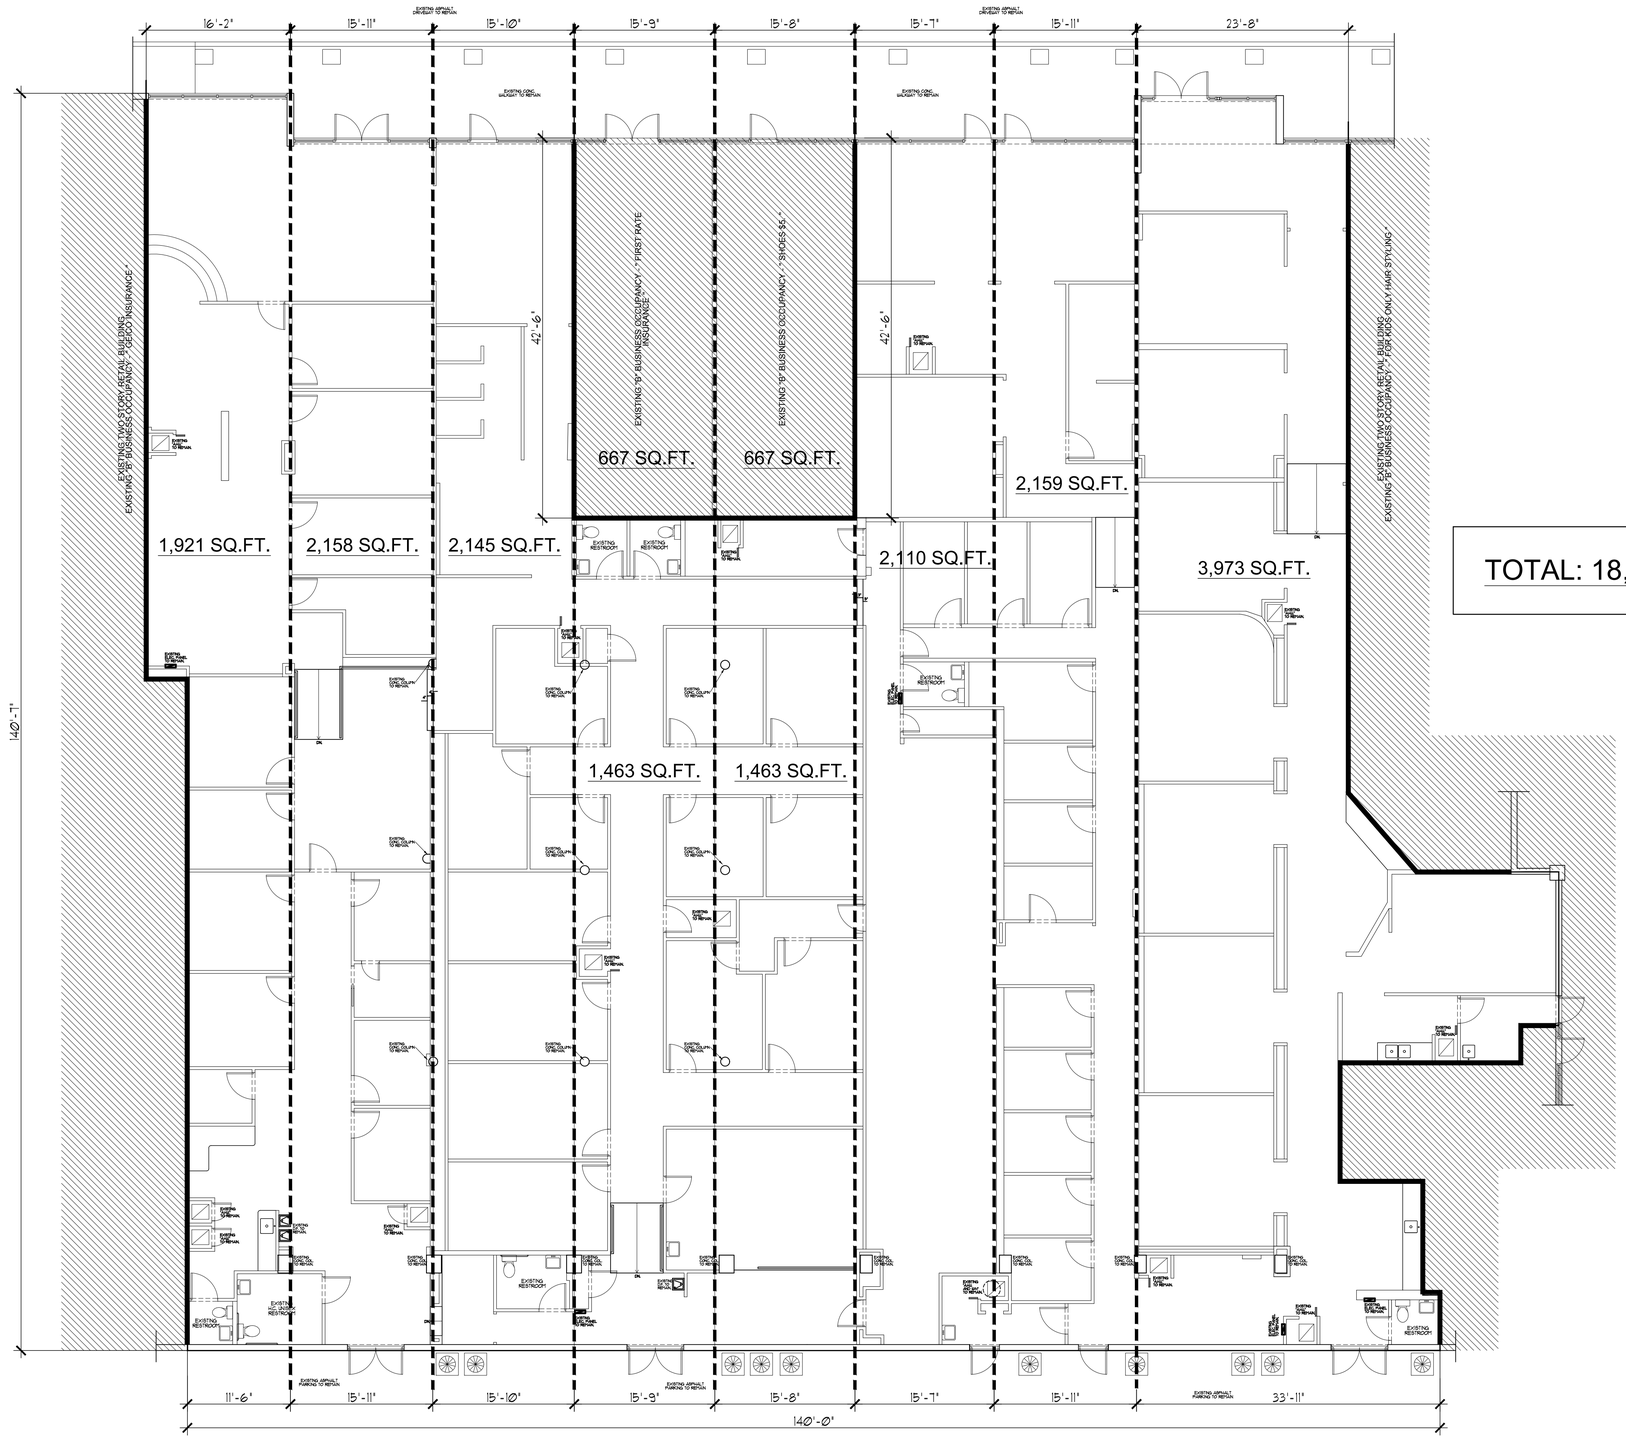

TOTAL: 18,726 SQ.FT.

EXISTING FLOOR PLAN

1/8" = 1'-0"

N

REVISIONS	BY

OCTAVIO A. SANTURIO A.I.A.
FL. AR. 0007619

OCTAVIO A. SANTURIO A.I.A.
A R C H I T E C T
FL. AR. 0007619
6162 Bird Road, Suite 2E. - South Miami, Florida 33155
Office: (305) 664-4553 Fax: (305) 666-1413
E-mail: oas@santuriopartners.com

OWNER:
FESTIVAL PLAZA SHOPPING CENTER
8500 SW 8th. STREET
MIAMI, FLORIDA 33144

AS-BUILT FLOOR PLAN OF VACANT SPACES AT EXISTING BUILDING No. 7.

FESTIVAL PLAZA SHOPPING CENTER
8500 SW 8th. STREET
MIAMI, FLORIDA 33144

THIS DRAWING AND SPECIFICATIONS CONTAINS PROPRIETARY INFORMATION AND ARE THE PROPERTY OF OCTAVIO A. SANTURIO A.I.A. P.A. AND MAY NOT BE REPRODUCED, COPIED OR DISTRIBUTED WITHOUT THE EXPRESSED WRITTEN PERMISSION AND COMPENSATION OF OCTAVIO A. SANTURIO A.I.A. P.A.

DRAWN	JD
CHECKED	O.A.S.
DATE	AUGUST 2022
SCALE	AS SHOWN
JOB NO.	2010
SHEET	A-1