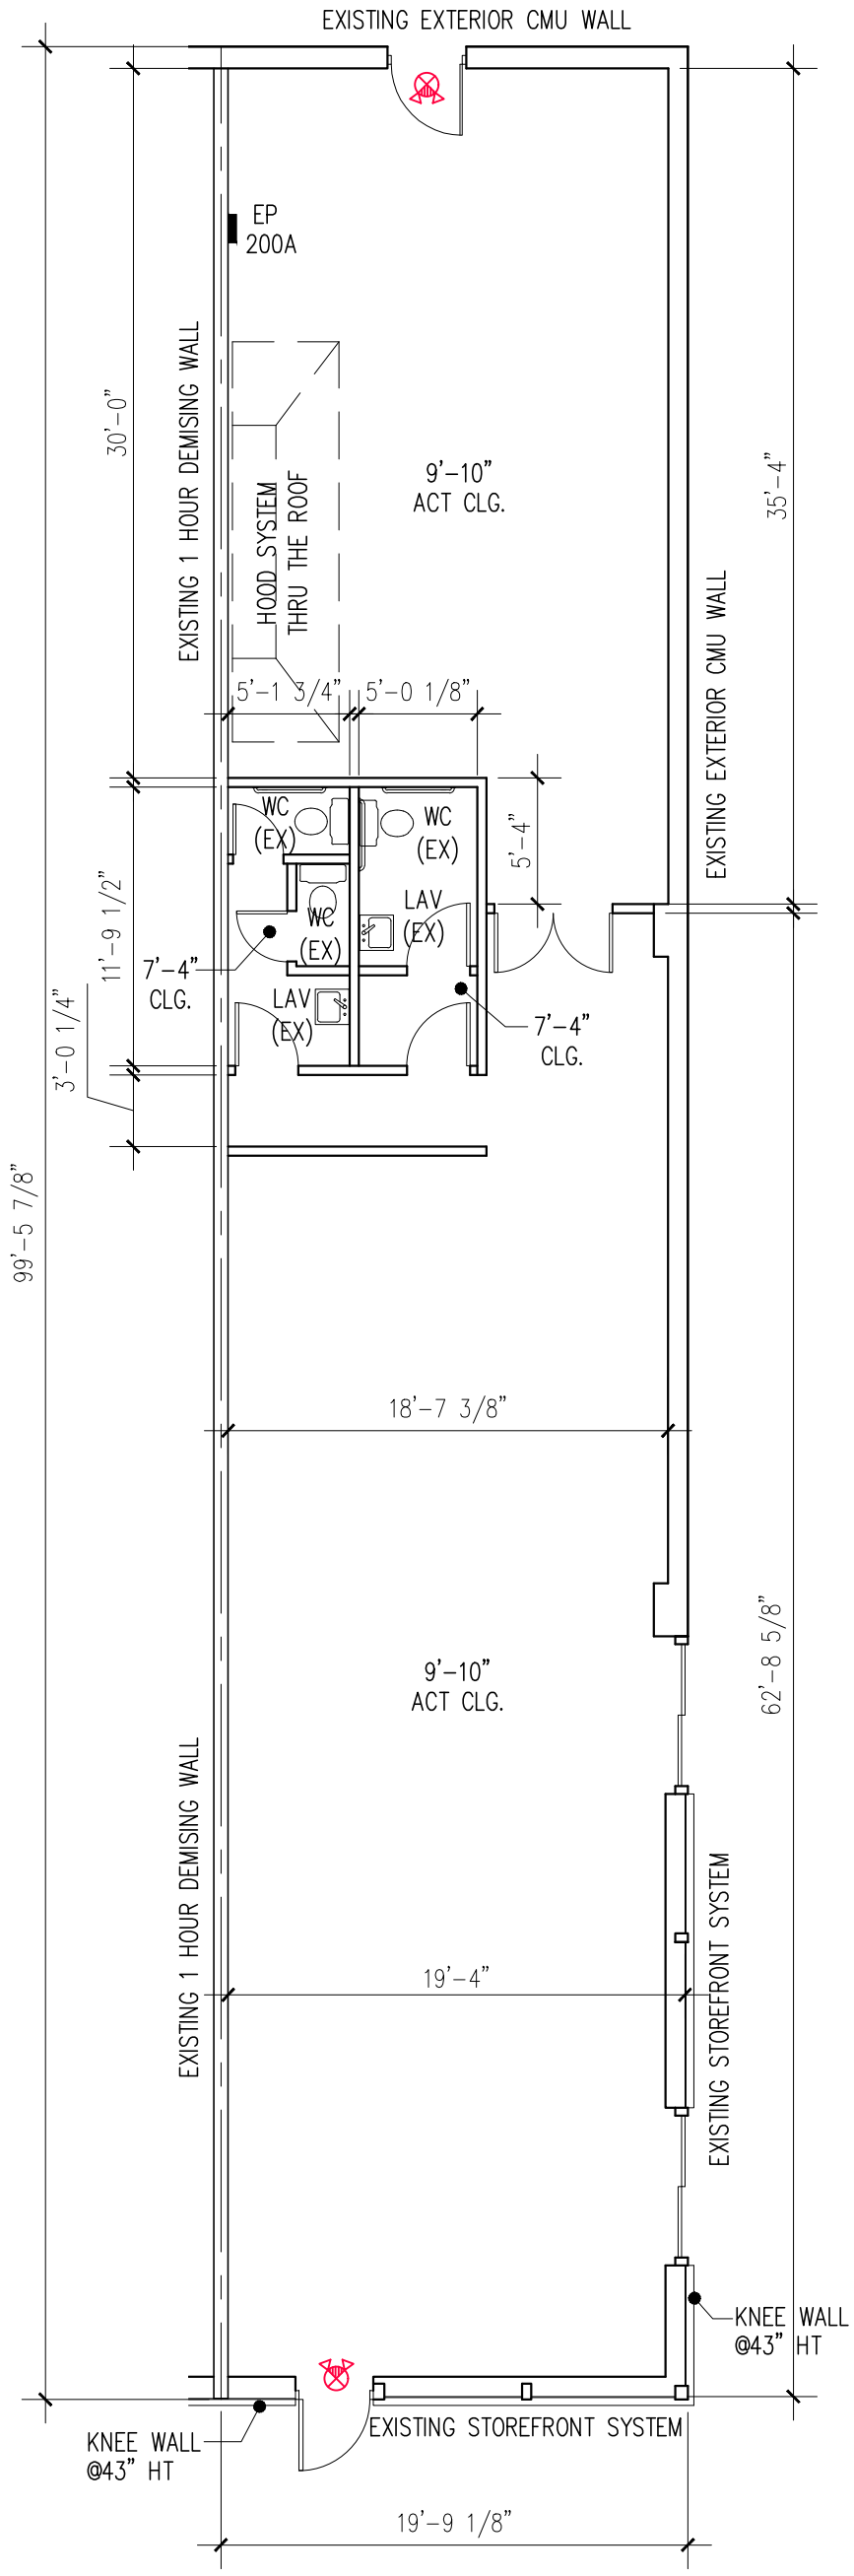

AS BUILT PLAN

SCALE: 1/8" = 1'-0"

LAKEWOOD PROMENADE UNIT 1619 2001 SQ FT

SLEIMAN
TCI CONSTRUCTION INC.

All reports, plans specifications, computer files, field data, notes and other documents and instruments prepared by the professionals listed and as instruments of service remain the property of TCI Construction. TCI Construction shall retain all common law, statutory and other reserved rights, including the copyright thereto. Any use or reproduction of this document without written permission from TCI Construction is a violation of Federal copyright laws.

Drawn By:	Checked By:	Approved By:
MC	MC	-
Scale : 1/8"=1'-0"	Date : 5-28-20	
Project Number: 2018-01Z		

Location: U:\Projects\Construction Projects\Lakewood Promenade\Building D_North\Interior\Unit 1619\LW_Unit 1619_1963sf.dwg