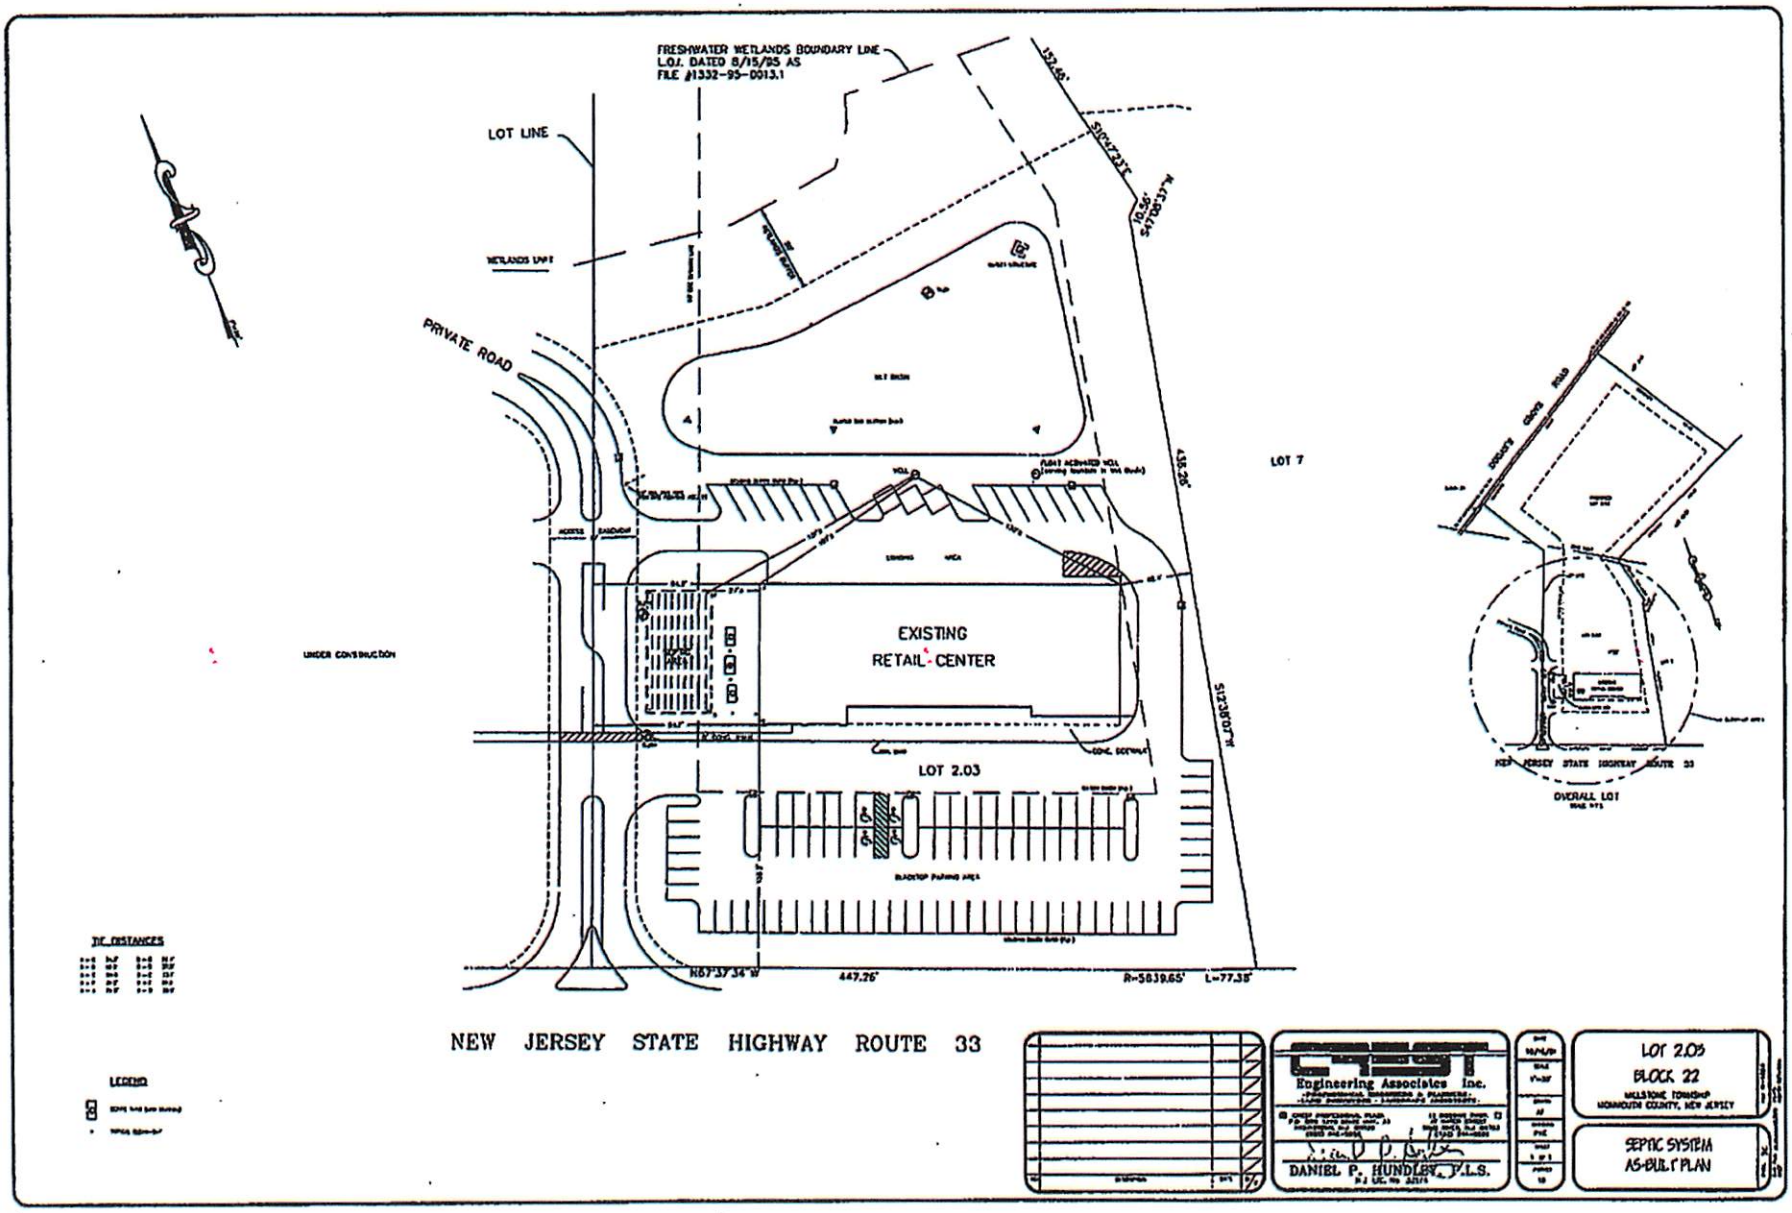
FRESHWATER WETLANDS BOUNDARY LINE
L.O.I. DATED 8/15/95 AS
FILE #1332-95-0013.1
LOT LINE
WETLANDS UNIT
PRIVATE ROAD
UNDER CONSTRUCTION
EXISTING
RETAIL CENTER
LOT 2.03
LOT 7
N67°37'34"W
447.26'
R=5839.65'
L=77.38'
S12°30'07"W
435.26'
S17°08'37"W
10.56'
S12°47'31"E
152.65'
NEW JERSEY STATE HIGHWAY ROUTE 33
OVERALL LOT
TIE DISTANCES
LEGEND
Engineering Associates Inc.
DANIEL P. HUNDLEY, P.L.S.
LOT 2.03
BLOCK 22
HILLSTONE TOWNSHIP
MONMOUTH COUNTY, NEW JERSEY
SEPTIC SYSTEM
AS-BUILT PLAN