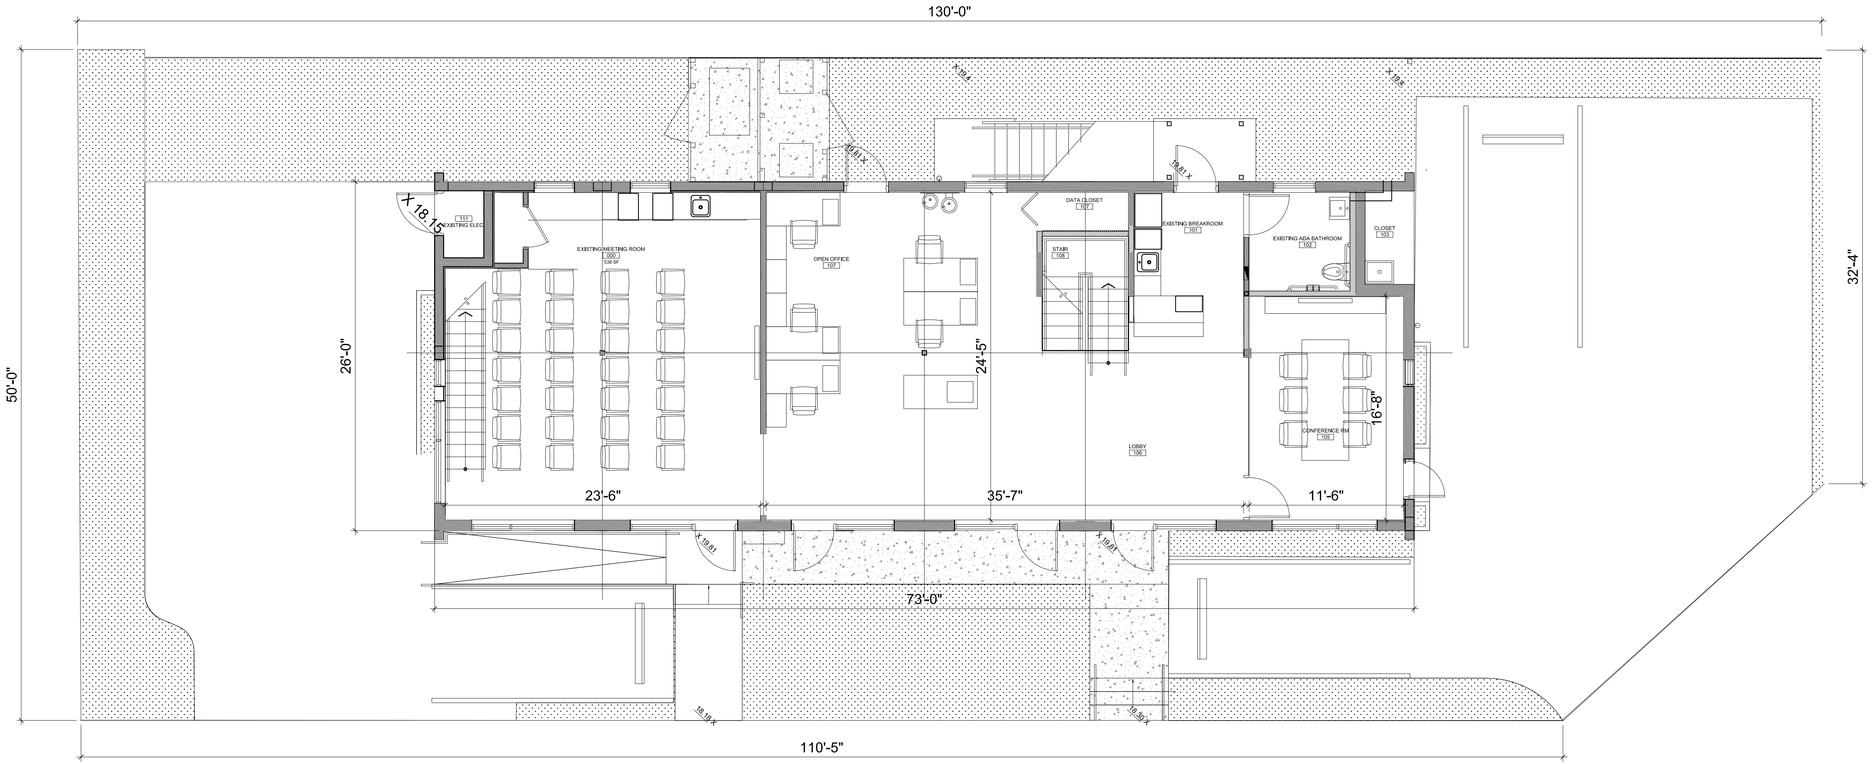

1 GROUND FLOOR AS BUILT PLAN
SCALE: 3/8" = 1'-0"

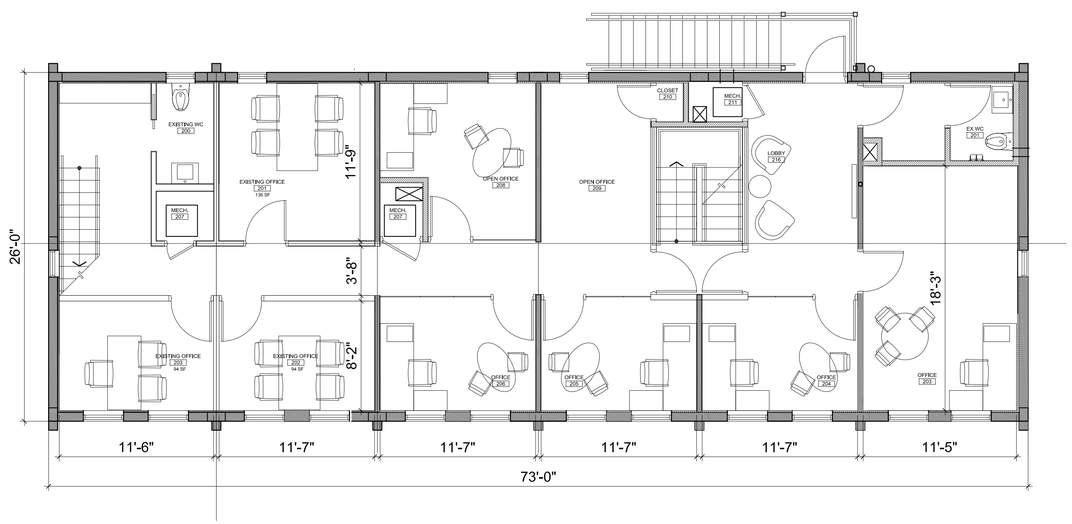

2 SECOND FLOOR AS BUILT PLAN
SCALE: 3/8" = 1'-0"

MAK work

ARCHITECTURE
ALYSSA KRIPLEN AR100146

LANDSCAPE ARCHITECTURE
MARSH KRIPLEN
LA FL6667007

1251 SW 20th St
MIAMI FL 33145
T: 305 310 2602

COPYRIGHT©MAKWORK INC. ALL RIGHTS RESERVED. THESE DRAWINGS AND SPECIFICATIONS AREINSTRUMENTS OF SERVICE AND SHALL REMAIN THE PROPERTYOF MAKWORK, INC. WHETHER THE PROJECT FOR WHICH THEYWERE PREPARED IS EXECUTED OR NOT. THEY ARE NOT TO BE USED IN ANY MANNER ON OTHER PROJECTS OR FOR ADDITIONS TO THIS PROJECT BY AGREEMENT IN WRITING ANDWITH THE APPROPRIATE COMPENSATION TO MAKWORK, INC.REPRODUCTIONS OF SPECIFICATIONS WITHOUT THE WRITTEN CONSENT OF MAKWORK, INC. IS PROHIBITED.

PROJECT AND OWNER

3139 SW 27TH AVE
MIAMI FL

CONSULTANTS

-
-

T: -
F: -

SEAL

ALYSSA L. KRIPLEN AR100146

PROJECT NO.	18113
DESIGNED BY	-
DRAWN BY	-
CHECKED BY	-
DATE	03/16/2026

ISSUED FOR:

DRAWING SCALE

DRAWING TITLE

AS BUILT PLANS

DRAWING NUMBER

AB-101

C:\USERS\ALYSS\ONEDRIVE\DOCUMENTS\MAKWORK\03-PROJECTS\2018\18113 3139 SW 27TH AVE\DRAWINGS\SHEETS\AS BUILT\2026 0316 3139 AS BUILT.DWG Modified: 3/16/26 12:23 Printed: 3/16/26 12:24