DO NOT SCALE DRAWINGS WRITTEN DIMENSIONS SHALL ALWAYS SUPERCEDE ALL AND ANY SCALED DIMENSIONS. CONTRACTORS SHALL VERIFY AND BE FULLY RESPONSIBLE FOR ALL DIMENSIONS ON THE JOB SITE. ARCHITECT SHALL BE NOTIFIED OF ANY DISCREPANCIES PRIOR TO COMMENCEMENT OF CONSTRUCTION.

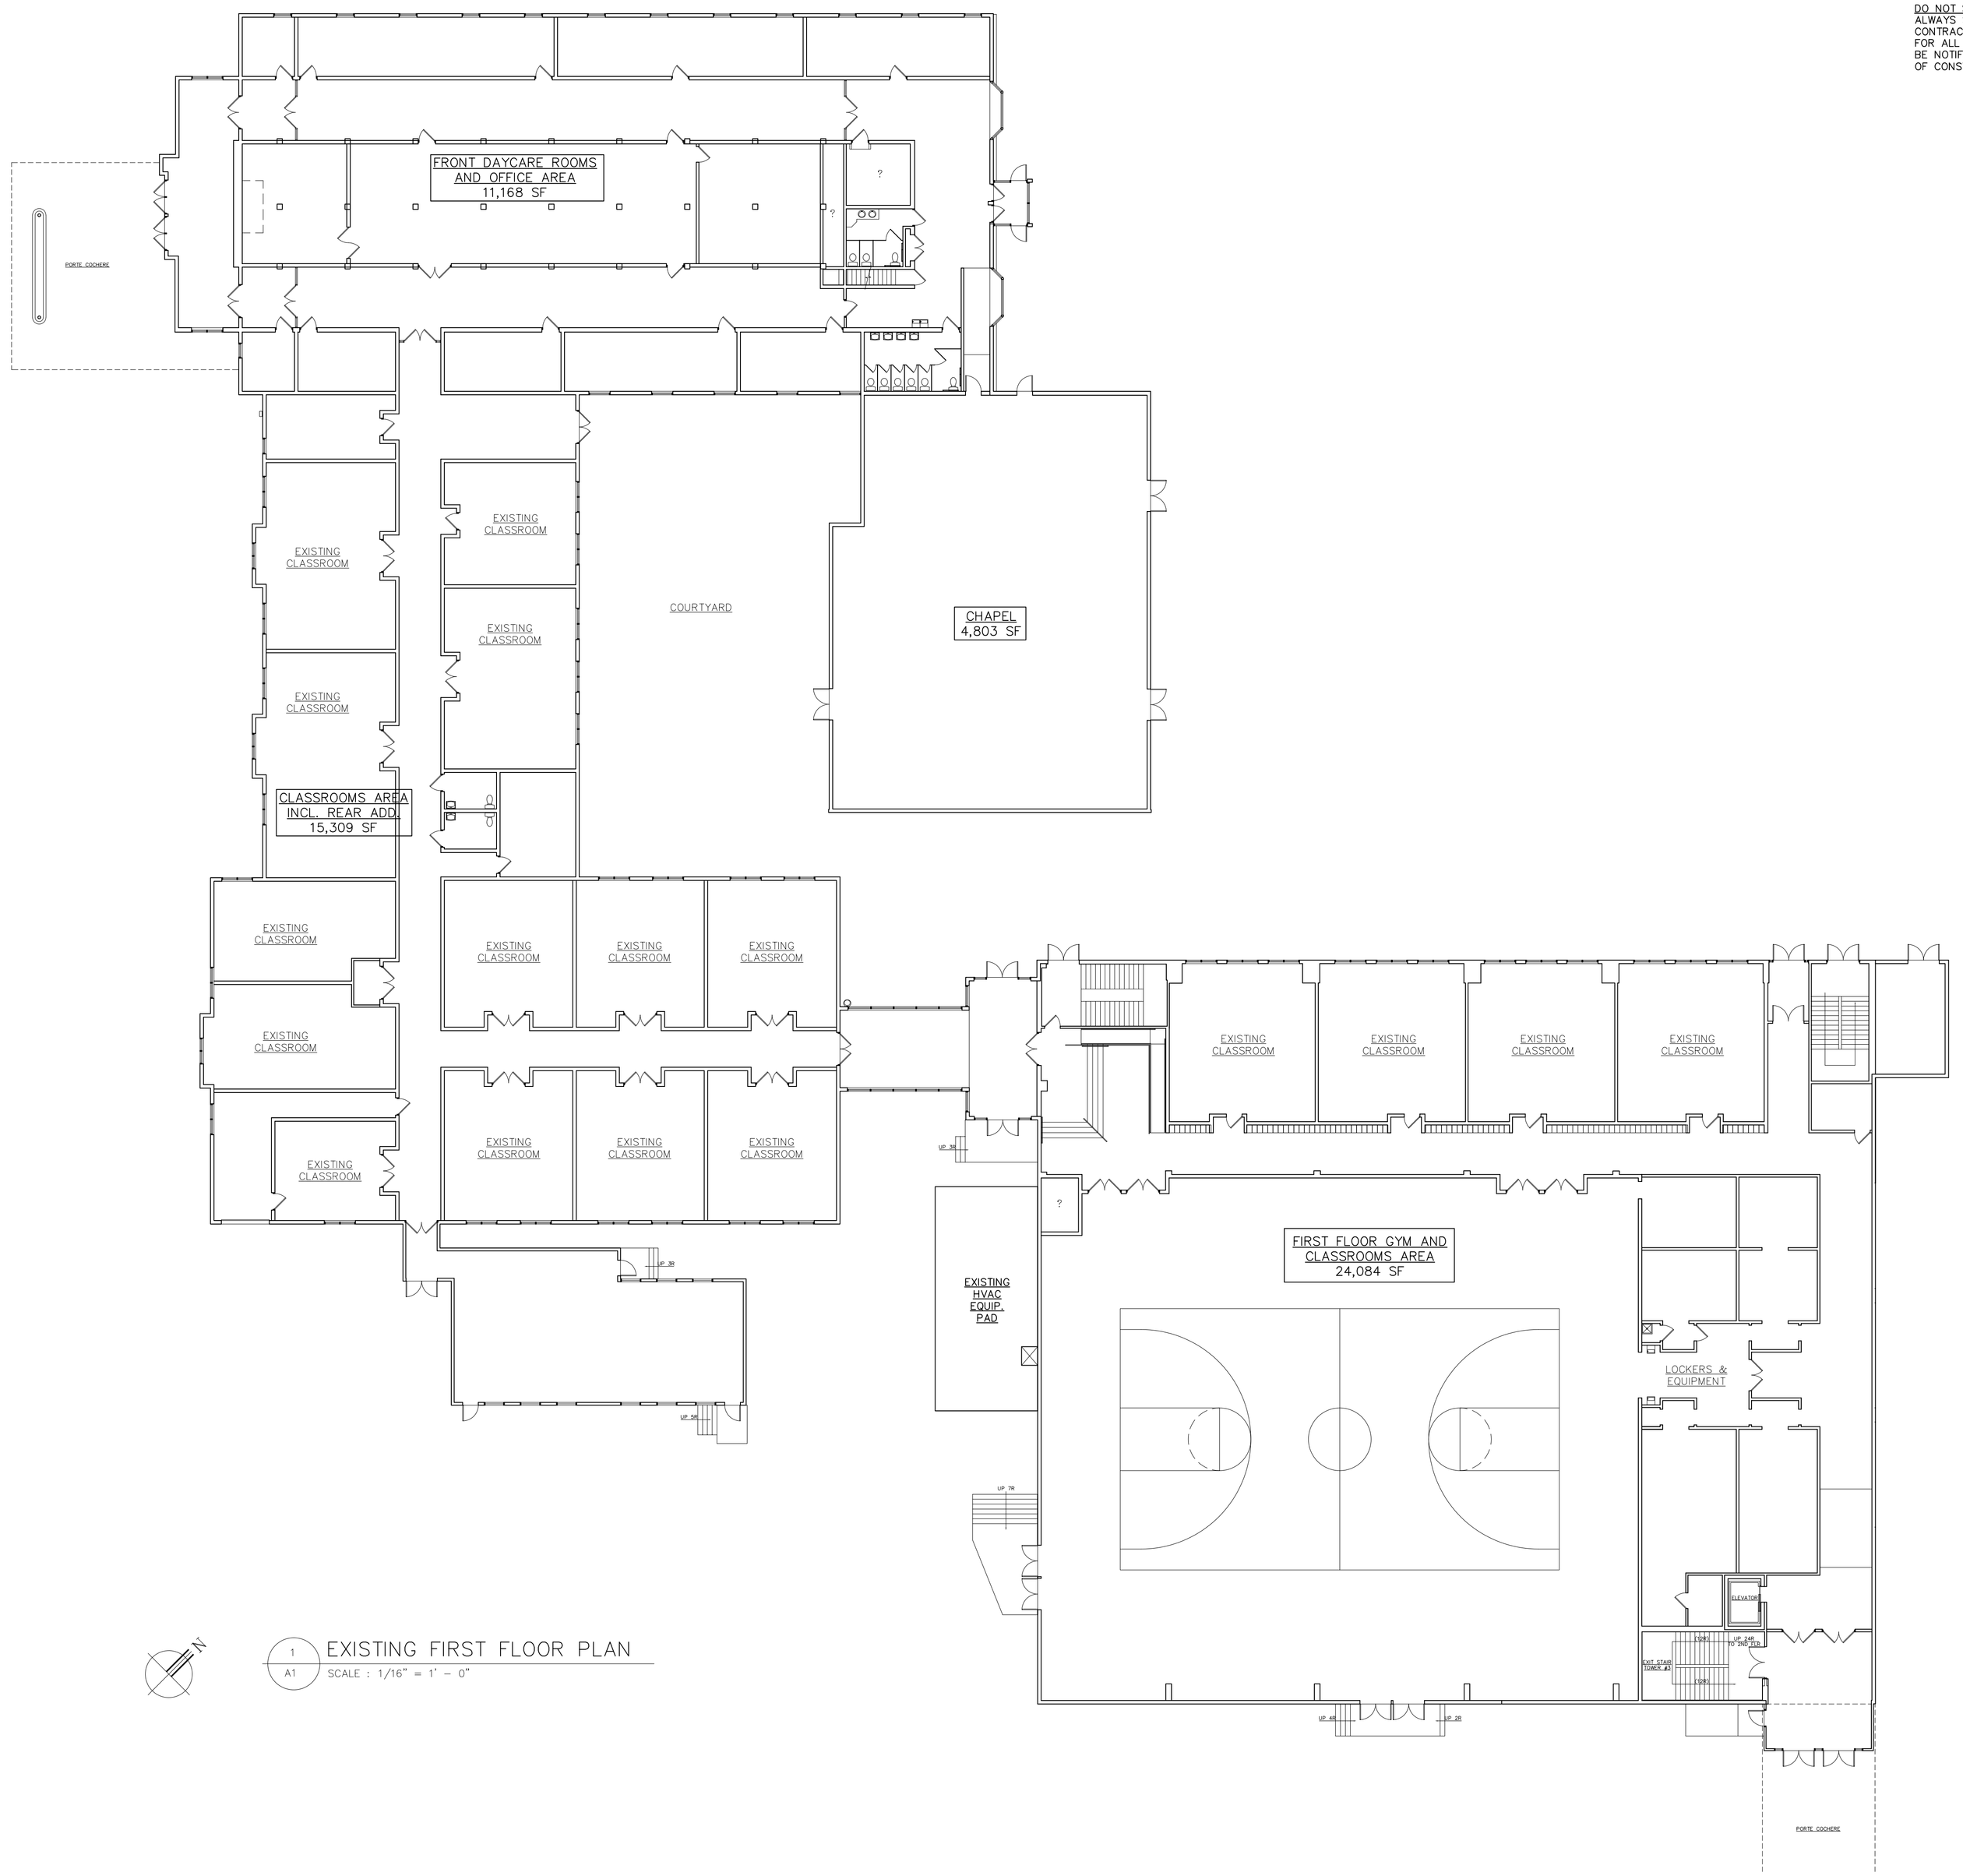

1 / A1 EXISTING FIRST FLOOR PLAN
SCALE : 1/16" = 1' – 0"

REVISIONS	BY

Michael S. Scarpa
Registered Architect
1177 6th St.
Whitehall, PA 18052
(484) 553-9710
Mike@pa-venture.net

COPYRIGHT PA VENTURE CAPITAL & MICHAEL SCARPA, RA
REPRODUCTION OF DRAWINGS OR SPECIFICATIONS WITHOUT THE CONSENT OF PA VENTURE CAPITAL & MICHAEL SCARPA, RA, VIOLATES COPYRIGHT LAW OF THE UNITED STATES.

Existing:
Tobyhanna Charter School
1110 Carriage Lane
Tobyhanna, PA 18466

DRAWN	MSS
CHECKED	
DATE	5-16-25
SCALE	AS NOTED
JOB NO.	--
PLANS	
	A-1