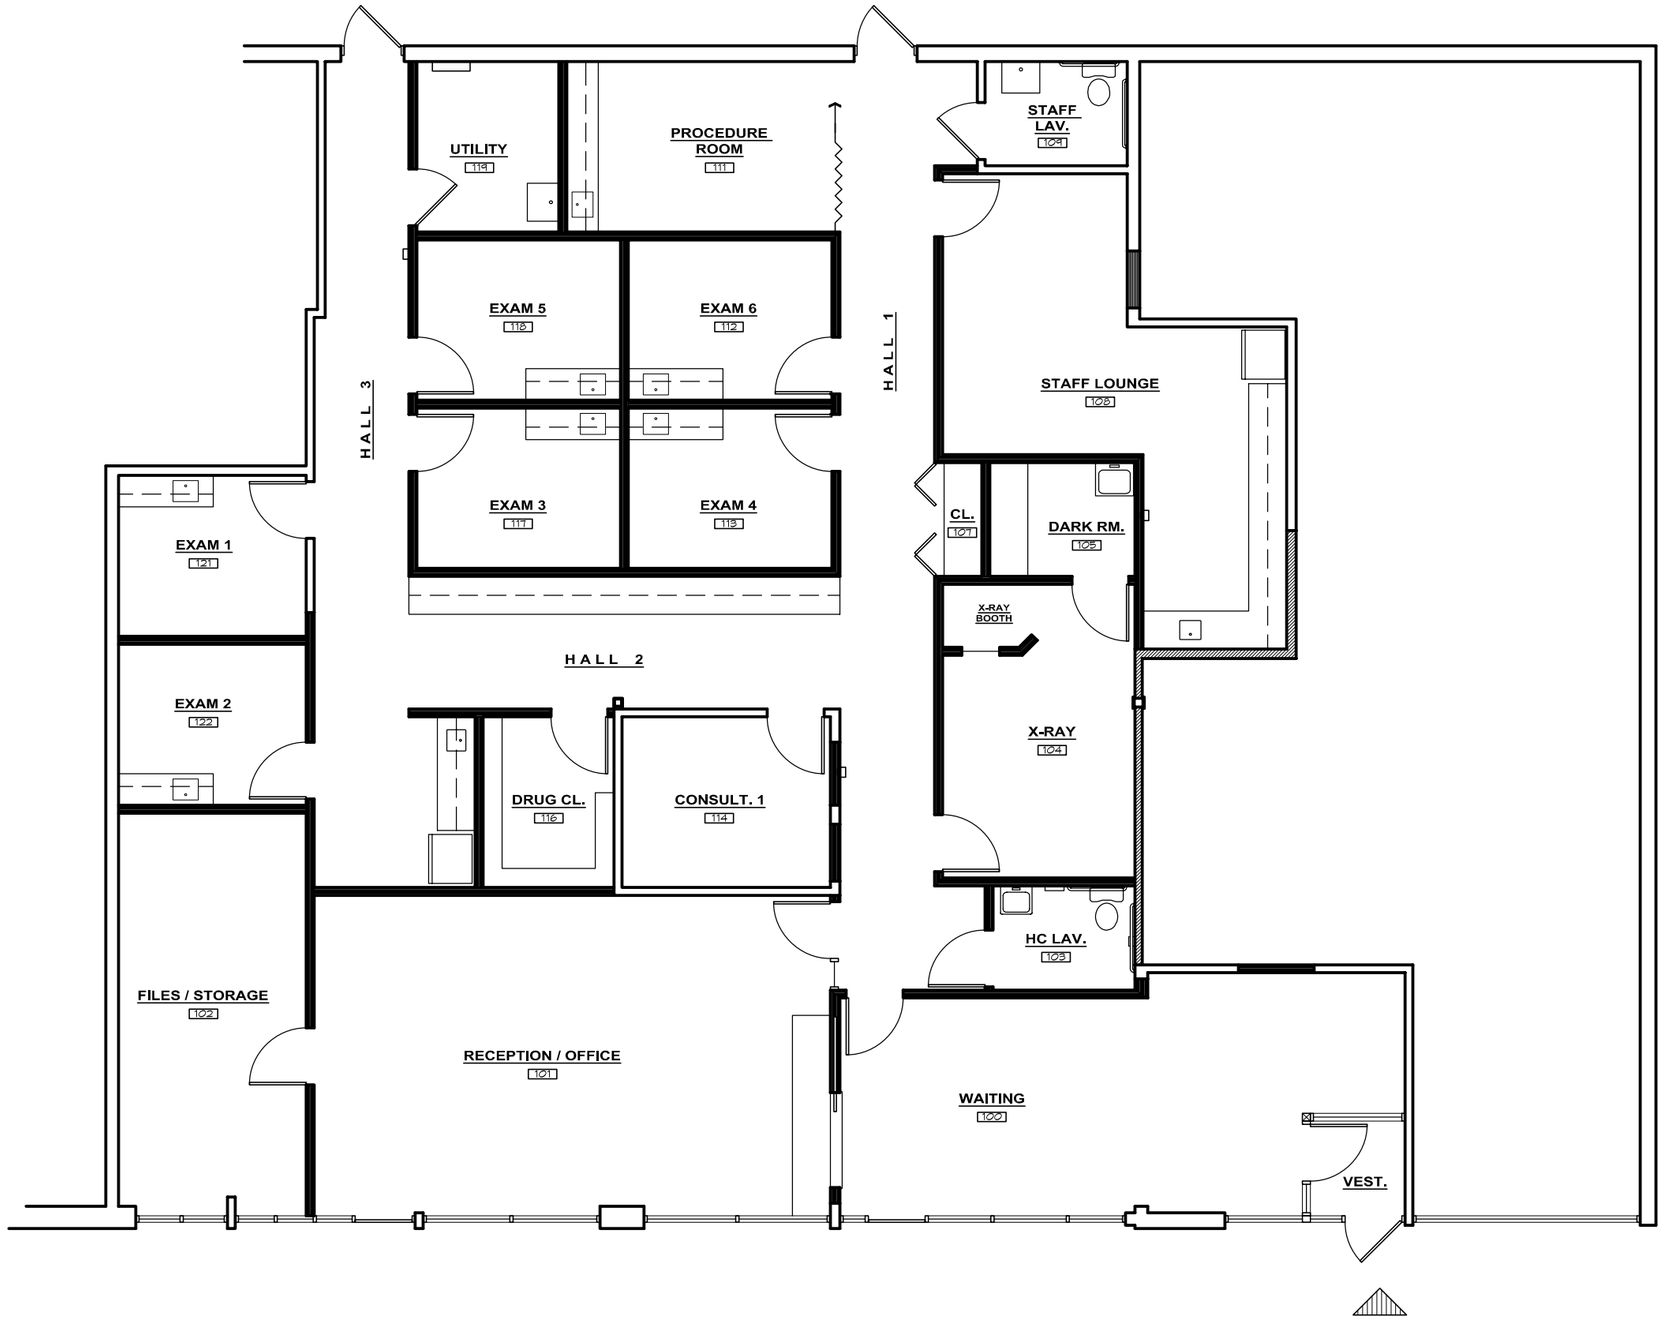
UTILITY
119
PROCEDURE ROOM
111
STAFF LAV.
108
EXAM 5
110
EXAM 6
112
HALL 3
HALL 1
STAFF LOUNGE
106
EXAM 3
117
EXAM 4
113
CL.
107
DARK RM.
105
EXAM 1
121
X-RAY BOOTH
HALL 2
EXAM 2
122
X-RAY
104
DRUG CL.
116
CONSULT. 1
114
HC LAV.
103
FILES / STORAGE
102
RECEPTION / OFFICE
101
WAITING
100
VEST.