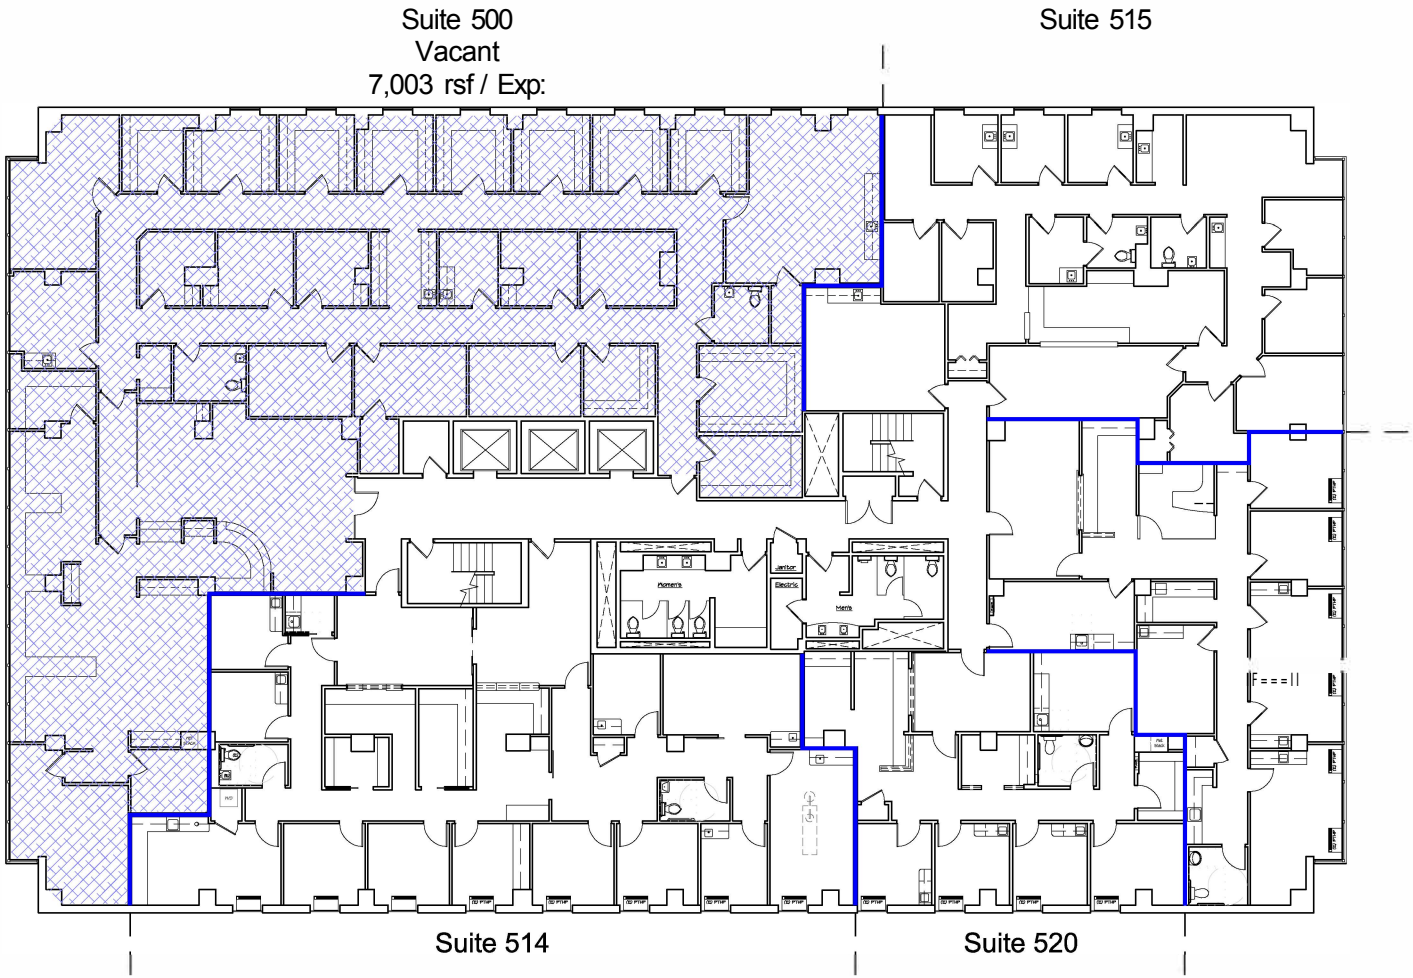

Fifth Floor

CB|31.nc.
architecture
703.378.7222 p/f
www.chj3architecture.com

Yorktown 50 MOB

8316 Arlington Blvd
Fairfax, Virginia 22031

March 14, 2024