LEGEND

- EXISTING EXTERIOR WALL
- EXISTING INTERIOR WALL
- EXISTING DEMISING WALL

KEYNOTES

1. EXISTING STOREFRONT DOOR
2. EXISTING STOREFRONT GLAZING AND MULLIONS
3. EXISTING DEMISING WALL
4. EXISTING EXTERIOR DOOR
5. EXISTING INTERIOR DOOR
6. EXISTING ELECTRICAL PANEL
7. EXISTING PLUMBING FIXTURE
8. EXISTING WATER HEATER
9. EXISTING WASHER AND DRYER
10. EXISTING FLOOR RECEPTACLE

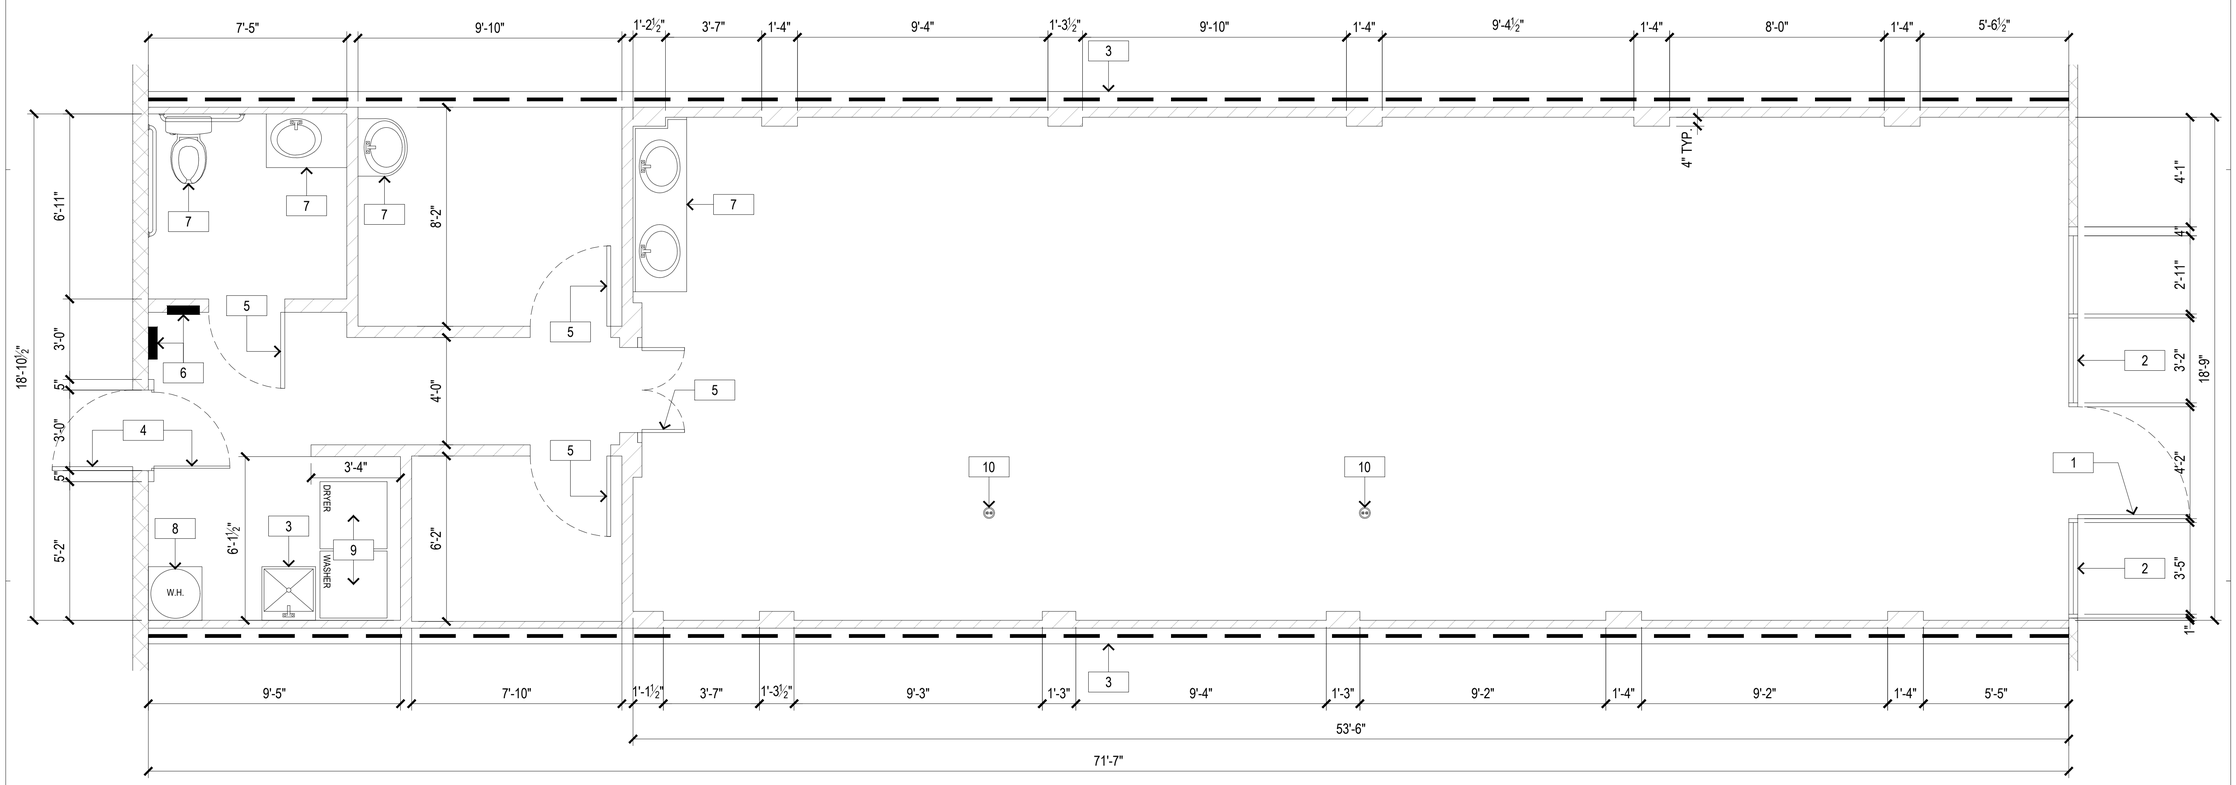

EXISTING FLOOR PLAN 3/8"=1'-0" 1

HESTIA ATELIER
DESIGN ARCHITECTURE

3 PETERS CANYON RD. STE110
IRVINE, CA. 92606

Seal

LICENSED ARCHITECT
KEERTI IRWANI
C-34970
REN. 09/30/27
STATE OF CALIFORNIA

Consultant

NAIL SALON

3033 BRISTOL ST. STE 119
COSTA MESA, CA 92626

EXISTING FLOOR PLAN

CUP NUMBER:
Plan Check Number:

SHEET

EX2.0

dwg last saved: Nov/25/2025 5:35 PM by Extra PC 2

sheet printed: Nov/25/2025 @ 5:35 PM
drawing file name: salon\x-survey cad drawings\ex2.0 - existing floor plan.dwg