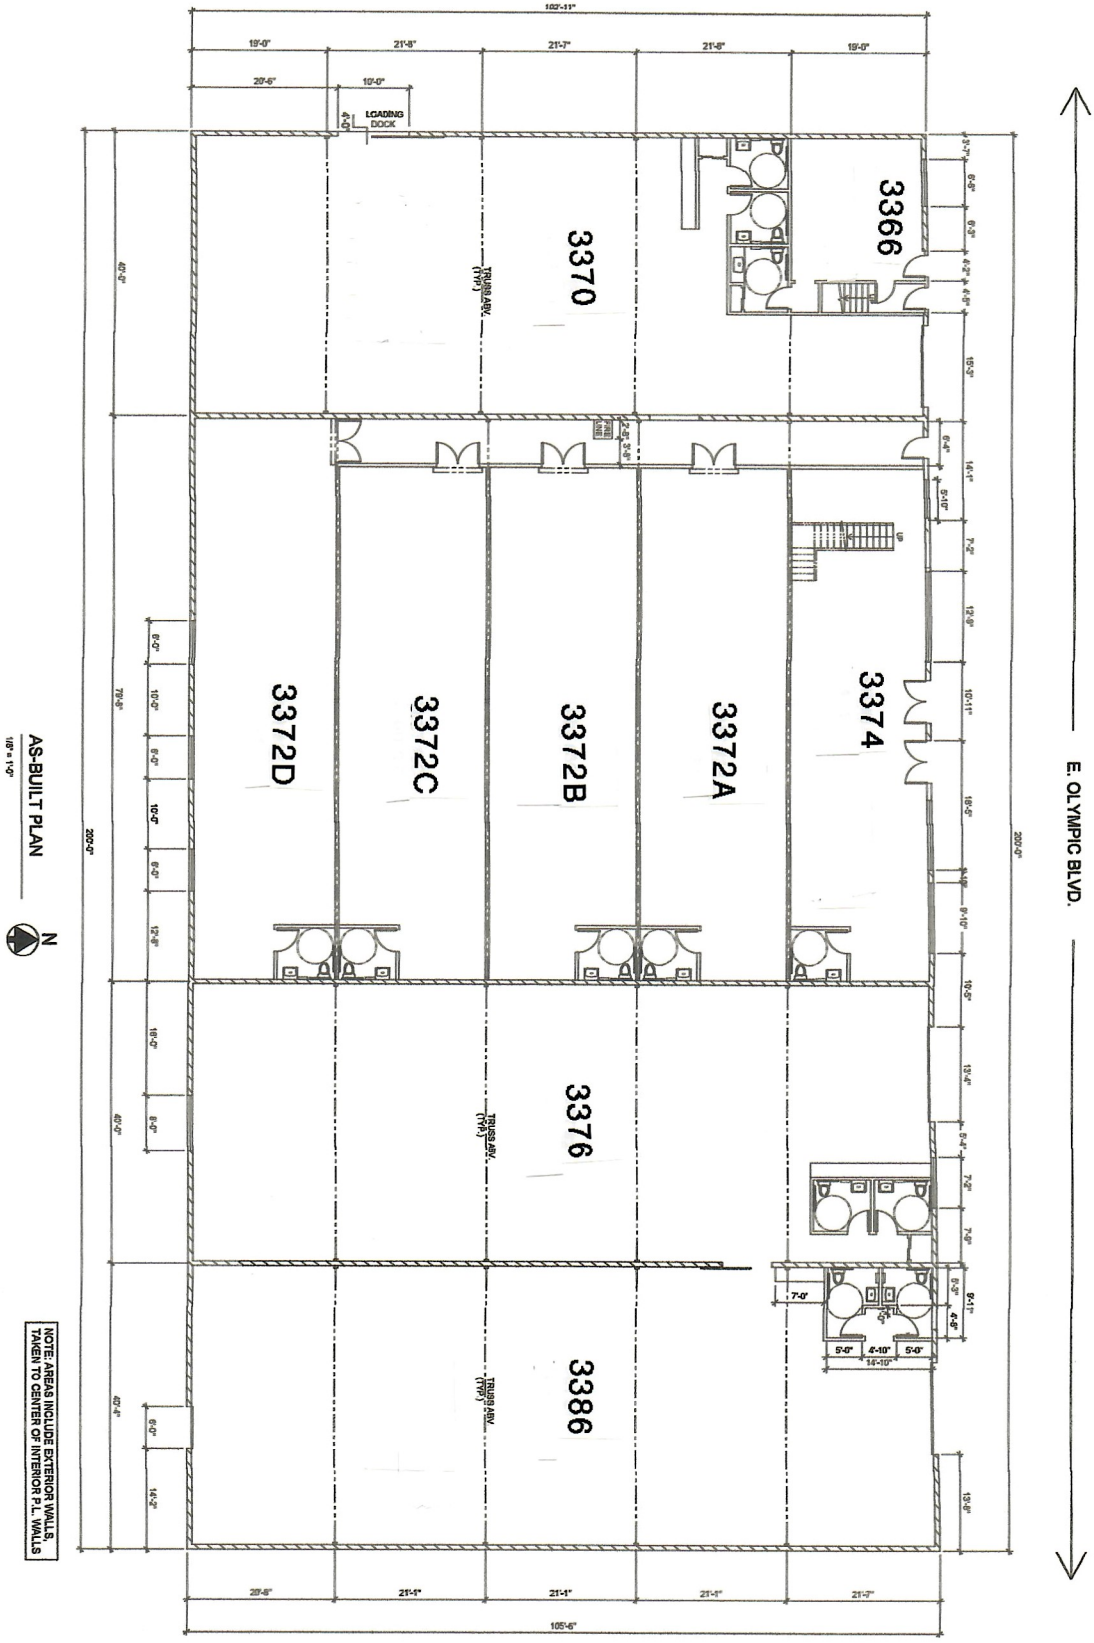

AS-BUILT PLAN
1/8" = 1'-0"

NOTE: AREAS INCLUDE EXTERIOR WALLS, TAKEN TO CENTER OF INTERIOR P.L. WALLS

AS-BUILT FLOOR PLAN
3364-3386 E. OLYMPIC BLVD.
LOS ANGELES, CALIF.

A-1
9/15/20

AS-BUILT PLAN

BUILDING DESIGN SERVICES
STEPHEN BACCHETTI
13129 ROSE AVE.
LOS ANGELES, CAL. 90066
(310) 391-4020