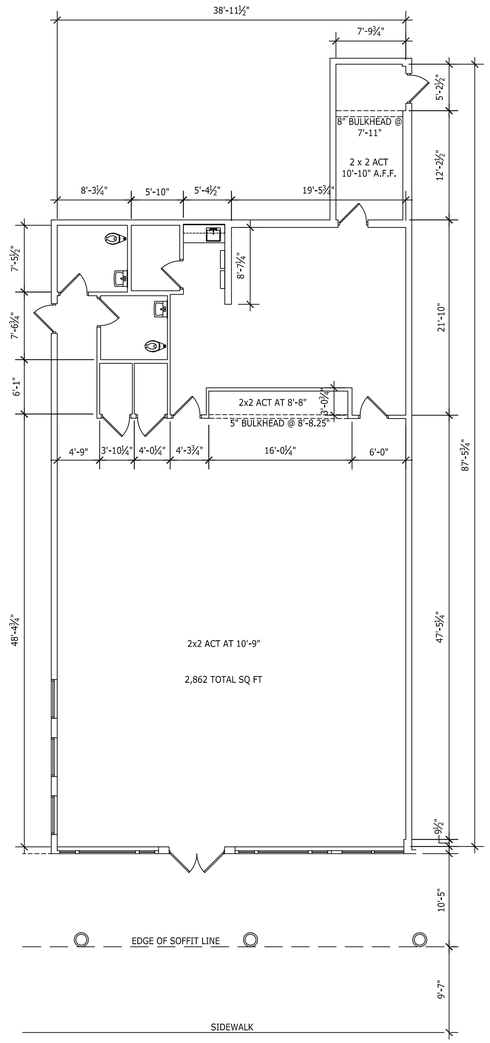

1A
A101

KID SHOP AS-BUILT PLAN

scale: 1/8" = 1'-0"

N

hdesigngroup
architecture + design

5039 S National Avenue I Springfield, MO 65810 I 417.887.6595

OWNER

LEE COWDEN

.

PROJECT TEAM

MEP ENGINEER
CJD ENGINEERING, LLC
2225 WEST CHESTERFIELD STREET, SUITE 200
SPRINGFIELD, MO 65807
417.877.1700

STRUCTURAL ENGINEER
METTEMEYER ENGINEERING, LLC
2225 WEST CHESTERFIELD STREET #300
SPRINGFIELD, MO 65807
417.890.8002

PROFESSIONAL SEAL

BRENT M. STEVENS, AIA - Architect
KENTUCKY #8822

REVISIONS

NO.	DESCRIPTION	DATE

© **2026** H DESIGN GROUP, LLC

THIS DRAWING AND THE ARCHITECTURAL WORK REPRESENTED ARE OWNED BY H DESIGN GROUP, LLC. COPYRIGHT INCLUDES THIS DRAWING, AS WELL AS, ALL COMPONENTS OF THE CONCEPTUAL DESIGN. REPRODUCTION OF ANY KIND IS STRICTLY PROHIBITED WITHOUT THE EXPRESSED WRITTEN CONSENT OF H DESIGN GROUP, LLC.

PROJECT TITLE
KID'S SHOP - AS-BUILTS

PROJECT ADDRESS:
2660 FREDERICA ST.,
OWENSBORO, KY 42301

PROJECT NO.: 26-020
DRAWN BY: PCB
REVIEWED BY: BMS
DATE: 03-24-2026

SHEET
A101