DEPT OF BLDGS 320153720 Job Number

ES643432795 Scan Code

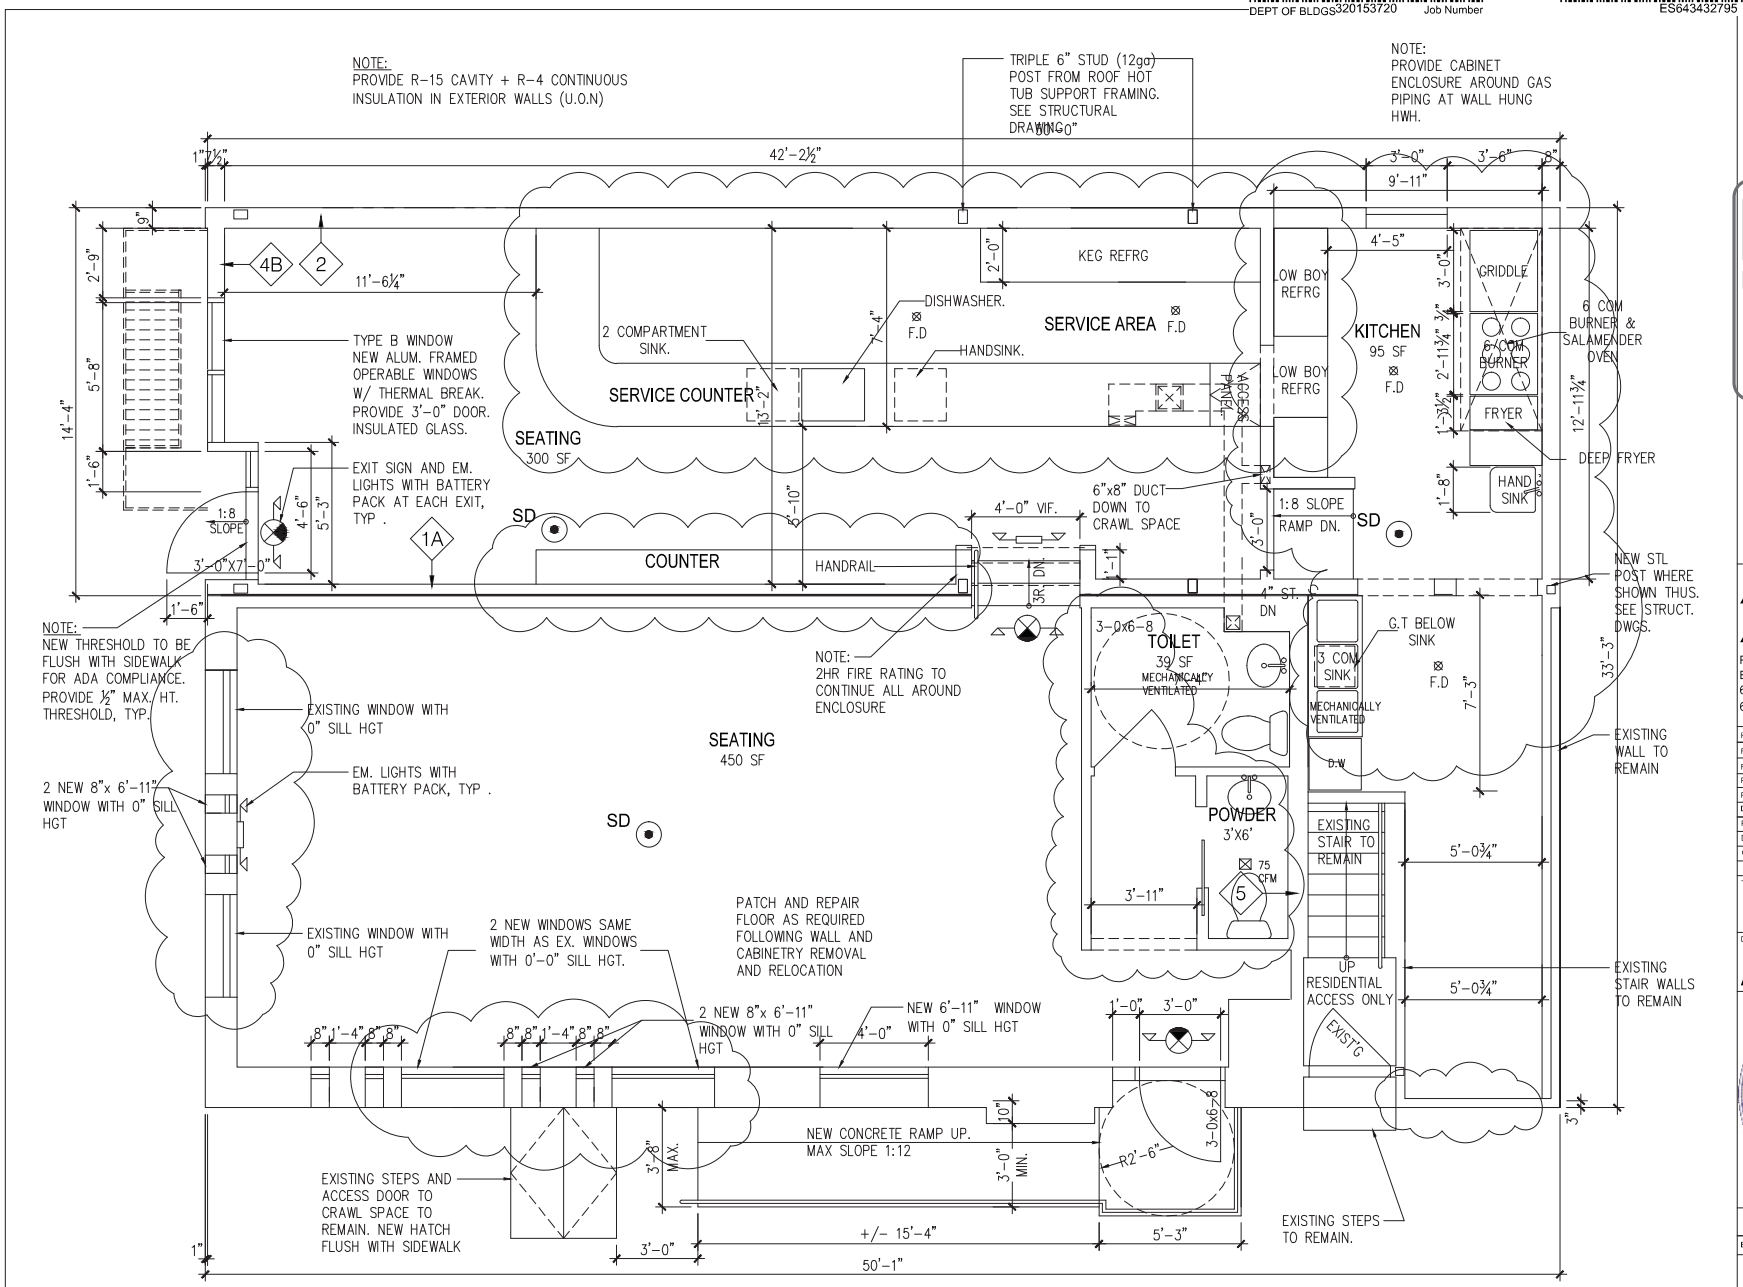

GRAPHIC LEGEND

- EXISTING WALL
- NEW CONCRETE WALL
- NEW METAL STUD WALL
- NEW SPRINKLER HEAD

NYC Buildings

Rudolf Govic
APPROVED
Date: 07/18/2022

Muchmore Residence

2 Havemeyer Street
(Williamsburg)
Brooklyn, New York 11211

AMOIA CODY ARCHITECTS
PO BOX 1242
BRIDGEHAMPTON, NEW YORK 11932
631.355.1328
631 614 4356 F info@amoiacody.com

REV: NO. 4	02/05/2020	INSPECTION COMMENT
REV: NO. 3	06/03/2014	AS-BUILT CONDITIONS
REV: NO. 2	08/08/2013	SPRINKLER
REV: NO. 1	03/11/2013	CHANGES FOR AUDIT
REV: NO. 0	08/30/2011	FIRST PAA

DATE:	12/22/2010
PROJECT NO:	2009-18
DRAWN BY:	RC
CHK BY:	AA
SCALE:	AS NOTED 1/4"

TITLE: FIRST FLOOR PLAN

DWG NO: A-101.04

REGISTERED ARCHITECT ROBERT CODY 029903 STATE OF NEW YORK

BSCAN BELOW