


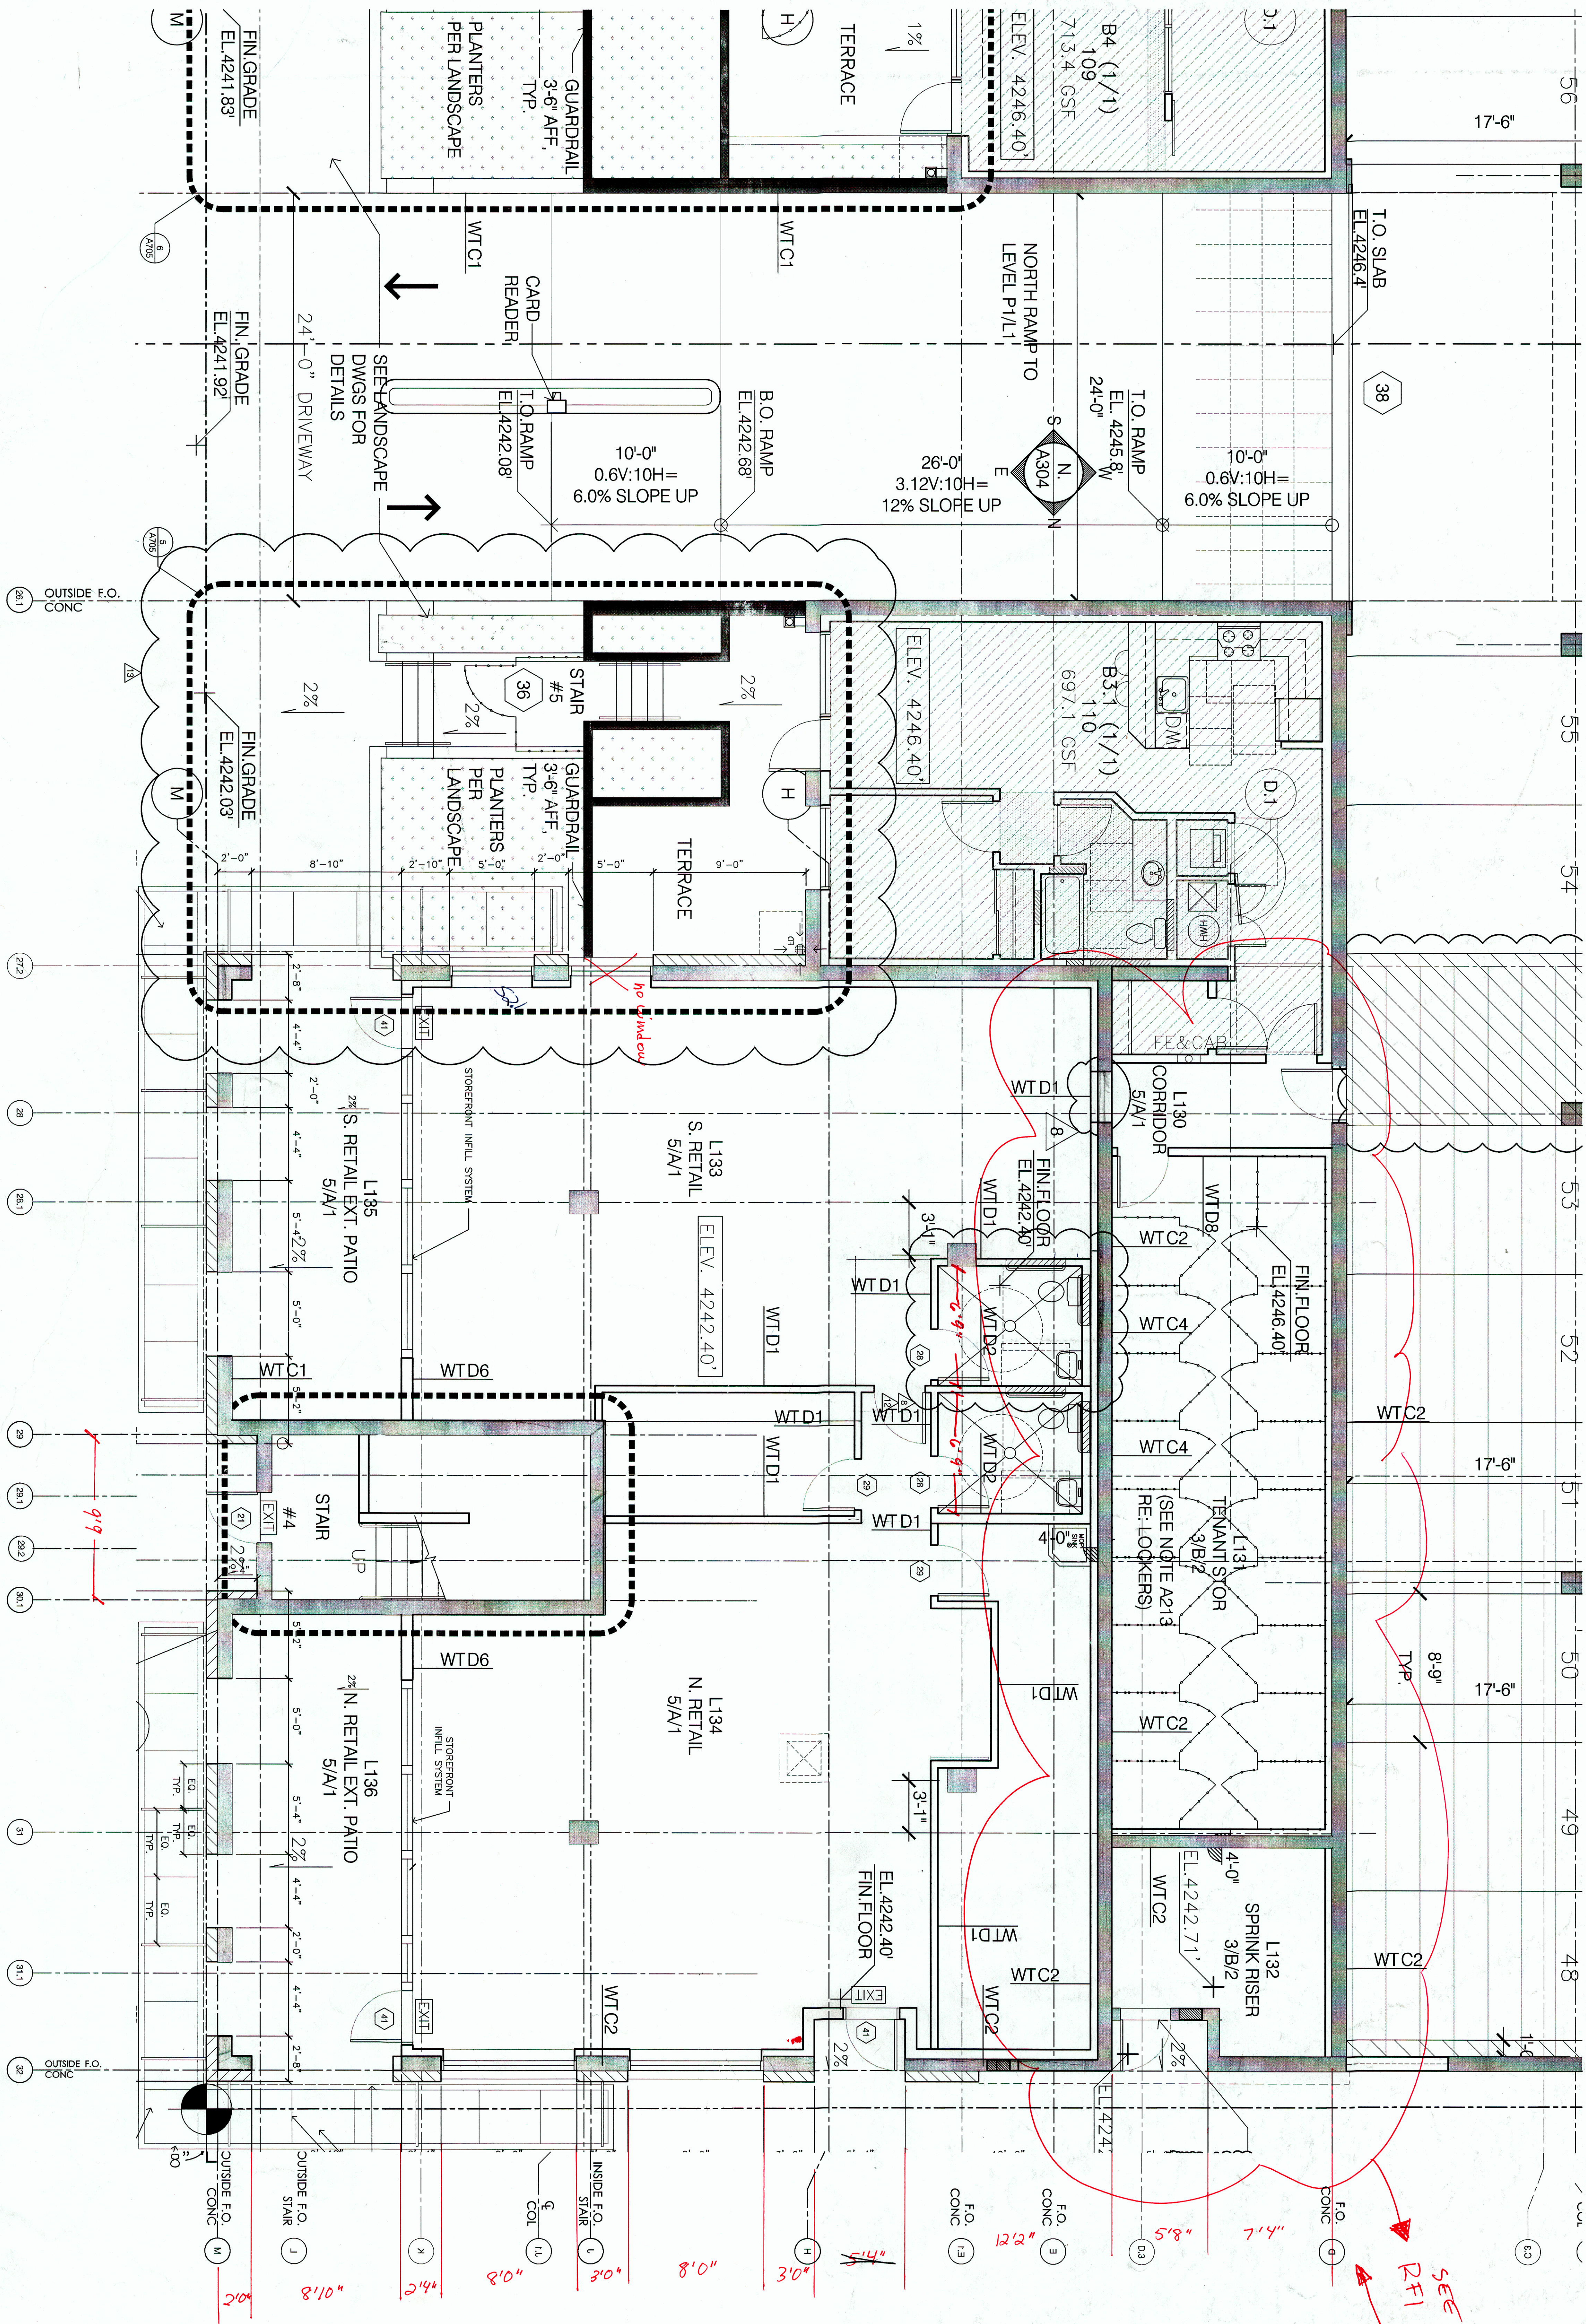

FINISH SCHEDULE


PLAN INDICATION

FLOOR WALL CEILING


NO PAD @ PUBLIC AREAS WITH CARPET. SEE SPEC.

Plan: RETAIL SPACE

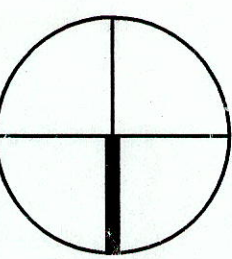

1/4" = 1'-0"

0 2 4 8

PLAN: LEVEL P1/L1 (NORTH)

For Consultant Use
11/15/2011

LIBERTY GATEWAY

APARTMENTS
50 SOUTH 500 WEST
Salt Lake City, UT
LIBERTY GATEWAY PARTNERS, LLC

PERMIT:	COMMENTS:
10/22/2008	CHECK SET
02/06/2009	BID SET
04/08/2009	BID SET
08/13/2009	PERMIT CORRECTIONS
10/18/2009	PERMIT CORRECTIONS
05/19/2011	PERMIT RESUBMITTAL

PERMIT:	COMMENTS:
09/30/2011	HUD REDLINE RESUBMITTAL
11/09/2011	RESUBMITTAL
11/21/2011	CORRECTIONS
12/20/2011	ELEV LOBBY
12/30/2011	HUD FINAL
02/10/2012	FINAL HUD FINAL
05/xx/2012	XXXXX

©2012 d/Arch, Inc.



d/Arch, Inc.
1335 N. Northlake Way, Ste 102
Seattle, WA 98103
p/ 206.547.1761 f/ 206.547.1762
www.dArchLlc.com

A227