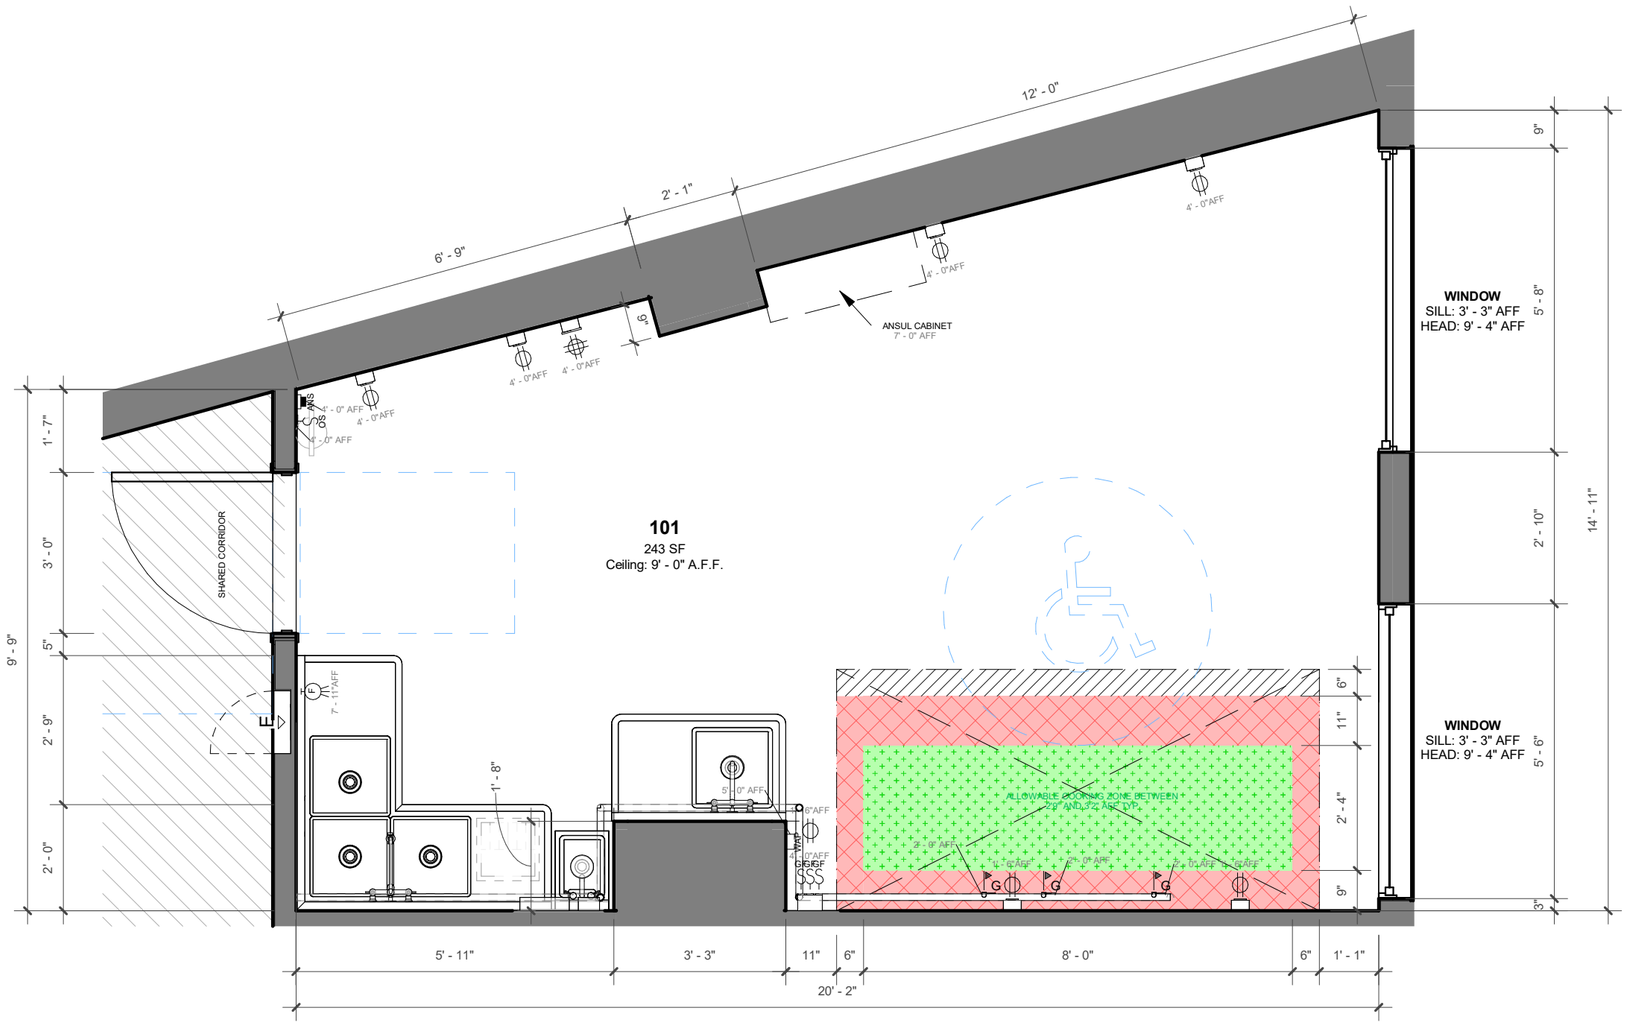

1 **101-KITCHEN** 3/8" = 1'-0"

GENERAL NOTES:

1. MINOR VARIATIONS MAY EXIST IN FINAL BUILT CONDITION.
2. DEVICES, AND CONNECTIONS ARE SHOWN IN APPROXIMATE LOCATIONS.
3. ANSUL SYSTEM AND MECHANICAL HOOD IS EXISTING TO REMAIN PER ORIGINAL FACILITY PERMIT DRAWINGS.
4. ALL UTILITIES ARE EXISTING UNLESS OTHERWISE NOTED.
5. EXISTING PLUMBING AND SINKS ARE TO REMAIN PER ORIGINAL FACILITY PERMIT DRAWINGS UNLESS OTHERWISE NOTED.
6. ALL EQUIPMENT SHALL DRAIN TO EXISTING FLOOR SINKS IN A MANNER THAT IS COMPLIANT WITH LOCAL REGULATIONS AND CODES
7. ALL FINISHES ARE EXISTING TO REMAIN.
8. SPLASH GUARDS TO BE INSTALLED AS REQUIRED TO BE IN COMPLIANCE WITH ALL LOCAL REGULATIONS AND BUILDING CODES, TYP.

KITCHEN OUTLINE DRAWING

KEY PLAN:

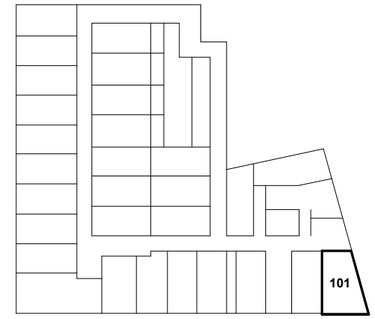

	Coverage Zone		ADA Door Clearance
	Modification Review Req'd		Unverified in Field
	No Coverage Zone	E	Electrical Panel
	Duplex Outlet	ANS	Ansul Pull
	Quad Outlet	F	Fire Alarm Pull
HV	High-Voltage Outlet	F	Fire Strobe
J	Junction Box (Blank Plate)		Fire Extinguisher
DO	Duplex Outlet (Ceiling)	BMS	BMS Sensor
LS	Light Switch		Data Port
GFCI	GFCI Power Switch	WAP	Wireless Access Point with Data Port
	Floor Sink		Floor Drain
G	Gas Connection	G	Gas Connection w Tee
DW	Water Line - Domestic	HW	Water Line - Hot Water
CMC	Ceiling Mounted Camera	WMC	Wall Mounted Camera
	AFF = Above Finish Floor		RR = Runner Rack

REVISION HISTORY:

△	DESCRIPTION	DATE
2	PRE-CON PLAN	08/03/2021
3	UPDATE TO V4 GRAPHICS	02/17/2022
4	AS-BUILT r0	8/26/2022
5	AS-BUILT r1	1/24/2024

DRAWN BY: JWD **CHECKED BY:** -

KITCHEN (101)

94 Shirley St, Boston, MA

K-101

1/24/2024 1:46:43 PM