COLUMBIA CORPORATE PARK

8850 STANFORD BLVD. COLUMBIA, MD 21045

SUITE 2100

TOTAL SF AVAILABLE - 5,041 RSF (16%)

Click to access **CADD file**

Key Plan

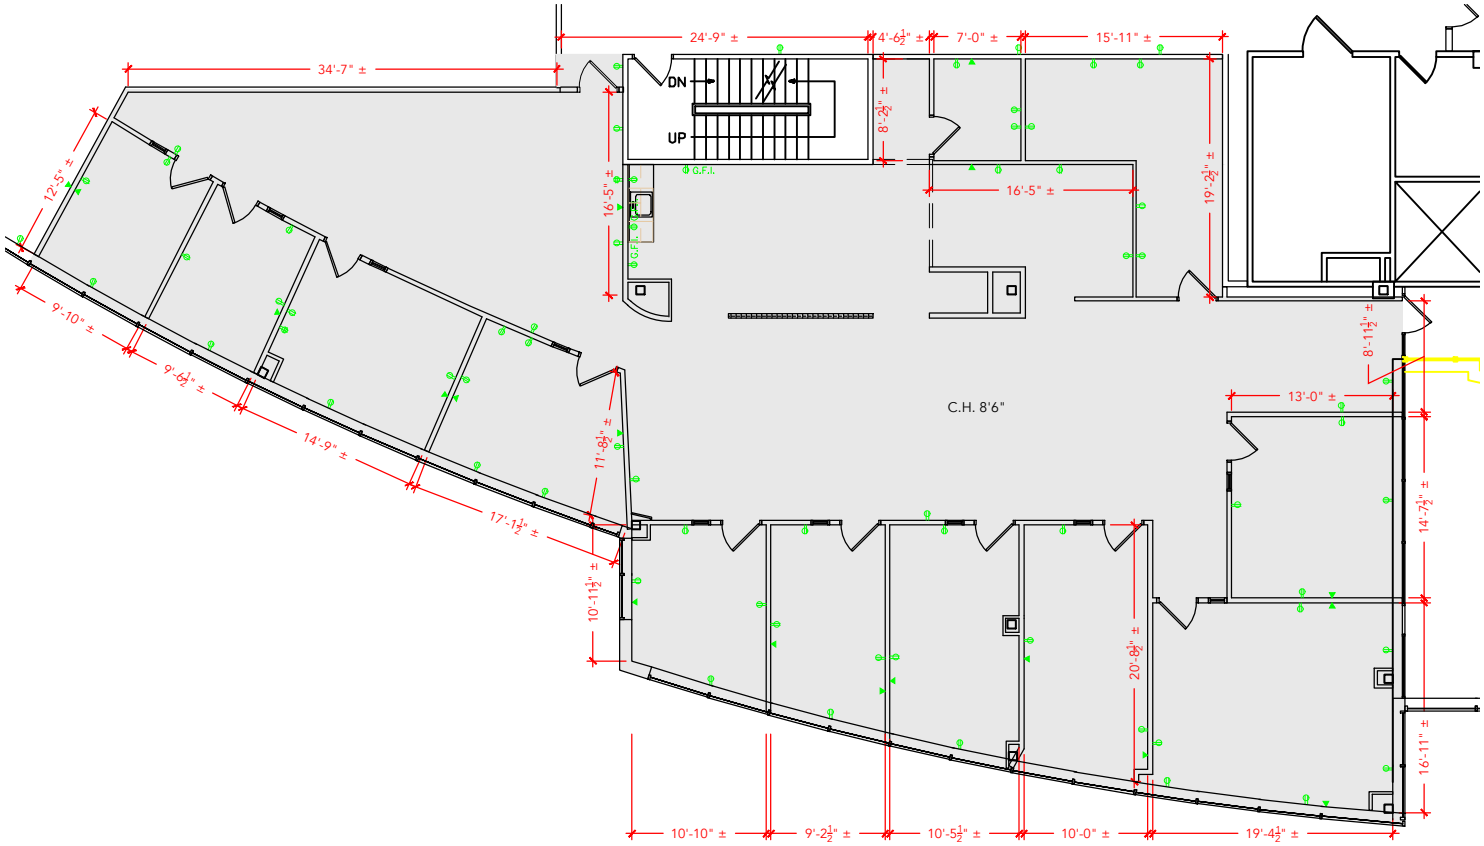

Floor Plan

PLAN NOT TO SCALE - THIS IS NOT A CONSTRUCTION DOCUMENT

DRAWING #: ZA1-2100 ASBUILT DATE: **NEEDS TO BE**